
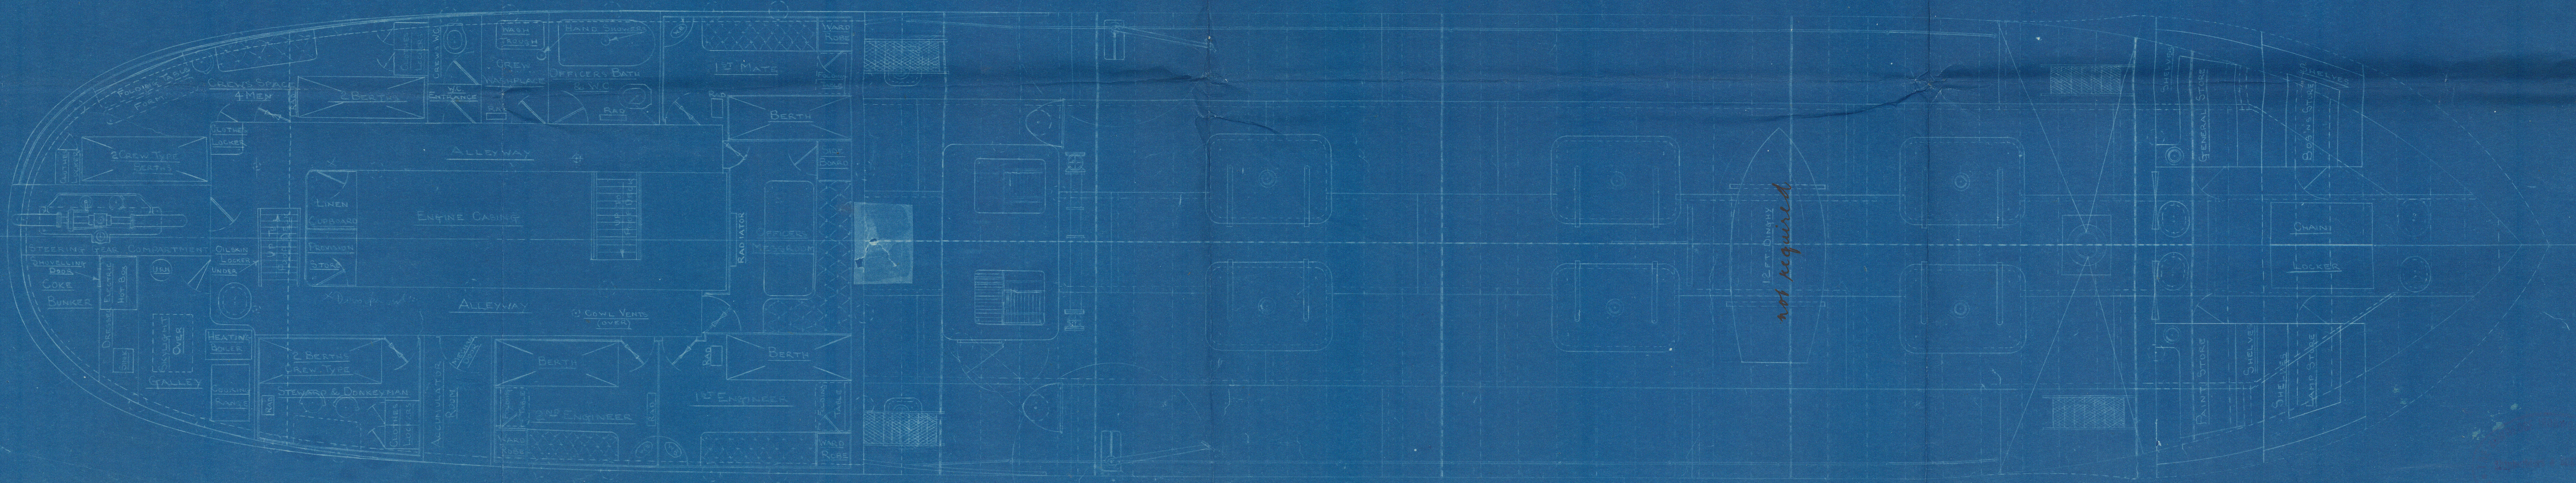
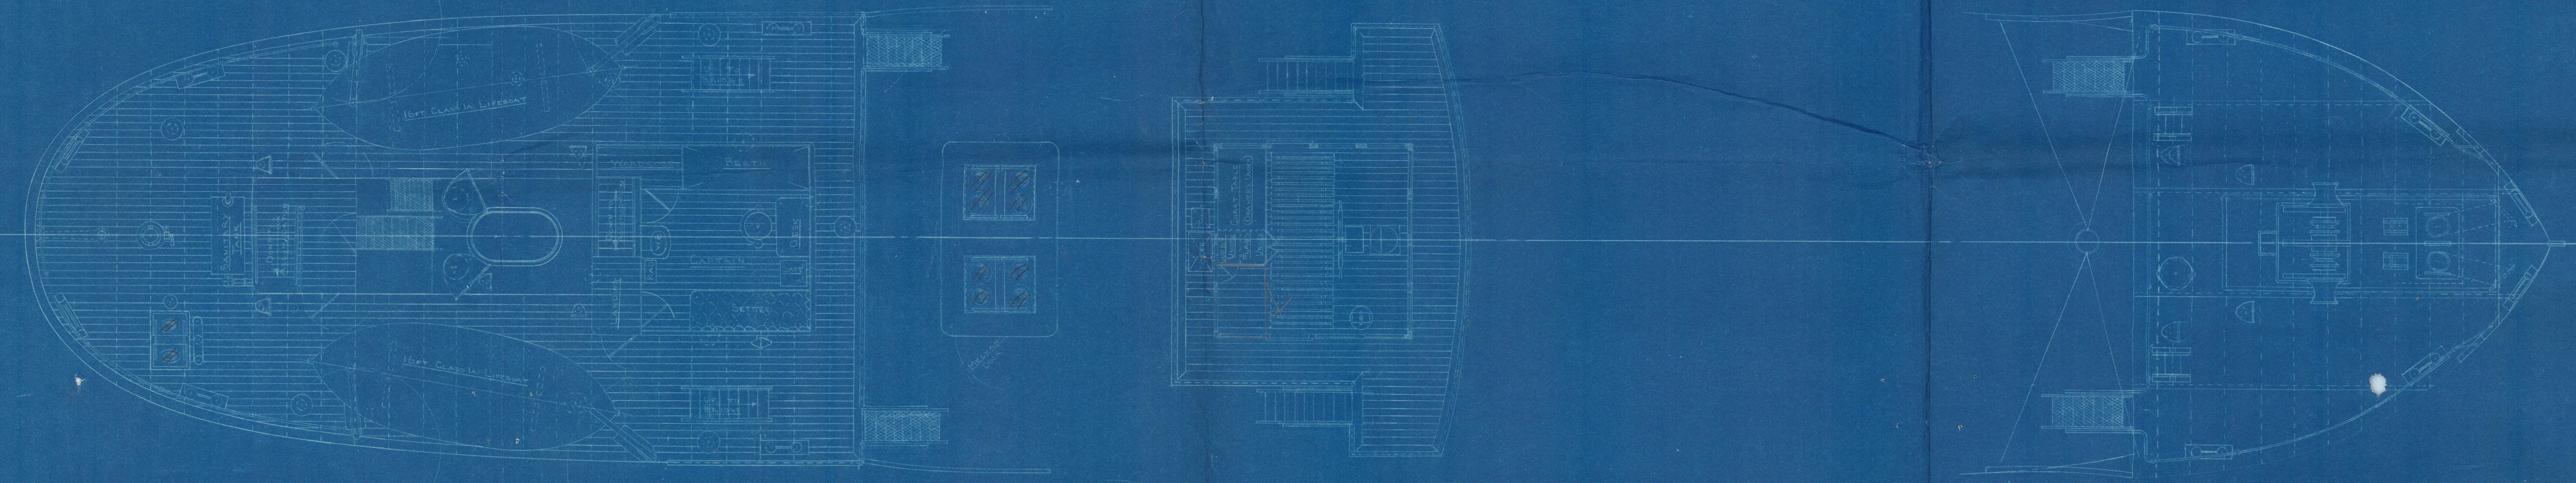


50/  
5585

GENERAL ARRANGEMENT *to Red*

SCALE 1/4" = 1 FT.

DIMENSIONS: 132'-6" O.A. x 24'-0" M.L.D. x 10'-9" M.O.

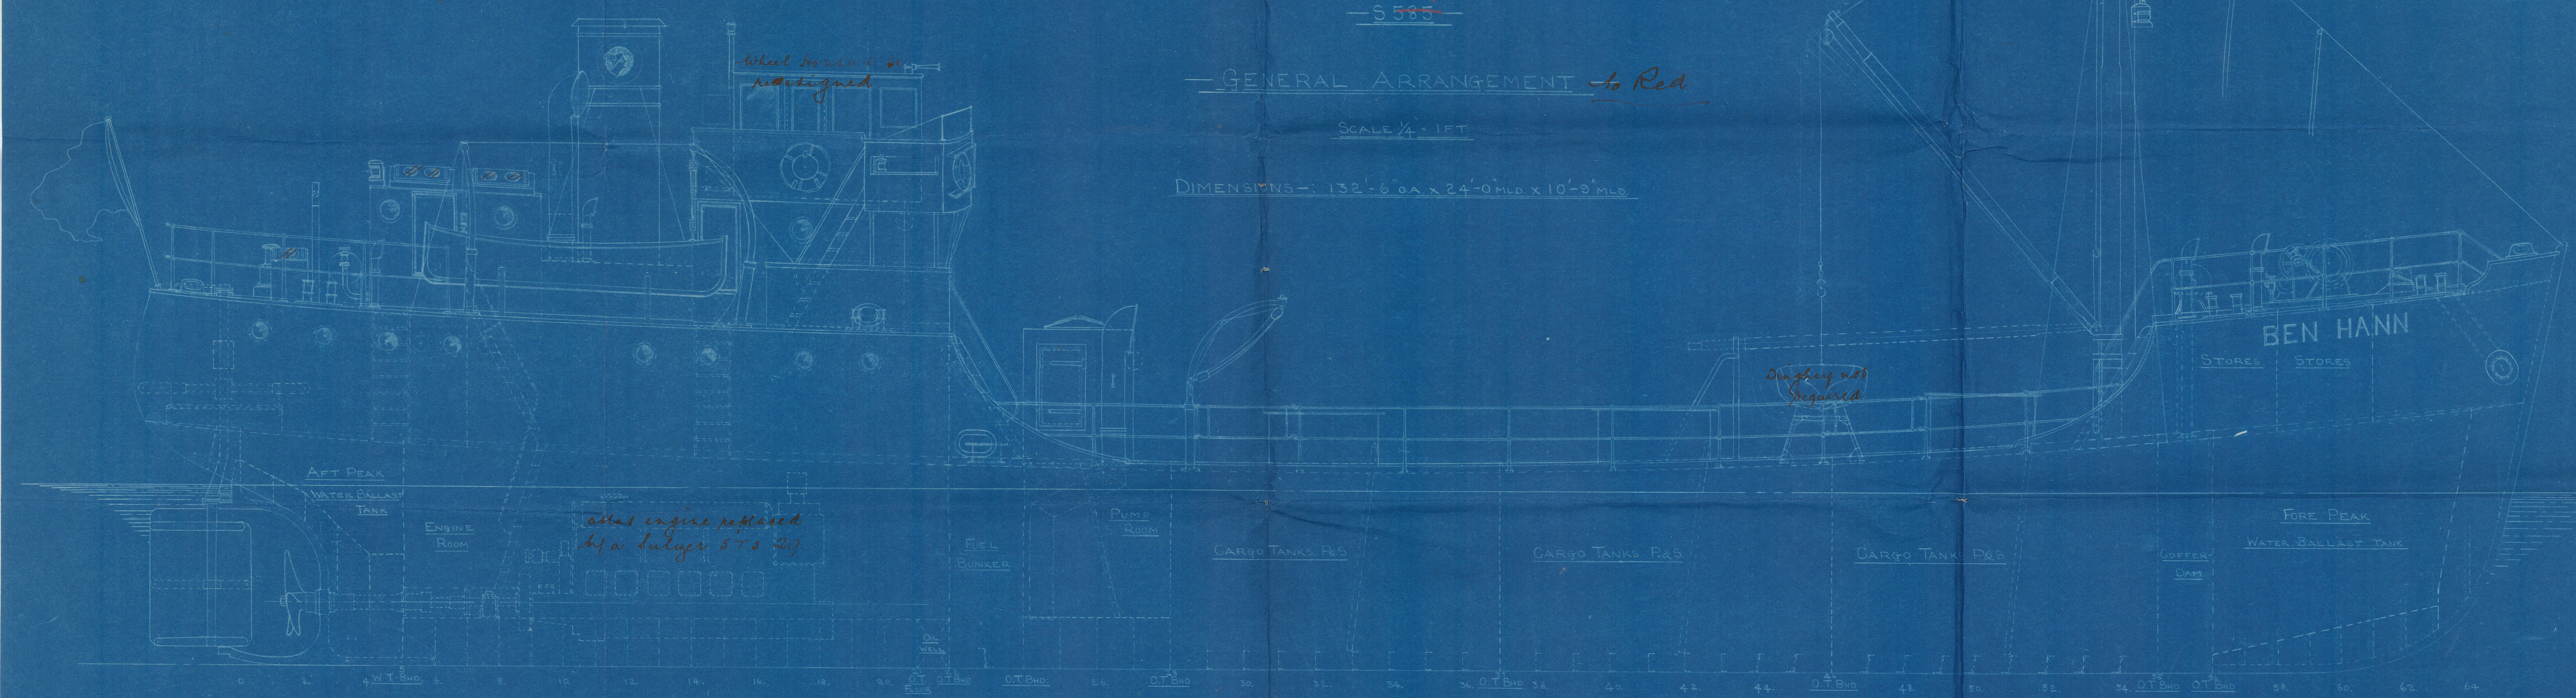

TRACING No 6036

DRAWERS  
4/9/35

012542-012608-000







ROWHEDGE IRONWORKS CO. LTD


GENERAL ARRANGEMENT (DATED 11/6/40)

TANKER 132' 6" D.A. x 24' M. x 10' 9" M.


601

MO 5145

Boo14513

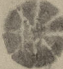m/v Empire Lad 

London Report No. 110,020

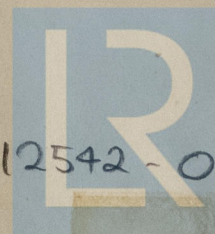

© 2021

Lloyd's Register  
Foundation