

DAIDO KAIUN KOHO MARU
CONSTRUCTION PROFILE AND DECK PLAN SHEET I (FINISHED PLAN)
DIMENSION 1400 x 194 x 122
SCALE 1/100 CLASS H.R.
HULL DESIGNING SECTION SHIP DESIGNING DEPARTMENT NABESAWA
CHIEF HEAD CHECKED DRAWN
DATE MITSUBISHI ZOSEN KAWASAKI KANSAI YOKOHAMA
SHIP NO H-2074

RECORDS DEPT.
LONDON.

5

SHIMONOSEKI

RPT. NO. FE 795


DATED. _____

' KOHOH MARU ' ★

Construction Profile & deck

(Sheet 1)

Certified in accordance with App Plan

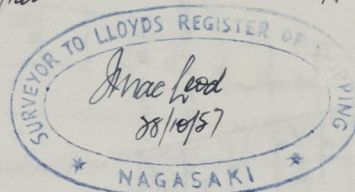

© 2021

T. Okabe

Lloyd's Register
Foundation

012542-012548-0177