

DAIDO KAIUN
KOHOH MARU.

CONSTRUCTION PROFILE
AND
DECK PLAN
SHEET II
(FINISHED PLAN)

VISION 1400x194x122

SCALE 1/100 CLASS H.R.

HULL DESIGNING SECTION

SHIP DESIGNING DEPARTMENT

NAGASAKI SHIPYARD

CHIEF OF DEPT. *T. Ohtsuka*

HEAD *T. Ohtsuka*

CHECKED *T. Ohtsuka*

DRAWN *T. Ohtsuka*

DATE 1949.7

SHIP NO. 1497

DSN NO. H-207

019542-012542-0178

Lloyd's Register
Foundation

RECORDS DEPT.
LONDON.

7

SHIMONOSEKI

RPT. NO. FE 795


DATED. _____

"KOHOKU MARU"



Construction Profile & deck
(Sheet 2).

Certified in accordance with app plan

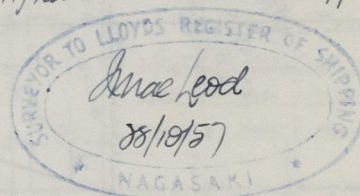

Lloyd's Register
Foundation

012542-012548-0178