

SHIMONOSEKI

RPT. NO. FE 795




DATED. _____

'KOHOKU MARU' ★

Stemfrance

Certified in accordance with App Plan

RECORDS DEPT.
LONDON.

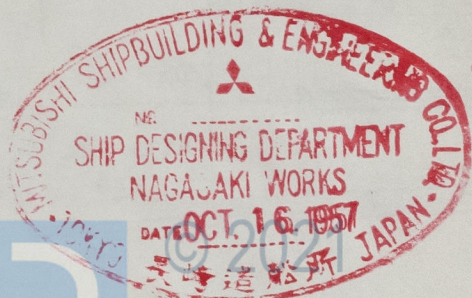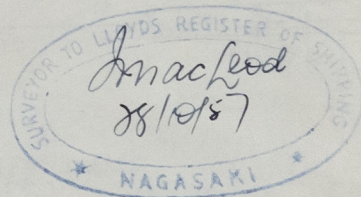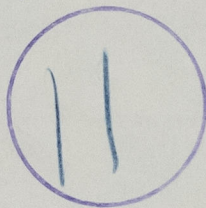

Lloyd's Register
Foundation

012542-012548-0179