

SHIMONOSEKI

RPT. NO. FE 795

DATED. _____


KOHON MARU ★

Rudder.

Certified in accordance with app. plan

RECORDS DEPT.
LONDON.

12

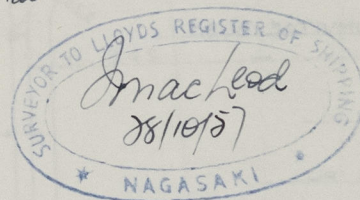

© 2021

Thatcher

Lloyd's Register
Foundation

012542-012548-0180