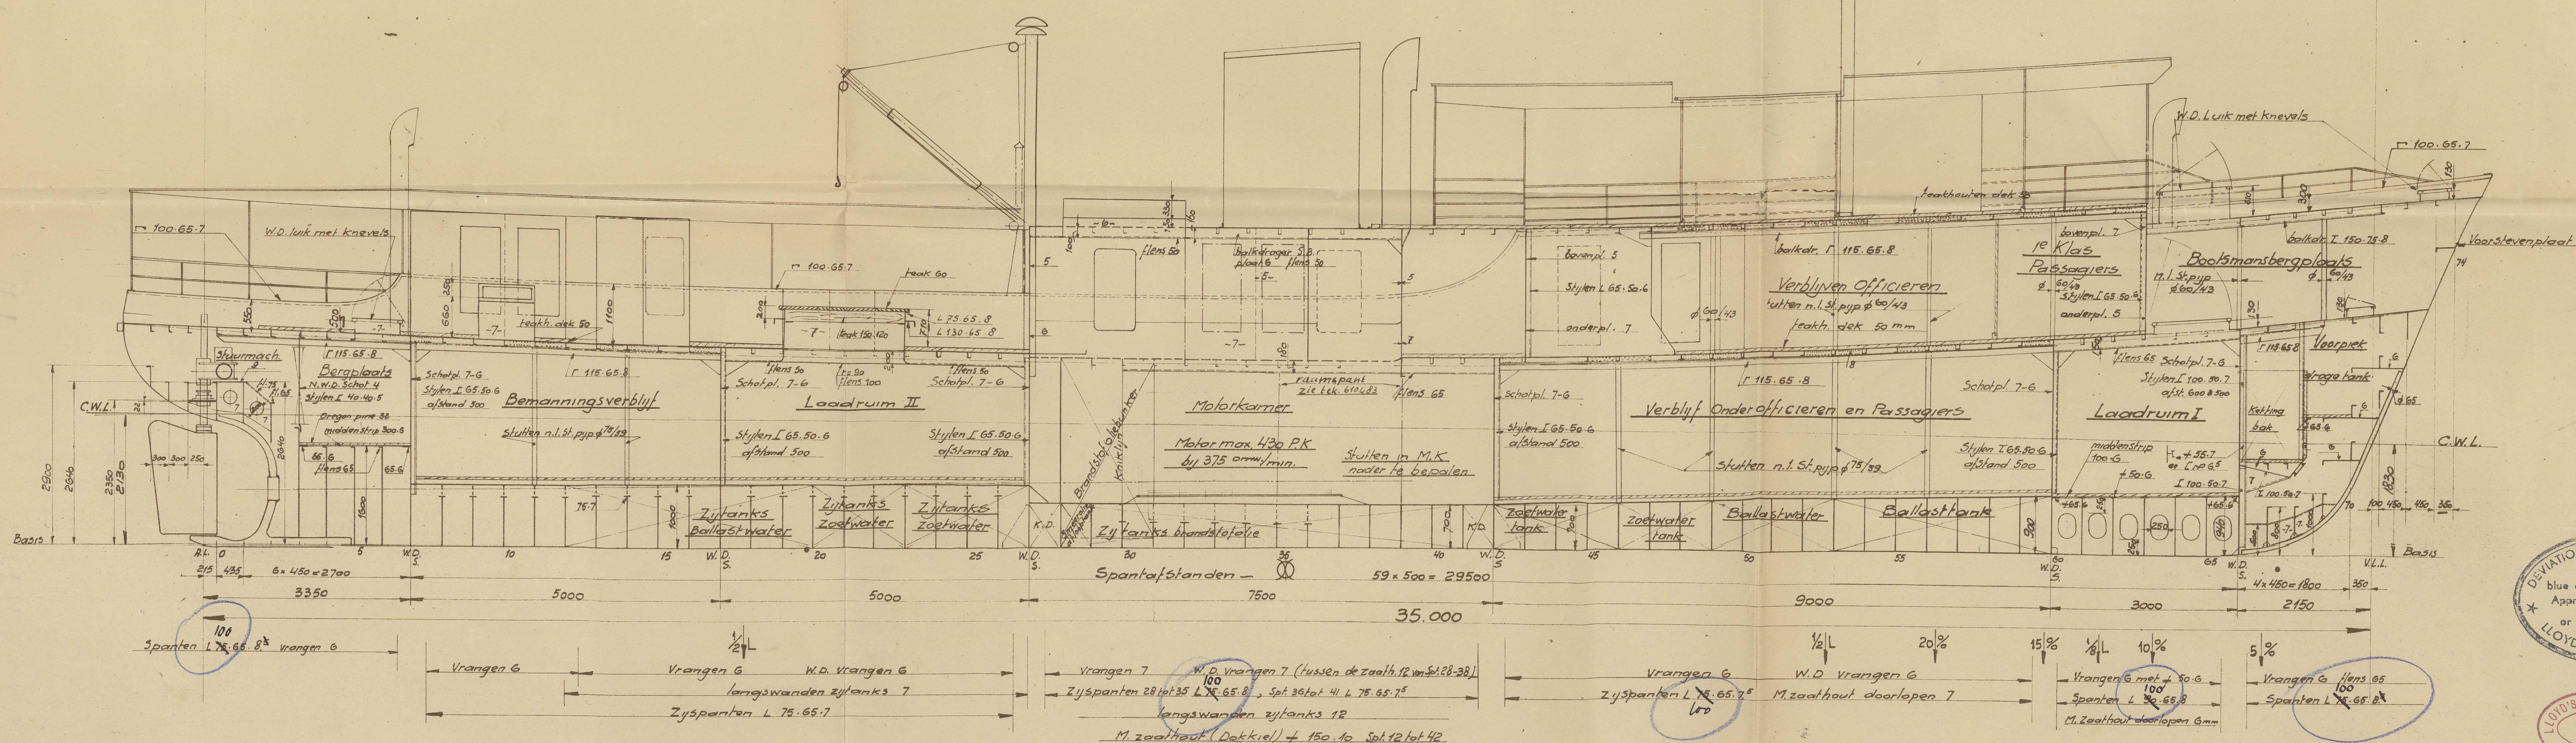
[illegible]

N.B. De afmetingen der Spanten zijn de minimum maten volgens Lloyds

"For Service in the Indonesian Archipelago"

## Hoofdafmetingen

Gemidd. diepg. maximaal (boven 200/15) 1.98 M = 6.54'

Equipment Number

$$\frac{114.83(30.99) + \frac{20.4 + 8.9}{0.305^2} = 3559 + \frac{29.9}{0.305^2} = 3559 + 324 = 3883 \text{ ft}^2$$

1-2" Flexible Staaldraad (6x12) lang 82,5 M

ms "BALAM" BELONGS TO ROTTERDAM REPORT No. 7

[illegible]



Construction plan.

RECORD PT.

2

Equipment Number

School 1:20

★ Balam









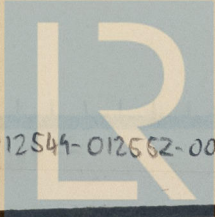

© 2021

Lloyd's Register Foundation