
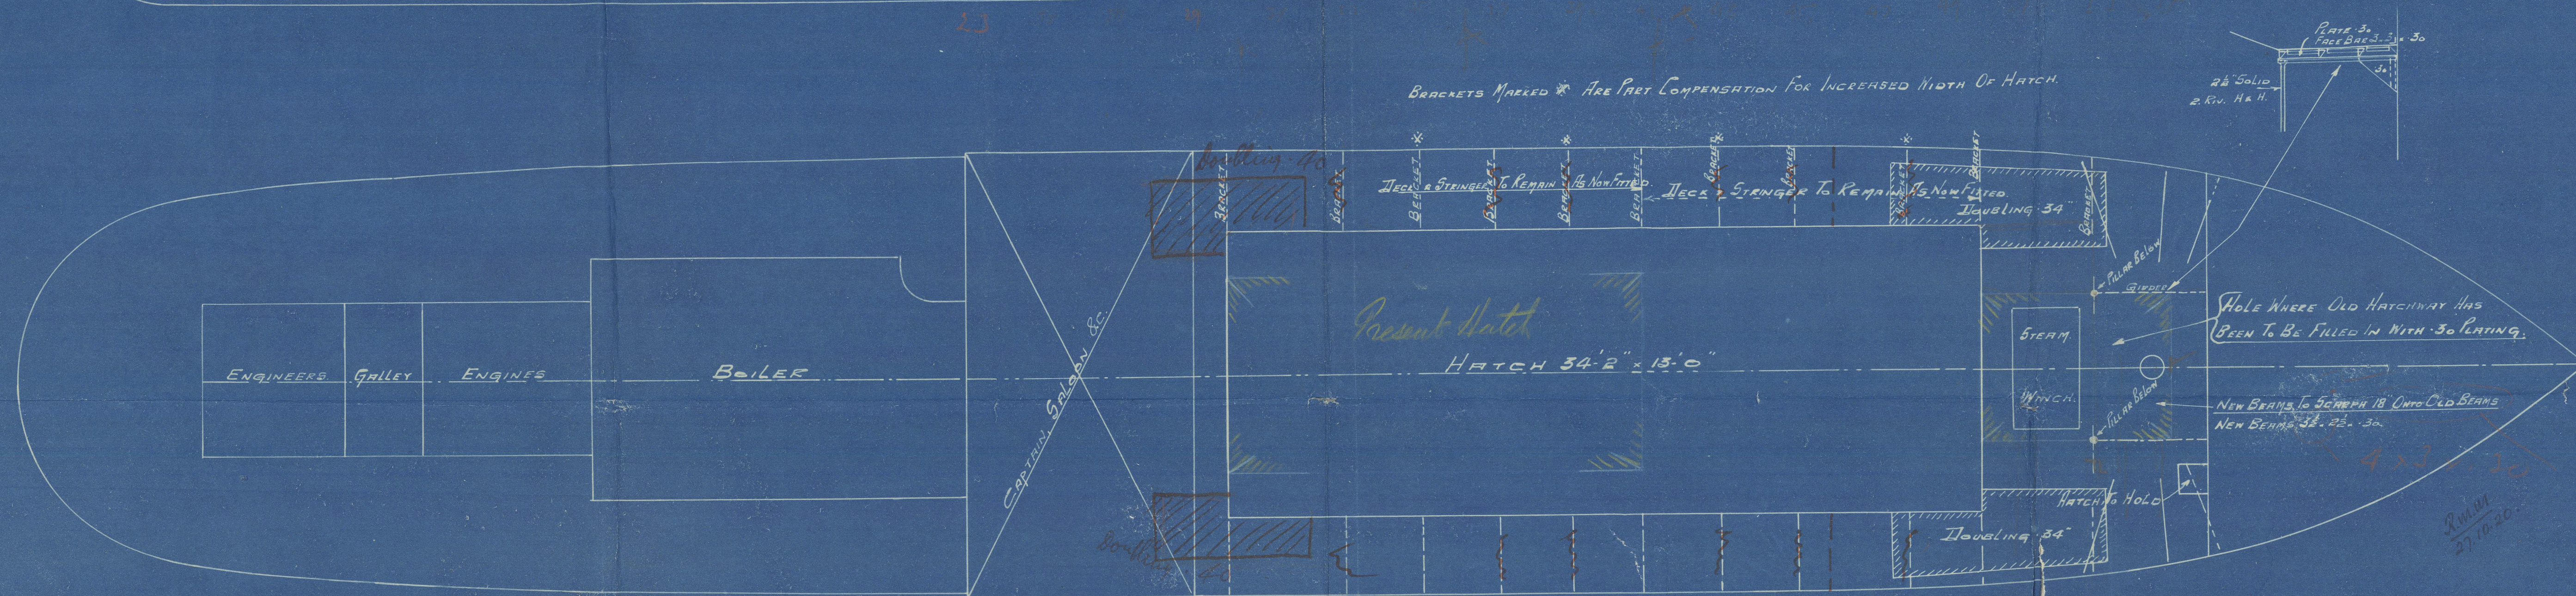


A.

S. S. "WILSON"

DIMENSIONS: 112'-0" x 20'-6" x 9'-6"

1/4" SCALE.

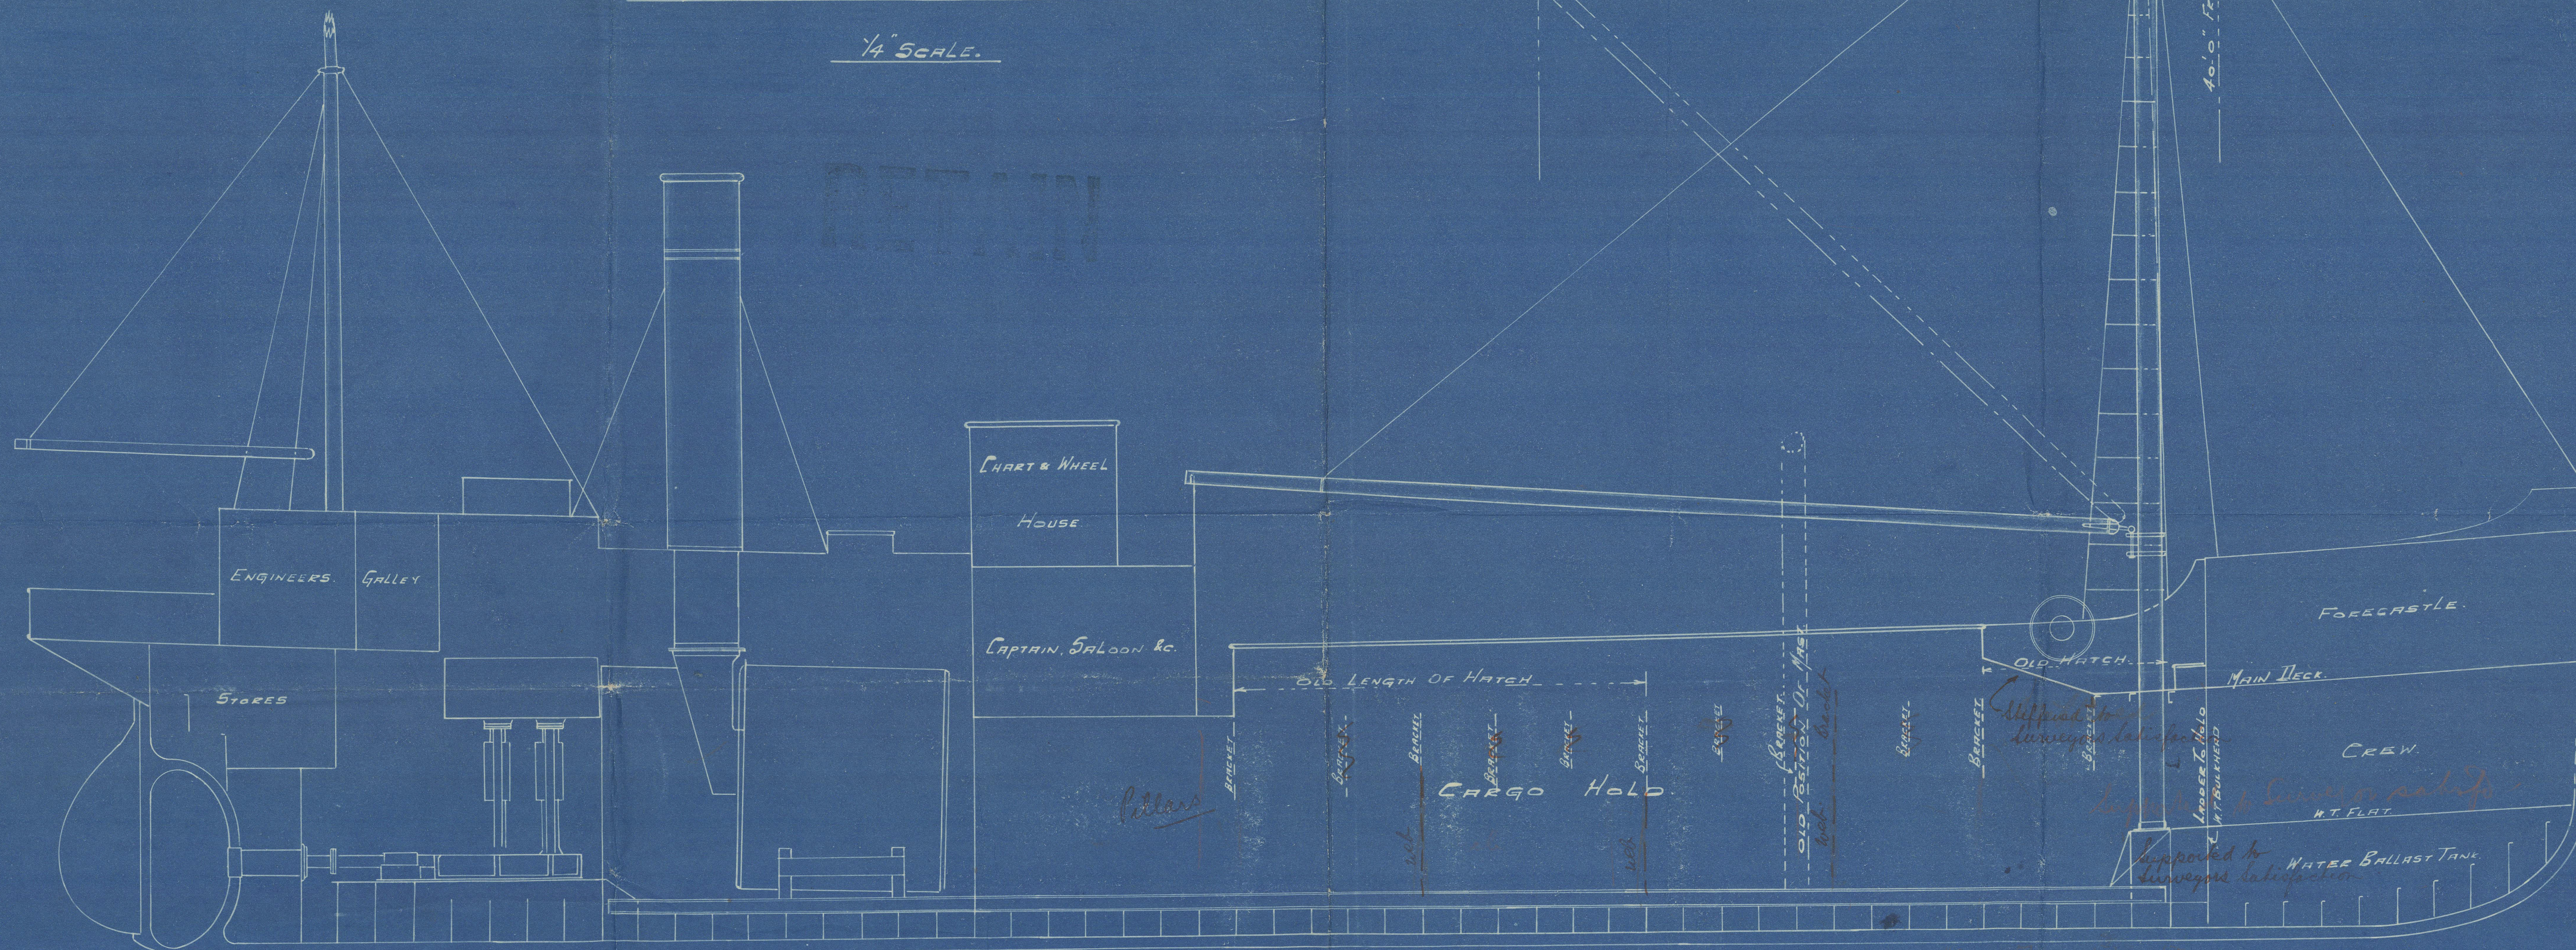

2 more braced fitted to this beam between girders.

012553-01556

J. J. Kennan
Lt. J. Wilson
~~Gen Box 3374~~

012553 - 012563 - 0187



© 2021

Lloyd's Register
Foundation