



S. S. WILSON.

SKETCH OF MIDSHIP SECTION SHOWING INCREASES PROPOSED
AS COMPENSATION FOR INCREASED WIDTH OF HATCH
1/2" SCALE.

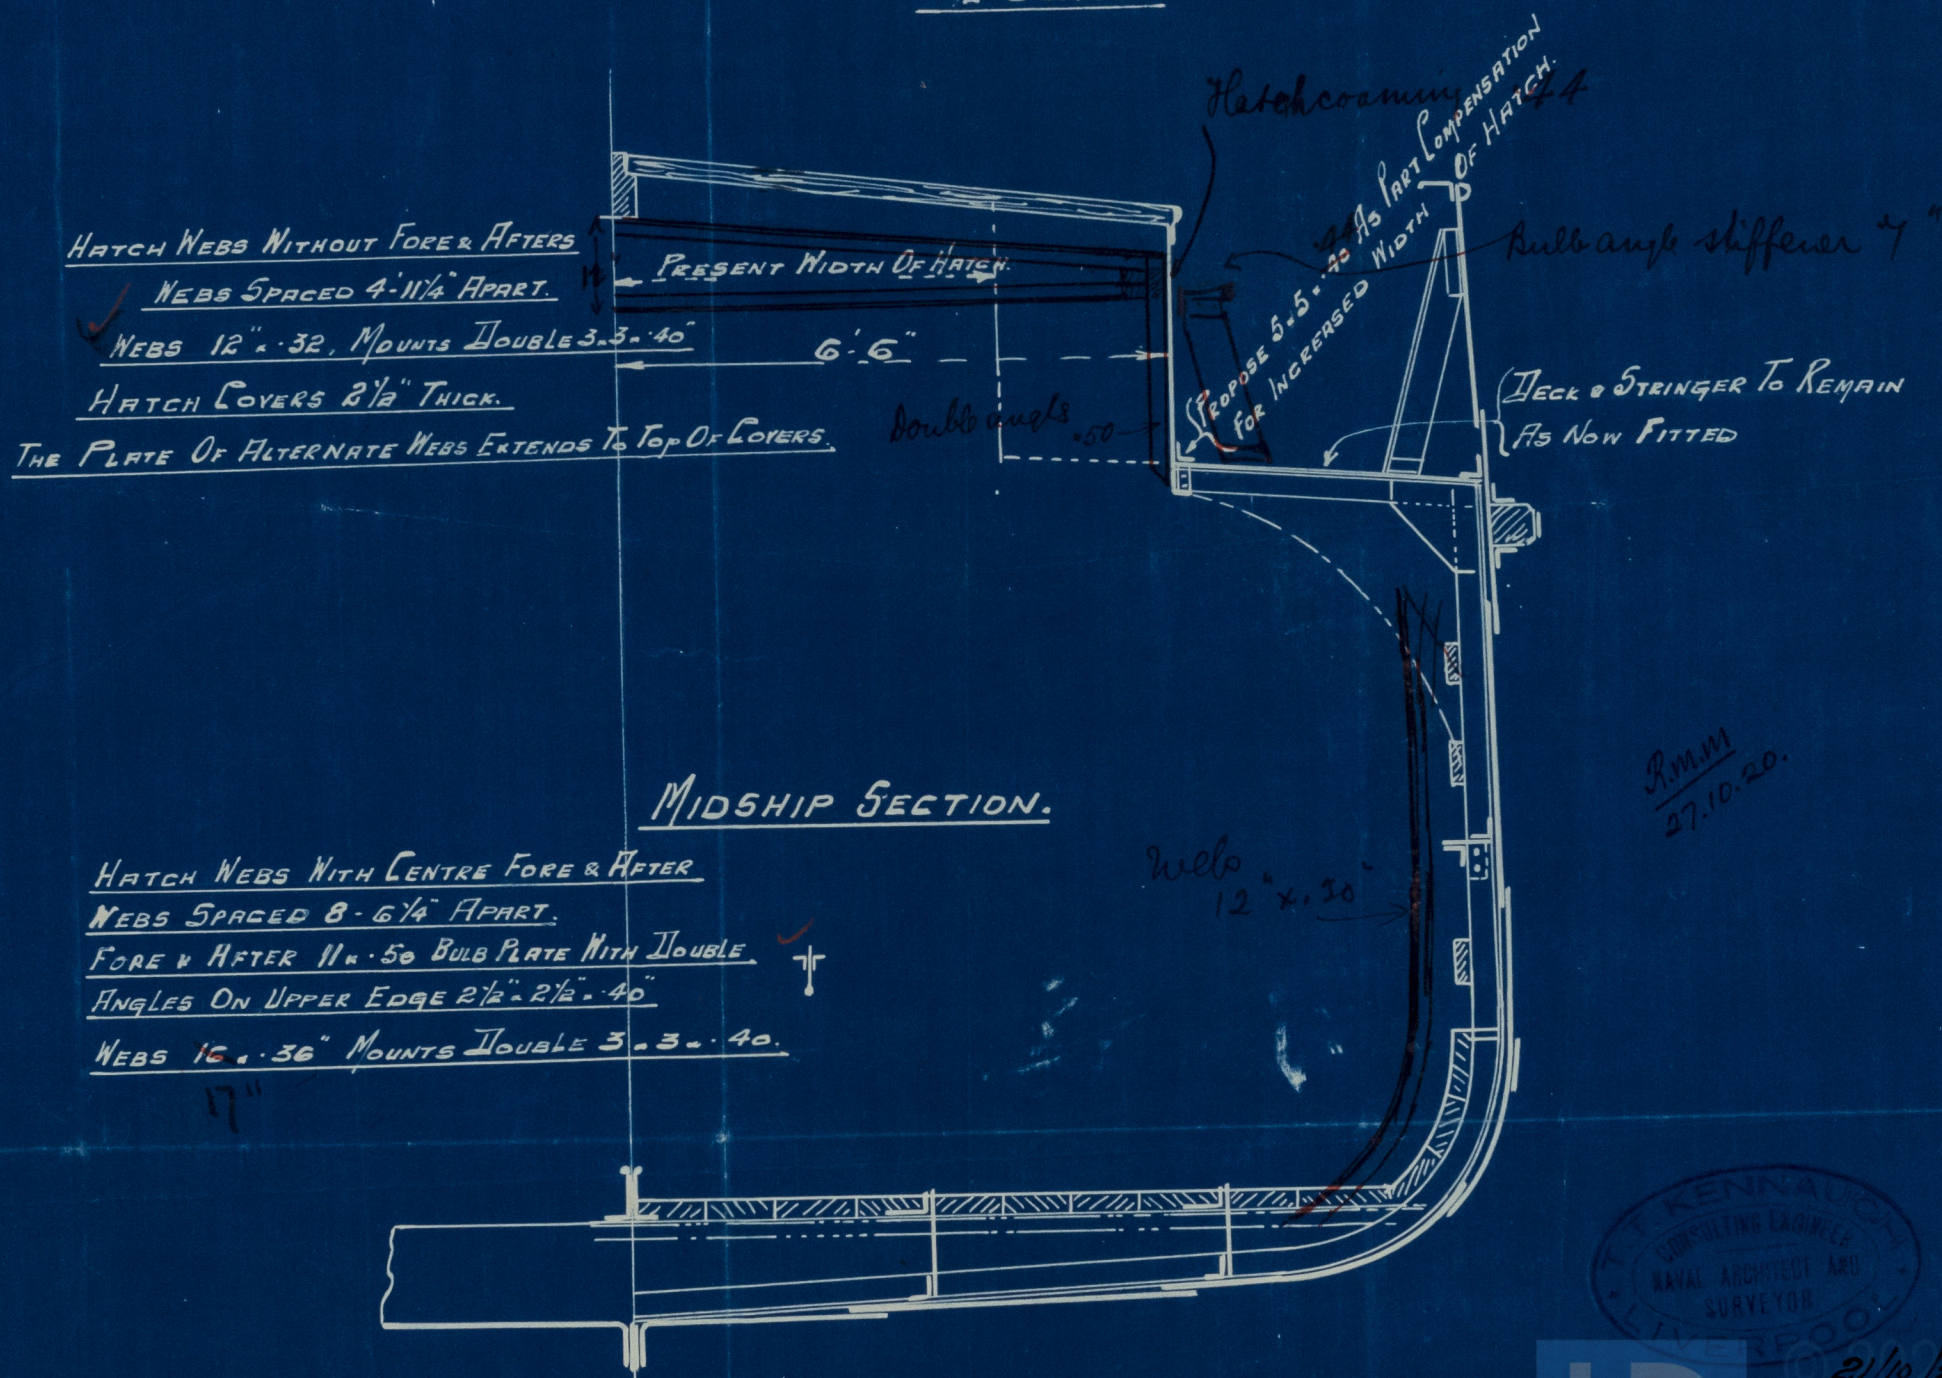

RMM
 27.10.20.

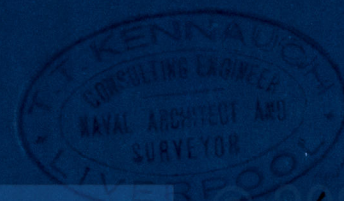

21/10/20

~~Sen. Box 3374.~~

RECEIVED

012553-012563-0188



© 2021

Lloyd's Register
Foundation