

MIDSHIP SECTION  
— S. S. N° 223 —  
— SCALE 2 = ONE FOOT —  
TO CLASS 10A - 112' x 20'-6" x 9'-6" MLD

THE FOLLOWING ADDITIONS FOR GROUNDING INCLUDED UNDER


INTERCOSTAL KEELSON FITTED

MIDSHIP THICKNESS OF BOTTOM PLATING CARRIED FORD TO STEEL

LANDINGS OF SHELL IN BOTTOM DOUBLE RIVETED

INTERMEDIATE FRAMES FITTED FORD SEE PROFILE

RIVETING AS PER SECTION .17.

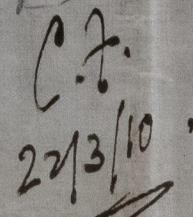




Scott & Sons

N<sup>o</sup> 223.

1/2 Kinnaird Head  
Gls Report N. 29106

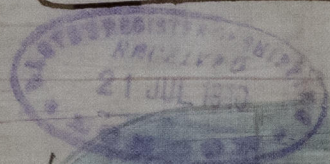

WILSON

N.A. GLAS IRAN

Midship Section

012553-012563-0189



© 2021

Lloyd's Register  
Foundation