


MIDSHIP SECTION.


FOR SINGLE SCREW TANK MOTOR SHIP.

CLASS:

LLOYD  100 A4 CARRYING PETROLEUM IN BULK.

SPECIAL NOTATION: LONGITUDINAL FRAMING

ELECTRICALLY WELDED

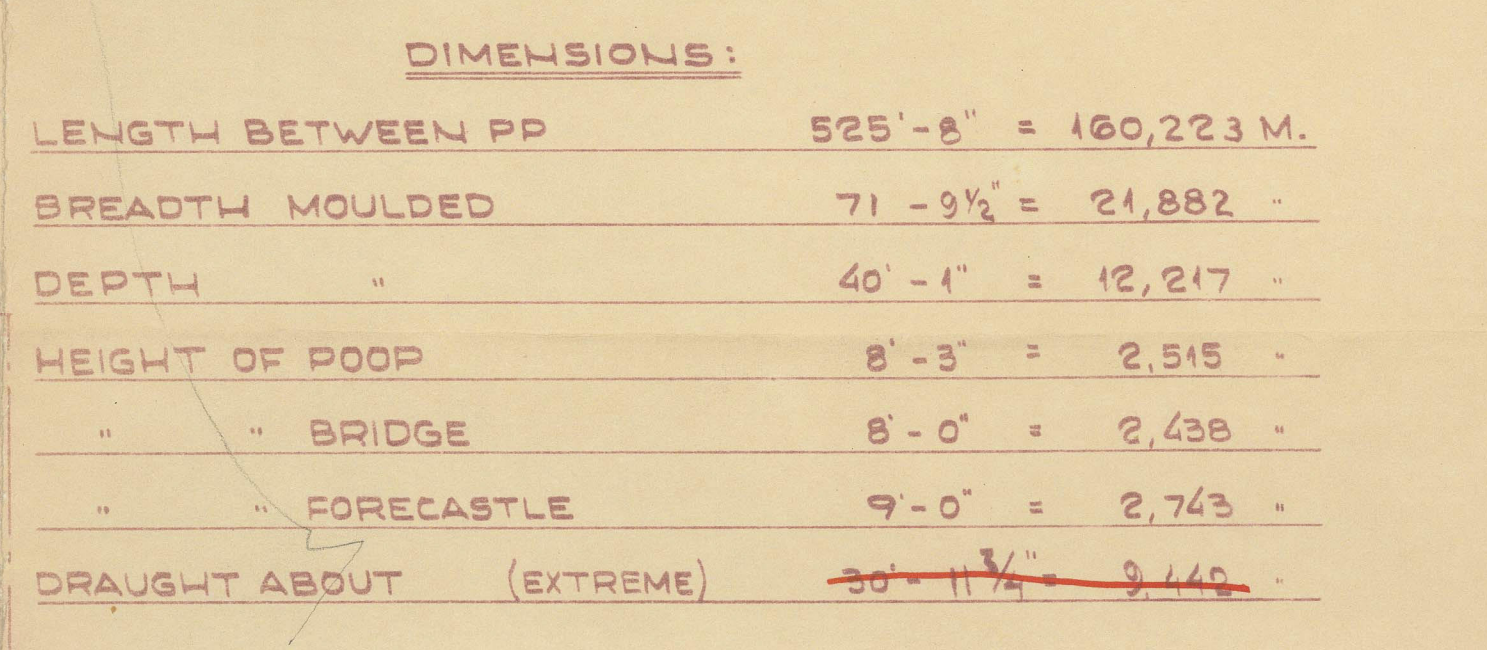

THE SCANTLINGS ARE SUITABLE FOR A SUMMER MOULDED DRAUGHT OF ABOUT 30'-10" THE MINIMUM FREEBOARD WILL, HOWEVER, BE DETERMINED ON COMPLETION OF THE SHIP BY THE REGULATIONS OF THE LOAD LINE CONVENTION.

EQUIPMENT NUMBER	30-80		
L-(B-D) = 525.67-(5.75-30-70)	30-85	= 34-0.27	\$3.50
85-L-(975-D-J) = 85-525.67-(975-400-30-85)	30-85	= 34-4	\$6.00
POOP 112 85-85-85		= 7.87	
BRIDGE 50-8-8-85		= 3.44	
PORCECABLE 76-70-85		= 7.14	
DECK-HOUSES OH POOP 82-85-75-70-85-75		= 10.33	
" " MID-SEA 35-85-78		= 2.23	
" " "		EN 411-8	

1954 RULES
FINAL NUMBER (IN ACCORDANCE WITH ~~NOTICE 2013~~) TO BE
DETERMINED ON COMPLETION OF SHIP.

LETTER: i

EQUIPMENT

3 BOW ANCHORS STOCKLESS 99 CWT EACH COLL. WEIGHT 2897 CWT.

330 FATHOMS $2\frac{1}{2}$ " STUDCHAIN CABLE MIN WEIGHT 1317 CWT. OR

330 FATHOMS $2\frac{3}{8}$ " STUDCHAIN CABLE SPEC. STEEL MIN WEIGHT 979 CWT.

130 $\frac{1}{2}$ " STEEL WIRE 6 X 24 SPEC. FLEX. STEEL WIRE ROPE.

3-140 $\frac{1}{2}$ " FLEXIBLE

TENTS OF EQUIPMENT AND WEIGHT IS BY POSITION LENGTH OF CABLE TO RULE.

TESTING of EQUIPMENT and WEIGHT FOR 15 FATHOM LENGTH of CABLE to ROLLS.

SIDE & EDGE LONGITUDINALS		
Nº	DIMENSION	ALTERNATIVE
1	200 x 90 x 11	8' 1" x 48" 1"
2		
3		
4		
5	290 x 11 = 100 x 12	1' 10" x 1' 48"
6	250 x 90 x 12	10' x 4' x 50"
7	250 x 90 x 16	10' x 4' x 57"
8	290 x 11 = 150 x 12	
9	250 x 11 = 150 x 14	9' x 46" = 7' 55" x 49" 1"
10	250 x 11 = 150 x 16	9' 25" x 46" = 7' 55" x 60"
11	290 x 11 = 170 x 12	
12	290 x 11 = 170 x 15	
13	290 x 11 = 170 x 16	
14	320 x 11 = 170 x 16	

BULKHEAD LONGITUDINALS		
NO	DIMENSION	ALTERNATE
1/2	200 x 90 x 10.5 I	8' 6" x 42' I
4	250 x 90 x 11 I	
8		
11		
13	270 x 11 x 170 x 13 I	

ED BY THE BUILDER

LIGHTENING HOLES IN WEBS TO BE PLACED
NOT LESS THAN HALF DEPTH OF WEB FROM FACE.

MIDSHIP SECTION AT MIDLENGTH OF CENTRE TANK

CORRECTED AS APPROVED BY LLOYD'S REGISTER OF SHIPPING 26-54

A circular purple ink stamp. The outer ring contains the text "KOCKUMS" at the top and "MÄLMÖ SWEDEN" at the bottom. Inside this ring, the text "MEK. VERKSTADS A.-S." is written in a smaller arc. In the center of the stamp, the date "18 MAJ 1955" is stamped, flanked by two five-pointed stars.

FACT NO	CLASS	M.T. 394 & 424.
394	L.L.	
424	L.L.	
		<u>MIDSHIP SECTION</u>
		SKALA: 1:25 KOCKUMS MEK. VERKSTADS A-B, MALMÖ - SWEDEN
RIT AV: B/EN KOP AV: 2 W/2 GRANSK:		F 387 / 1A
DAT: SEPT. 54		

525'-8" / 71'-9 1/2" / 40'-1" / 30'-11 3/4" / 012585-012590-0

012585-012590-0001


(M/M. 12585)
BITTERFIELD ★

Midship Section

KOCKUM MEK VERKS

RECORDS DEPT.
LONDON.

Yard Nos. 394 & 424

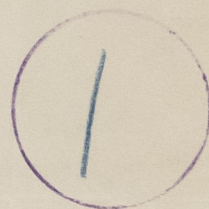

MIDSHIP SECTION



© 2021

Lloyd's Register
Foundation