


1) PARTIALLY REVISED.
NOV. 1ST, 1958.

LINES OF RUDDER
(1/25)

VERTICAL SECTION
(LOOKING FORWARD)

PROFILE OF RUDDER
(1/30)

NOTES:-

- 1) PLAN OF RUDDER CONSTRUCTION FOR SNO 749 WITH THIS PARTIAL REVISED PLAN SHOWS THE ONE FOR P.NO 760.
- 2) THE PLAN FOR P.NO 760 IS TO BE APPROVED BY L.R.S. AND N.K.S.
- 3) RED-COLOURING SHOWS REVISED PARTS.
- 4) YELLOW-COLOURING SHOWS ABOLISHED PARTS.

註)

- 1) SNO 749 舵構造図 (H-25411) に本改正図を附し P.No 760 舵構造図とする。
- 2) P.No 760 は LR 及 NK 両船級協会に承認を受けること。
- 3) 赤着色は改正を示す。
- 4) 黄着色は廃止を示す。

PORT YOKOHAMA


3040

NAME OF SHIP "KOWA MARU"

BUILDER TSURUMI SHIPYARD, N.K.K.

YARD NO. 760

SISTER SHIP TSURUMI SHIP Nos 749

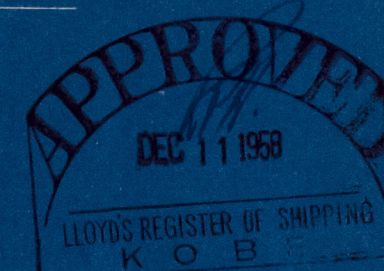

APPLIED FOR P.No. 760

| | | |
|---|----------------------------------------------------------------|------------------------------------------------------------|
| DESIGN DEPARTMENT TSURUMI SHIP YARD | P.No. 760 | 34800 DWT OIL TANKER |
| DESIGN CHIEF SECTION CHIEF BRANCH CHIEF CHECKED BY DRAWN BY DATE OF DRAWING SCALE | V. H. G. H. T. H. K. H. Nov. 1ST, -58 1/25 1/30 | RUDDER CONSTRUCTION (PARTIAL REVISION) 舵 構 造 一部改正 |
| WORK DIV. | NIPPON KOKAN K.K. | DWG. NO. CH-25411-760 DATE OF ISSUE |

012585-012590
-0060


FOR APPROVAL
TO LLOYD'S REGISTER
OF SHIPPING

"KOWA. MARU"




1
50

RECORDS DEPT.
LONDON.

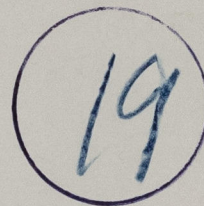

Rudder Construction

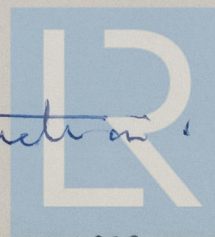

© 2021

Lloyd's Register
Foundation

DEC - 4 1958

012585 - 012590 - 0060