


34,800 DWT OIL TANKER MIDSHIP SECTION


- DESIGNED BY TSURUMI SHIPYARD
NIPPON KOKAN K.K. YOKOHAMA
JAPAN
DEC 12TH 1957
- APPROVED BY L. R. S.
NOV 21TH 1958
- APPROVED BY OWNER'S
DEC 12TH 1958
- APPROVED BY NK
DEC 17TH 1958
- FINISHED PLAN
OCT. 25TH 1959

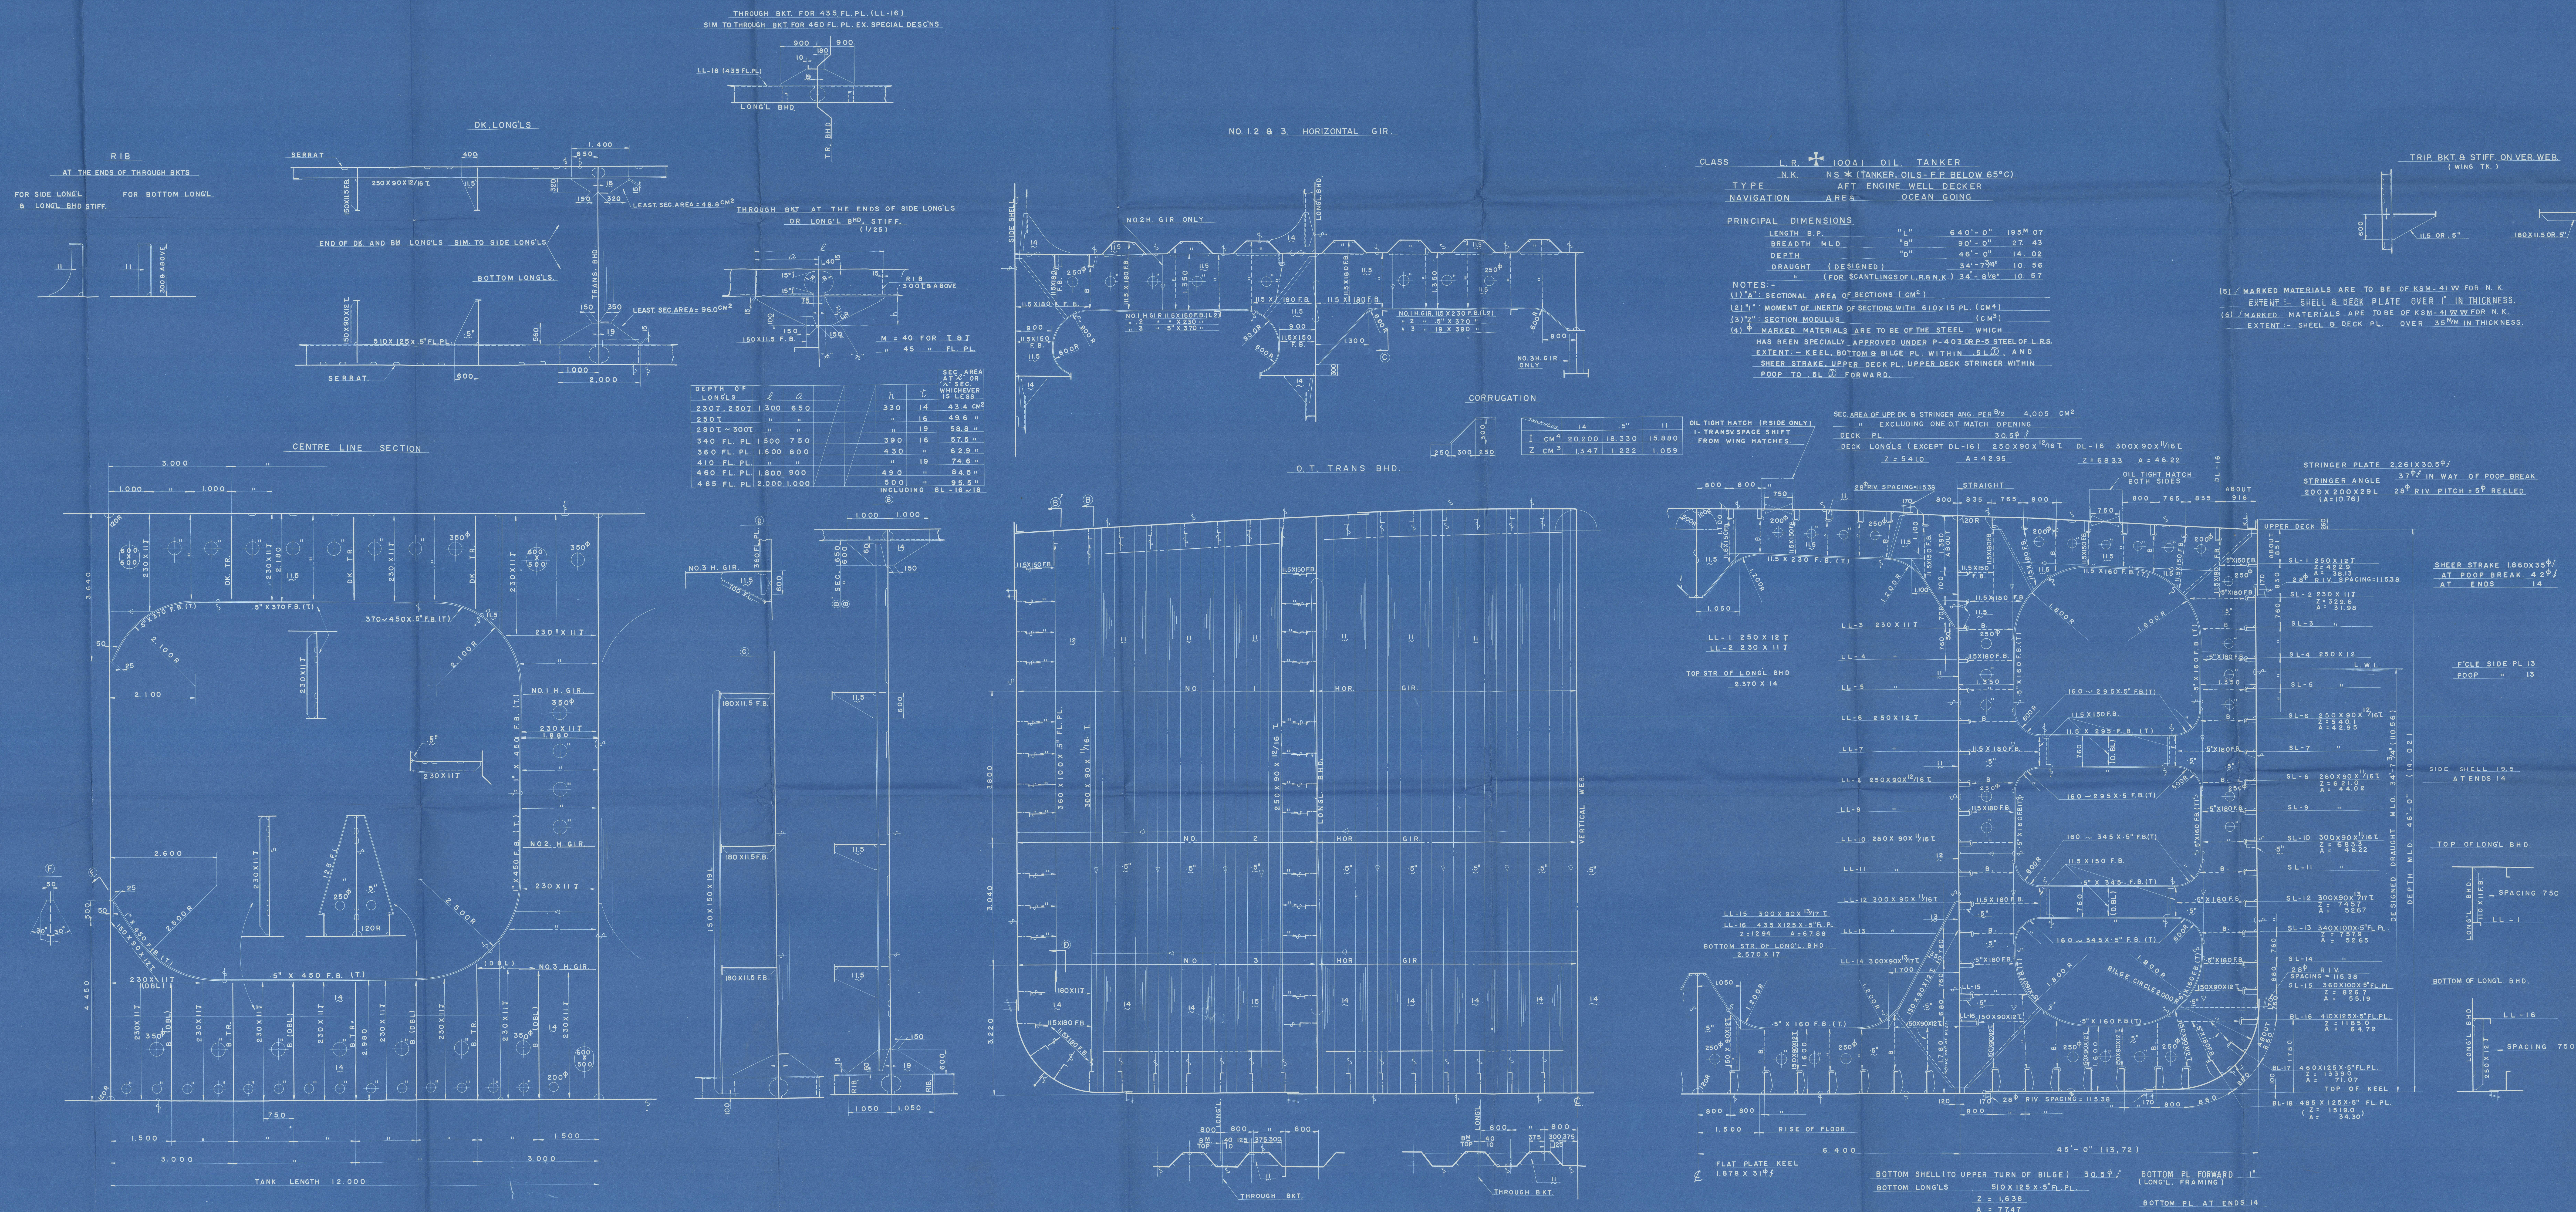

CERTIFIED COPY OF
PLANS AS APPROVED
CERTIFIED

DESIGN TSURUMI	DEPARTMENT SHIP YARD	KOWA MARU	34,800 DWT. OIL TANKER
SECTION SHIP		MIDSHIP SECTION	
BRANCH SHIP		FINISHED PLAN	
CHECKED BY		中央横断面	
DRAWN BY			
DATE OF DRAWING			
SCALE			
WORK NO.			
NIPPON KOKAN K.K.			
CH-10011			
DATE OF ISSUE			

ISSUED PLAN

APPROVED PLAN

DATE 21.11.58

DATE NOV. 16. 1959

" KOWA-MARU " ★

RECORDS DEPT.
LONDON.

2



Midship Section (as fitted)



© 2021

Lloyd's Register
Foundation

012585-012590 0069