

PRINCIPAL DIMENSIONS		
LENGTH OVER ALL	202'194"	
LENGTH B.P.	192.02	
BREADTH M.L.D.	26.52	
DEPTH M.L.D.	13.87	
DRAET EXTREME	10.441	
DEADWEIGHT	33,354 K.T.	
GROSS TONNAGE	20,257.13 ^T	
MAIN ENGINE	HARIMA SULZER 10R540 75 T.P.C.	
B.H.P.	MAX. CONT.	13,000

COMPLEMENT			
DECK	ENGINE	OTHER	TOTAL

FINISHED PLAN

HARIMA SHIPBUILDING & ENG. CO. LTD.
AIOI, HYOGO, JAPAN.

S.N. 512 室栄丸

一般配置
GENERAL ARRANGEMENT

SHIP DESIGN DEPT. SCALE: 1/200


DRAWN BY: *[Signature]*
CHECKED BY: *[Signature]*
DESIGNED BY: *[Signature]*
DATE: 001/21/1957

SCALE: 1/200
DESIGNED BY: *[Signature]*
CHECKED BY: *[Signature]*
DATE: 001/21/1957


DWG NO. 10000403

CERTIFIED COPY OF "APPROVED PLAN"

RECORDS DEPT.
LONDON.

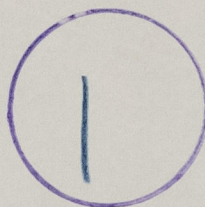

Kobe Rpt. No.	FE 5181
Port of Survey	AIOI
Name of Ship.	HOEI MARU
Title of Plan.	GENERAL ARRANGEMENT

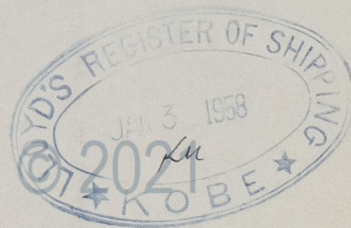

Lloyd's Register
Foundation

012585-012590-0118