

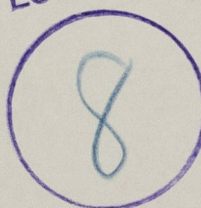


CERTIFIED COPY OF "APPROVED PL

RECORDS DEPT.
LONDON.

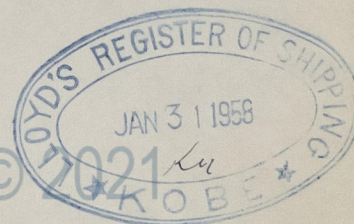

Kobe Rpt. No.	FE 5181
Port of Survey.	A 101
Name of Ship.	HOEI MARU
Title of Plan.	STERN FRAME

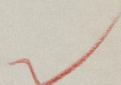

© 2021

Lloyd's Register
Foundation

012585-012590-0122