

Nº 2108.
"PADAPYAN"

QUARTER WHEEL MOTOR VESSELS
FOR
INLAND WATER TRANSPORT BOARD, BURMA.
CONSTRUCTIONAL SECTIONS (AS FITTED).

SCALE: $\frac{1}{2}$ - 1 FOOT.





LENGTH OVERALL	148'-6"
LENGTH HULL EX TONGUE	134'-0"
LENGTH WATERLINE	130'-0"
BREADTH MOULDED	34'-0"
DEPTH	5'-6"
LOAD DRAUGHT	4'-0"

EQUIPMENT:-
ONE STOCKLESS ANCHOR - 6 CWT.
45 FATHOMS $\frac{3}{8}$ " STUD LINK CABLE
IN THREE 15 FATHOM LENGTHS.

RECORDS DEPT.
LONDON.

2

MIDSHIP SECTION as fitted

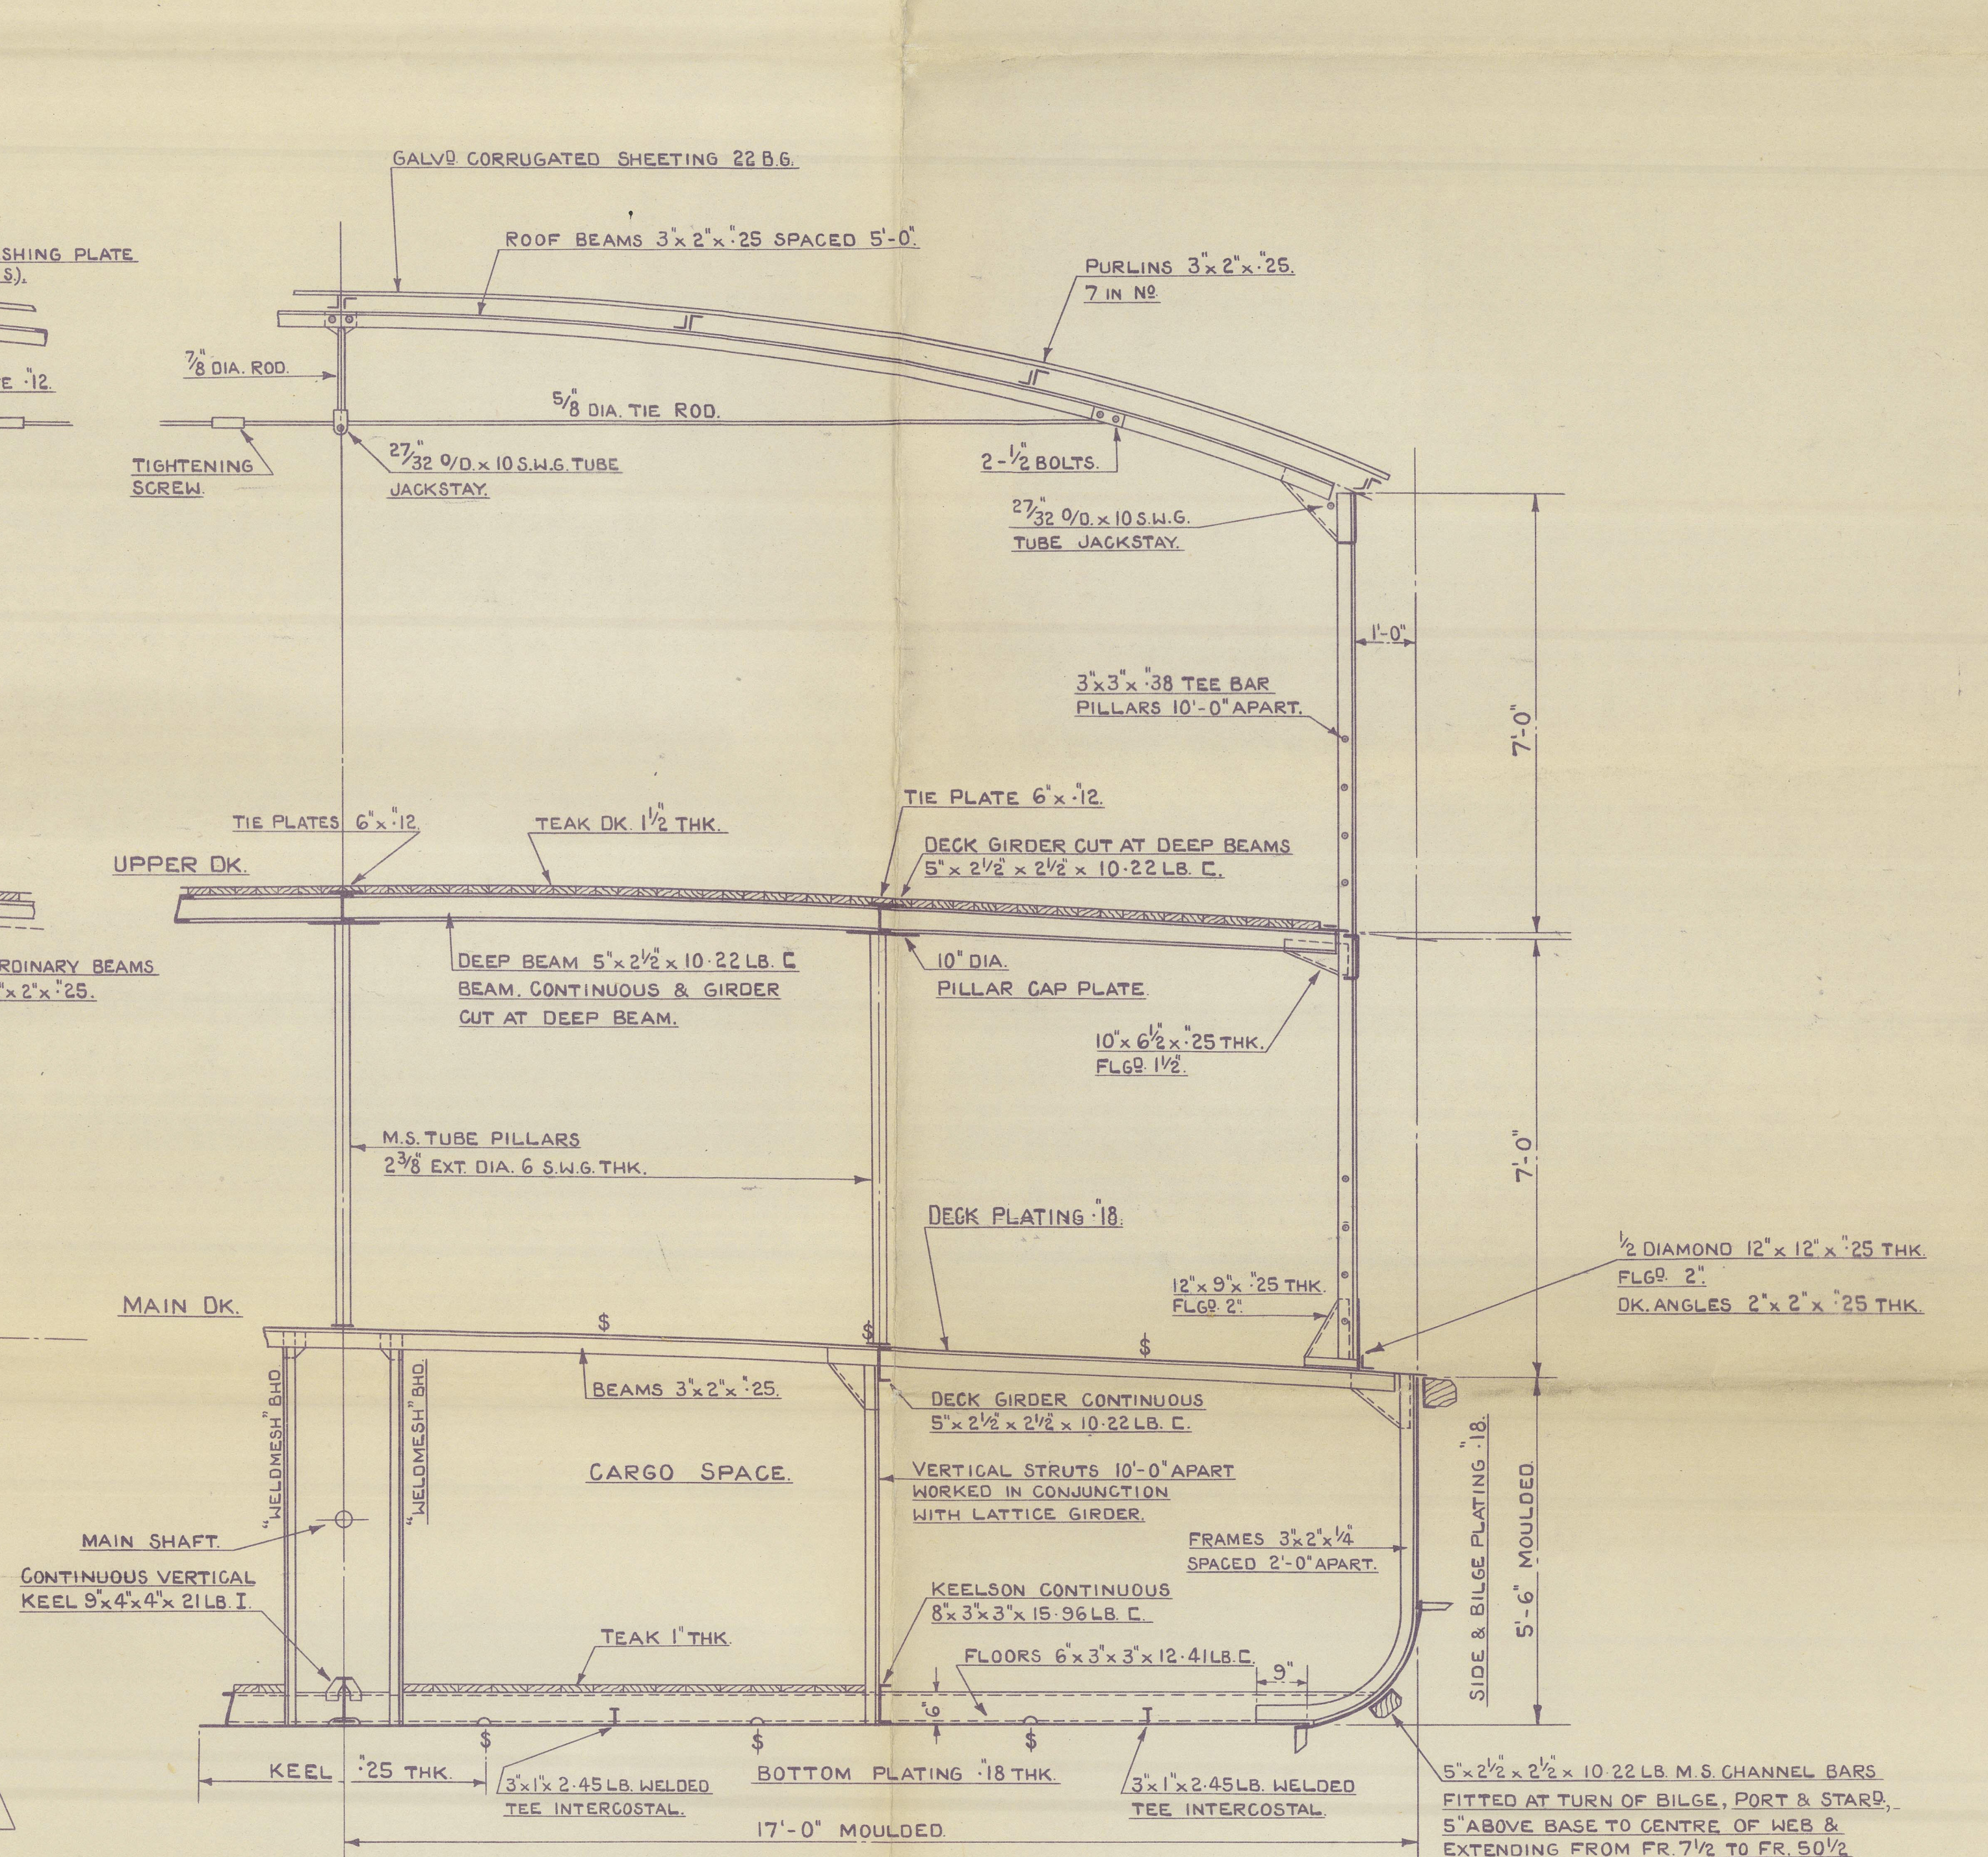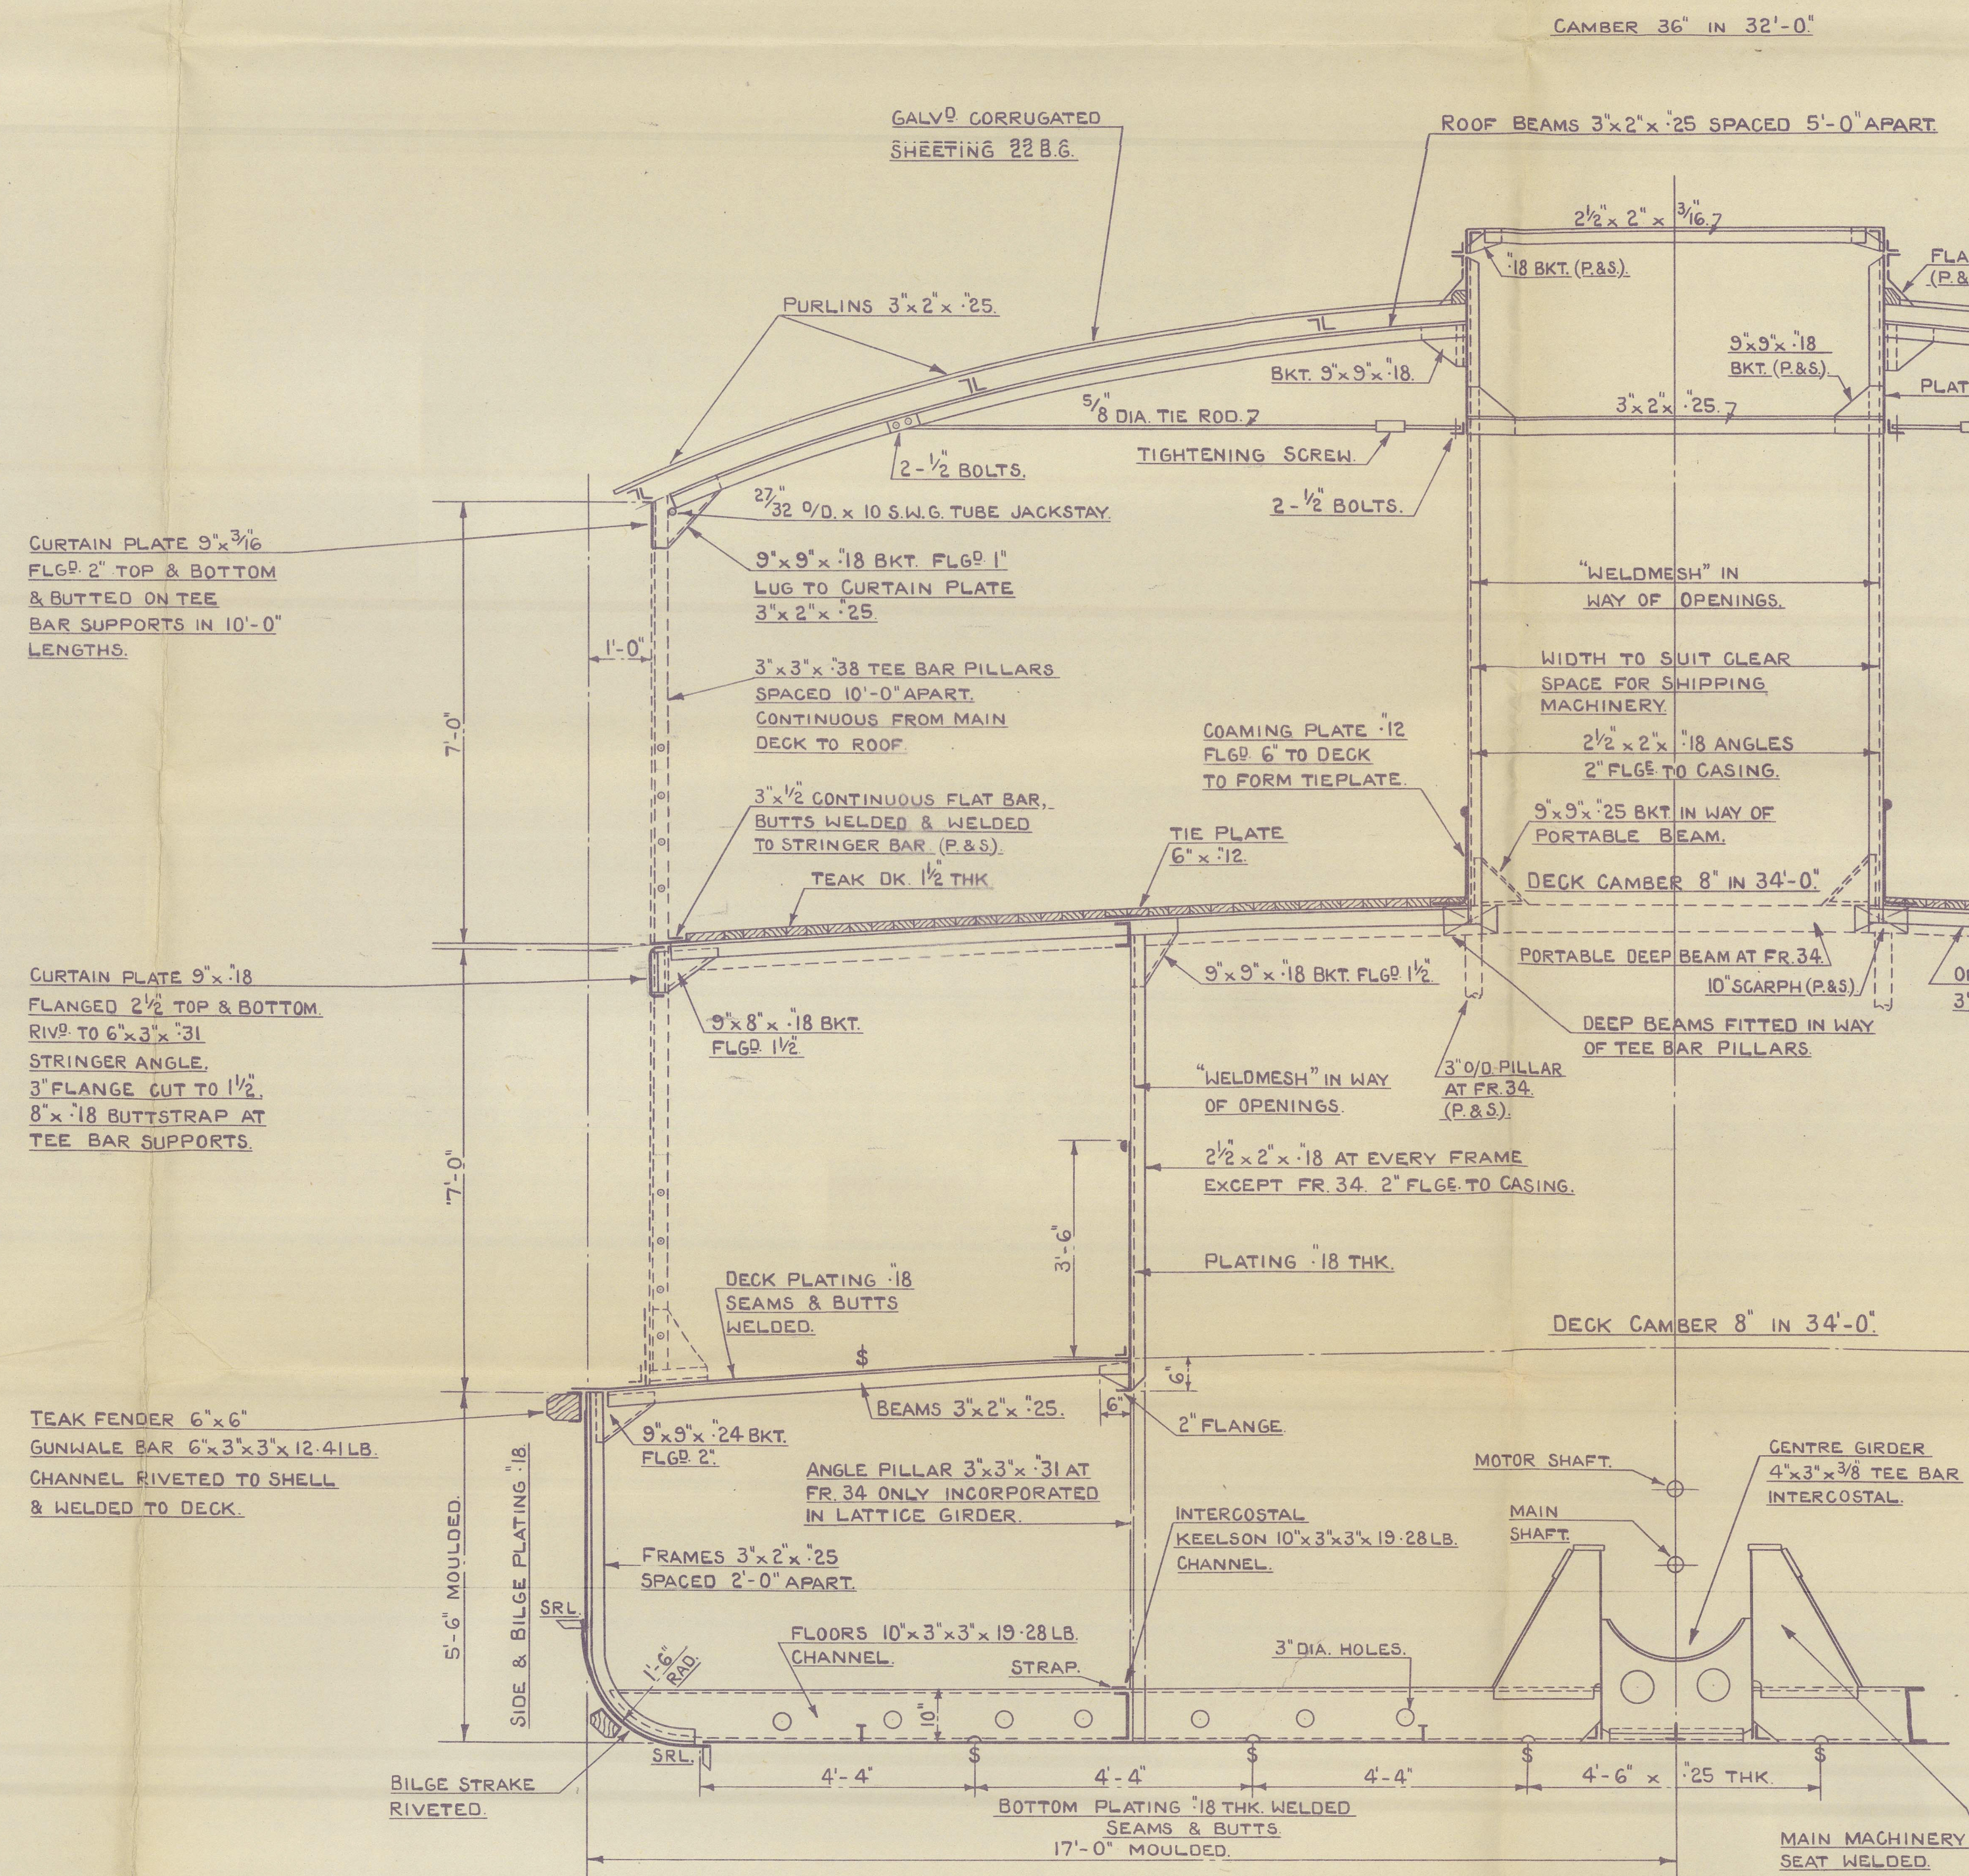

Nº 40788.

Nº 40788.



© 2021
Lloyd's Register
Foundation