

# MIDSHIP SECTION


S.S. No. 859

SCALE 1/2" = 1 FOOT.

DIMENSIONS  
TO CLASS B.S. \* SPECIAL SURVEY BRITISH CORPORATION.  
LENGTH 359.25 ON LOADLINE.  
SUMMER DRAFT 21'-11" incl. approximately

EQUIPMENT	NUMBER	
HULL	(359.25 x 51.5 x 26.0 x 78) + 100	= 3607.77
POOP	(40.0 x 51.25 x 9.5 x 75) + 150	= 97.40
BRIDGE	(110.5 x 51.25 x 9.5 x 75) + 150	= 262.00
FGLE	(37.9 x 51.25 x 8.5 x 75) + 150	= 80.53
Howers		
EQUIPMENT	NUMBER	
		4117.70

EQUIPMENT	NUMBER	
6 BOWER ANCHORS	54 7/8 CWTs	STOCKLESS
1 STREAM	16	EX-STOCK
270 FATHOMS	2 1/2	STUD CHAIN CABLE

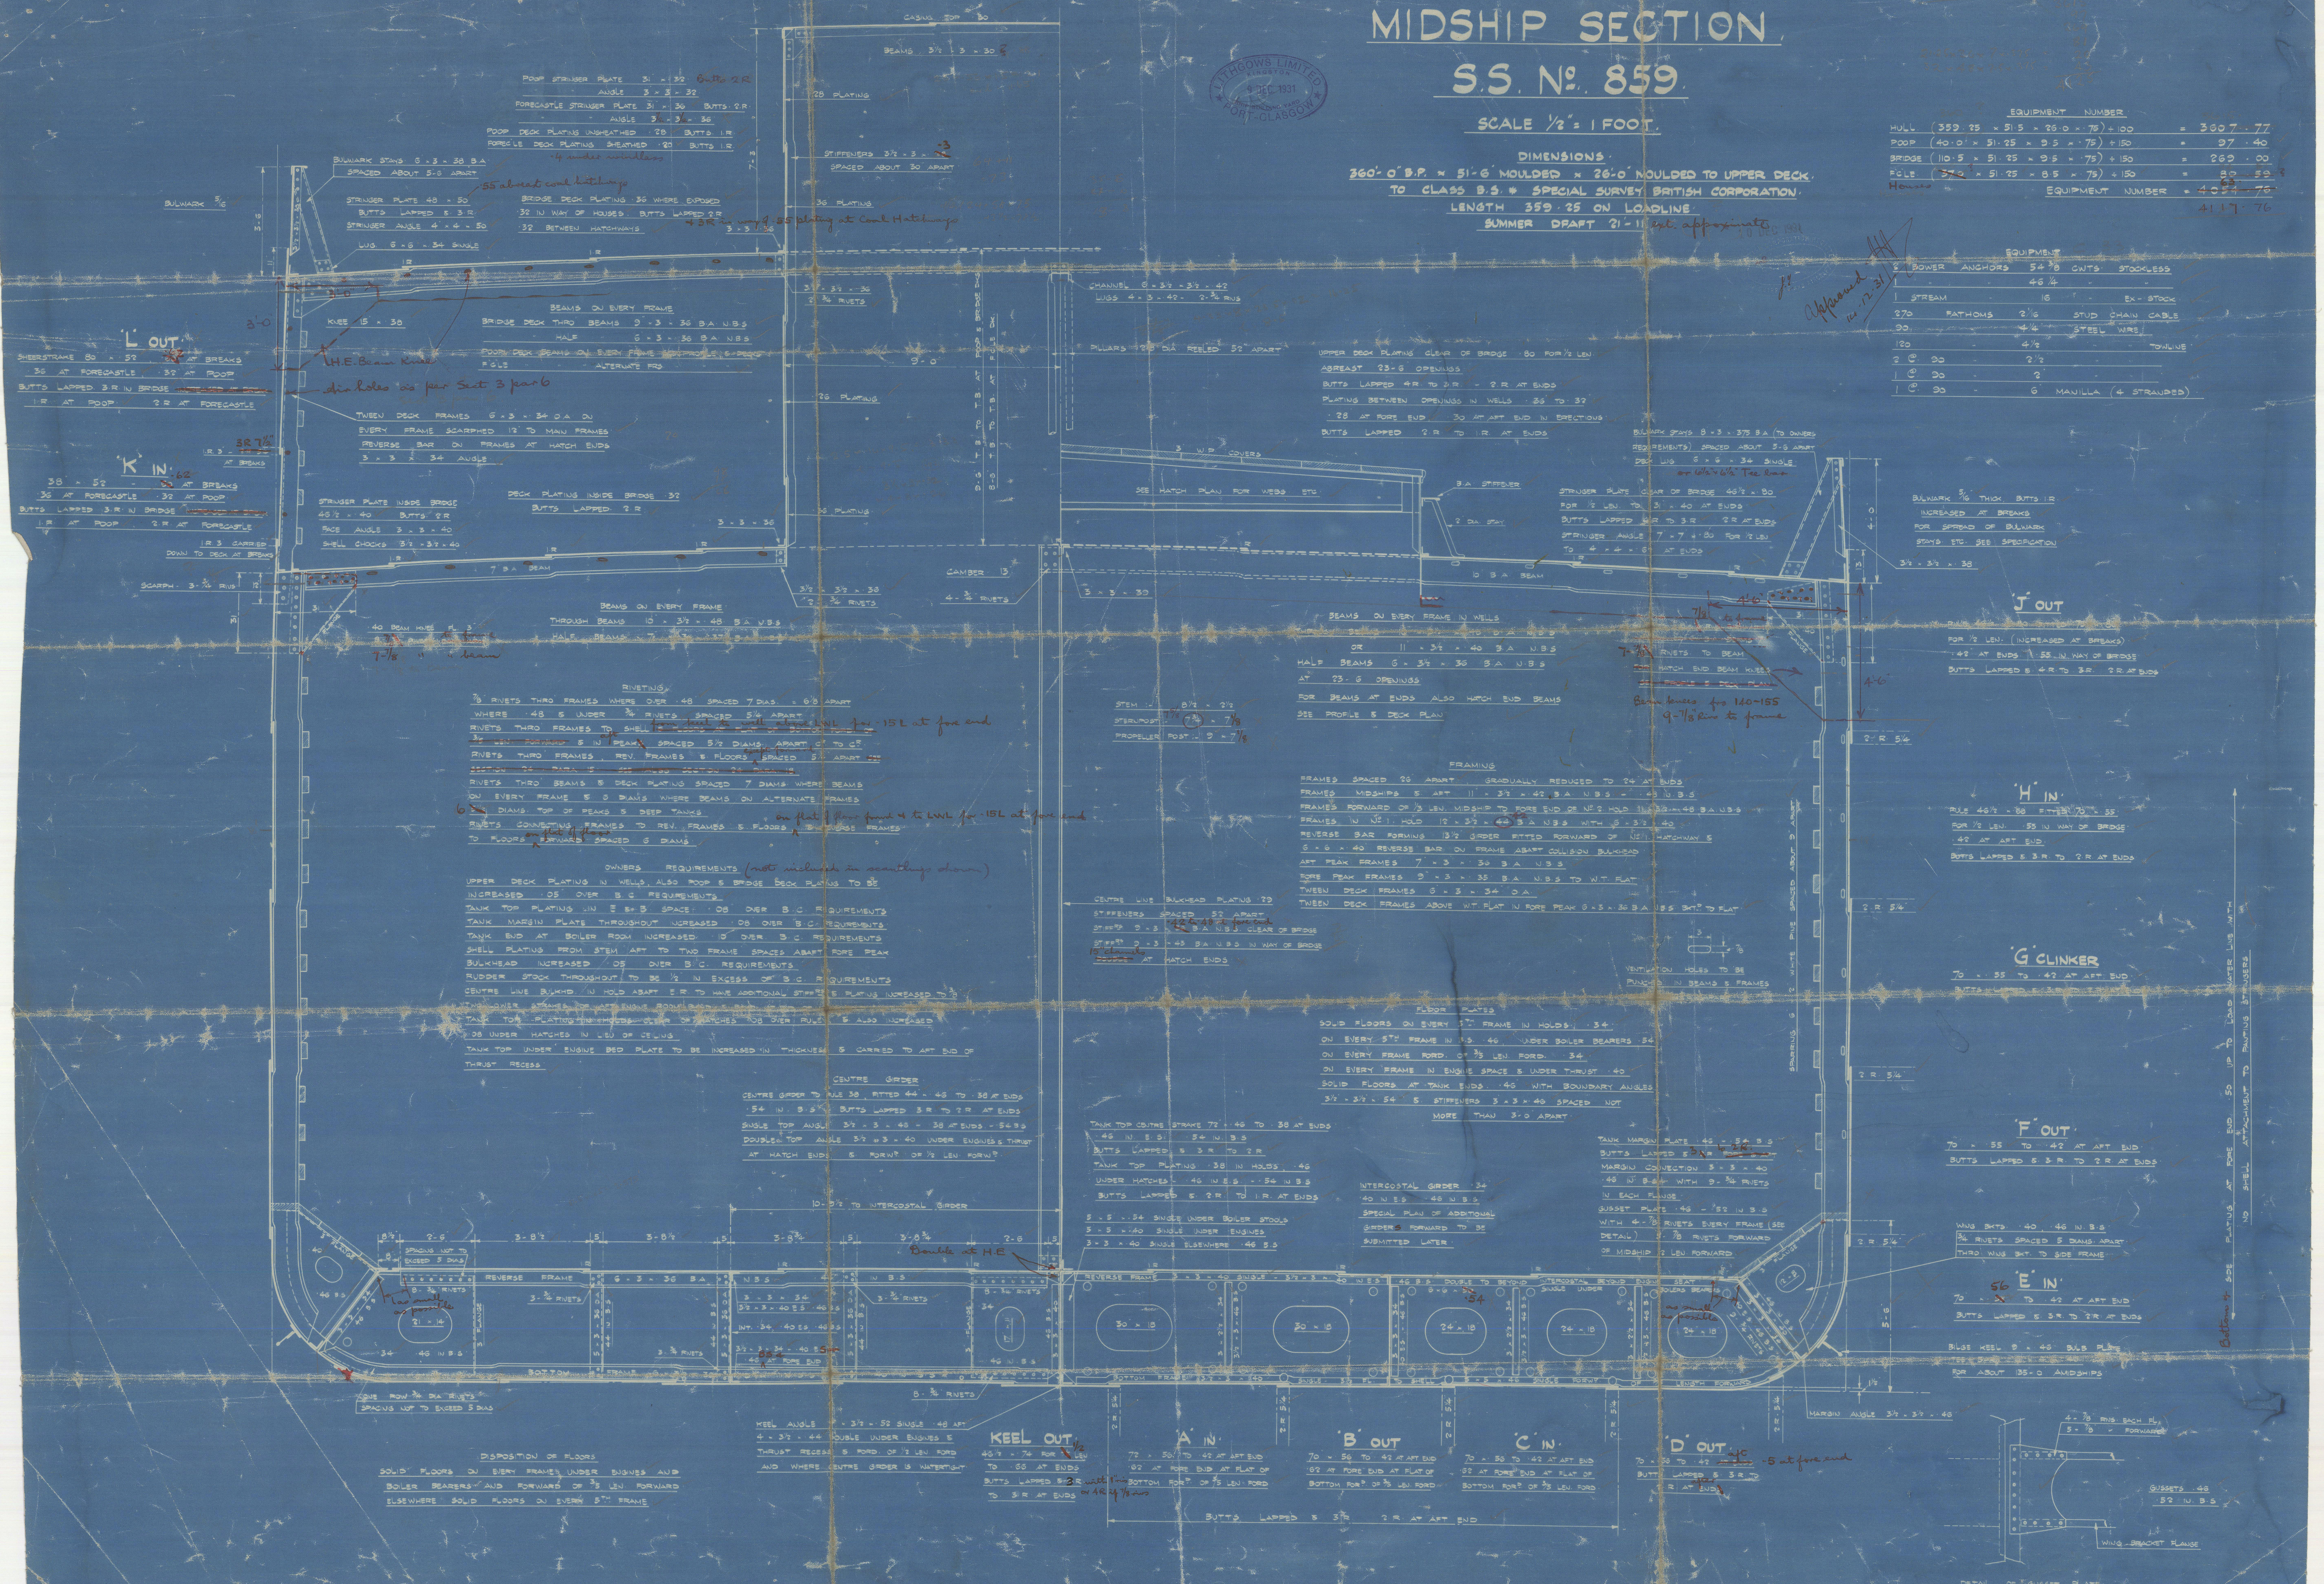



1  
Midship Section.

Lithgows Ltd.

No. 859

T.C. 2. 3. 32.

1H-12-21


BARON DOUGLAS

BARON DOUGLAS

bag

859

Midship Section.

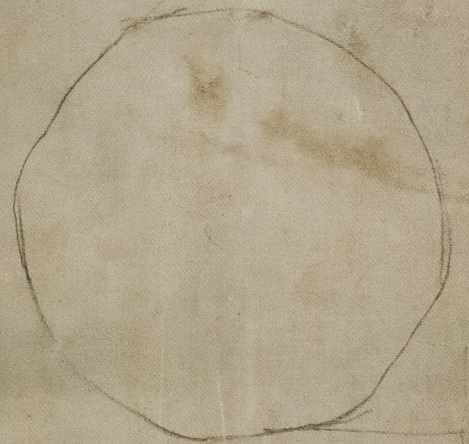

© 2021

Lloyd's Register  
Foundation

012610-012612-0001