



be led  
d'aria

✓

in luogo aperto

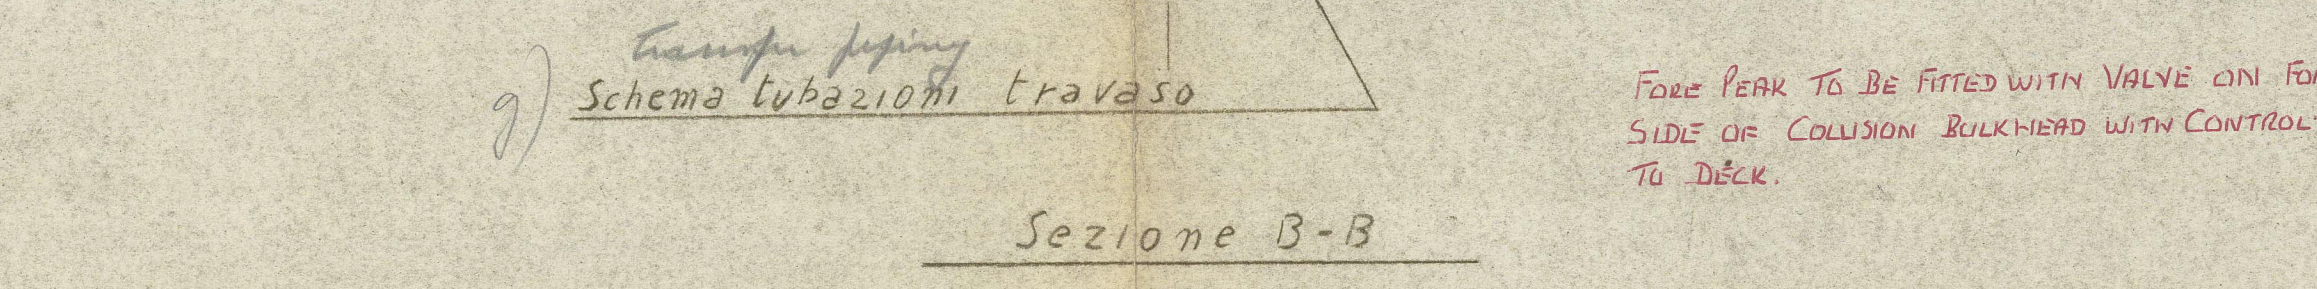



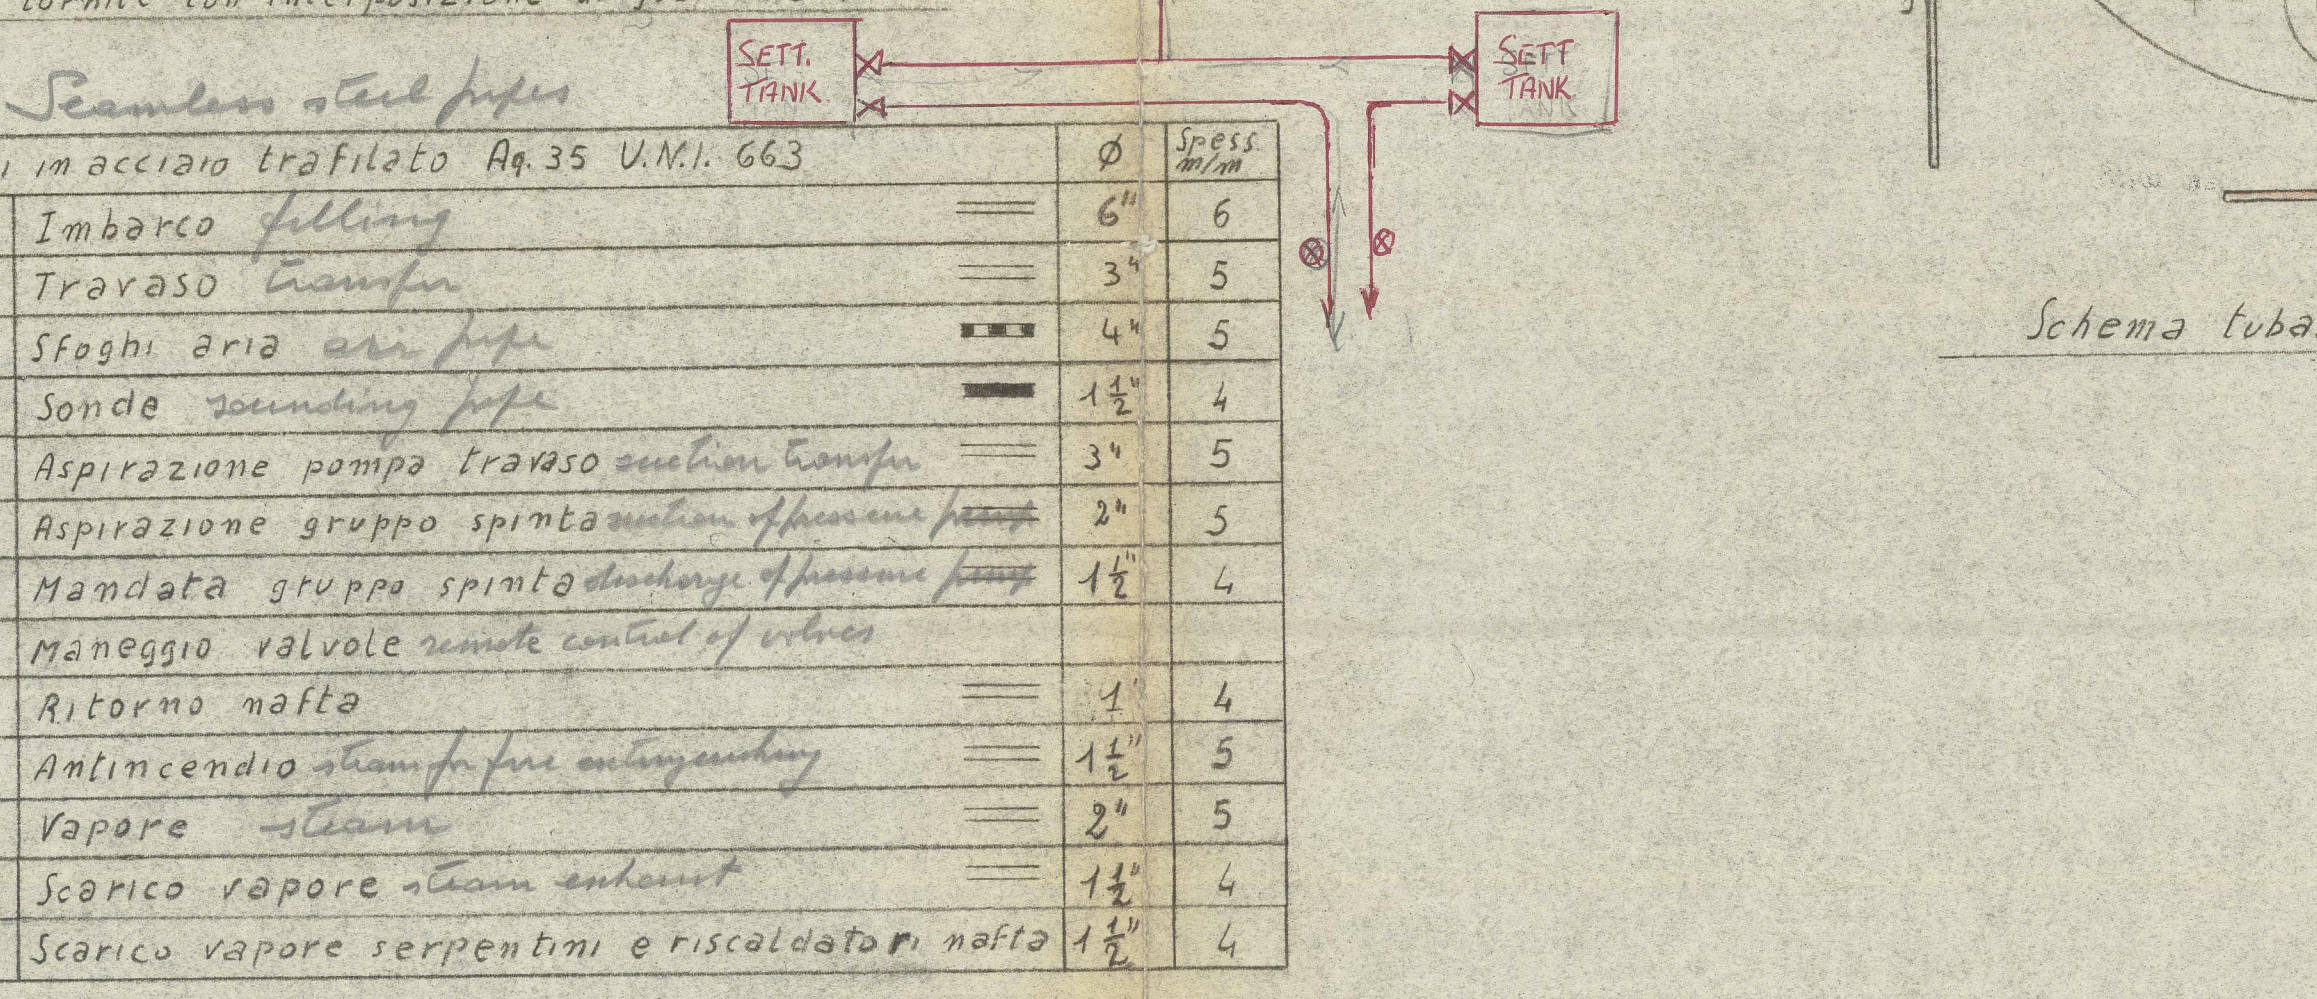

Tubi	macchinario trafilato	Ap. 35 U.M.I. 663	Ø	Spess. mm
1	Imbarco <i>elling</i>	==	6"	6
2	Travaso <i>transfer</i>	==	3"	5
3	Sfoghi aria <i>air pipe</i>	==	4"	5
4	Sonde <i>sounding pipe</i>	==	1 1/2"	4
5	Aspirazione pompa travaso <i>suction transfer</i>	==	3"	5
7	Mandata gruppo spinta <i>discharge pressure pump</i>	==	1 1/2"	4
8	Maneggio valvole <i>remote control of valves</i>			
9	Ritorno natto	==	1"	4
10	Antincendio <i>steam fire extinguisher</i>	==	1 1/2"	5
11	Vapore <i>steam</i>	==	2"	5
12	Scarico vapore <i>steam exhaust</i>	==	1 1/2"	4
13	Scarico vapore serpentine e riscaldatori natto	==	1 1/2"	4

Schema tubazioni nafta alle caldaie

The remaining requirements of the Rules for Pumping and Piping to be complied with so far as they are applicable.

LONDON COPY,

Schema impianto tubazioni nafta

Dis. Eng. P. Costantini      Scala 1:50      RAVENNA 31-1-1958

OFF. MECC. ROSETTI MARINO E FIGLIO



SS/MS "	ACRUX	"
TO ACCOMPANY	ven	Rpt. No. 0139
	Dated 4.58	
SUBJECT:- O.F. Piping arrangement.		



© 2021

Lloyd's Register  
Foundation

012610-012612-0023