

No. 274

# STERNFRAME & RUDDER



SCALE 1" & 3" = 1 FOOT

FORGED STEEL

9 JUN 1935



Approved *[Signature]*  
9.6.35

RUDDER STUFFING BOX  
SCALE 3" = 1 FOOT

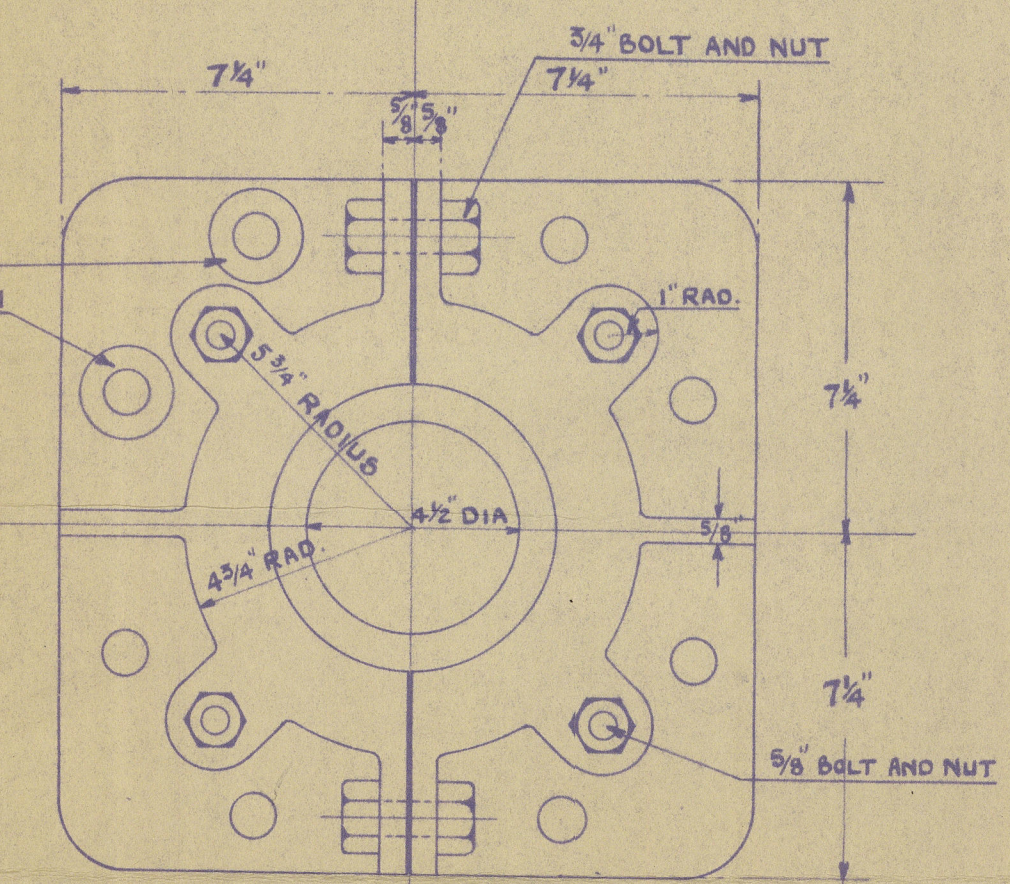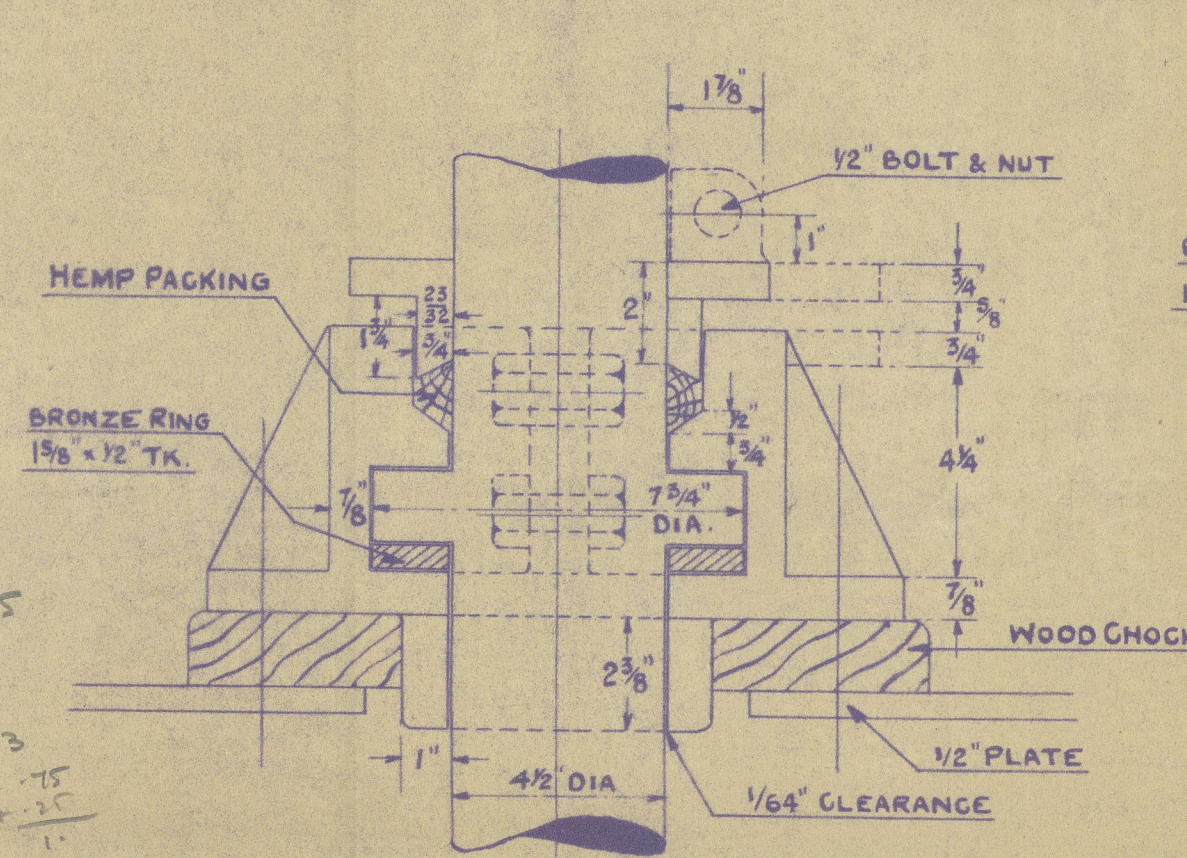


PLAN OF COLLAR


DETAIL OF COUPLING  
SCALE 3" = 1 FOOT

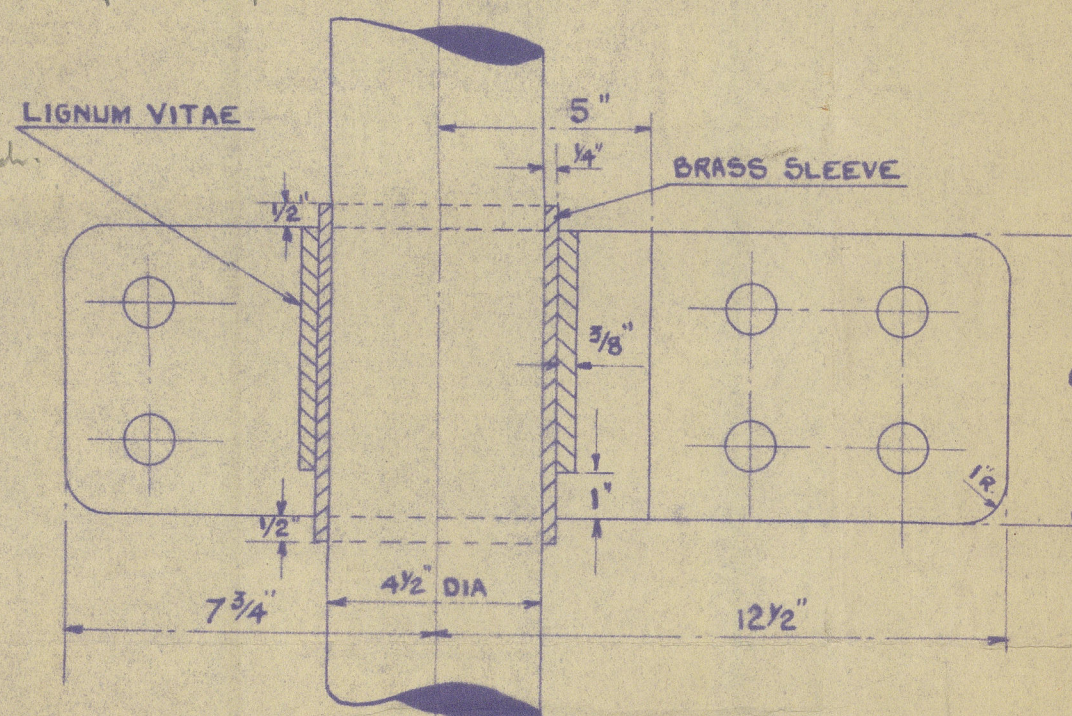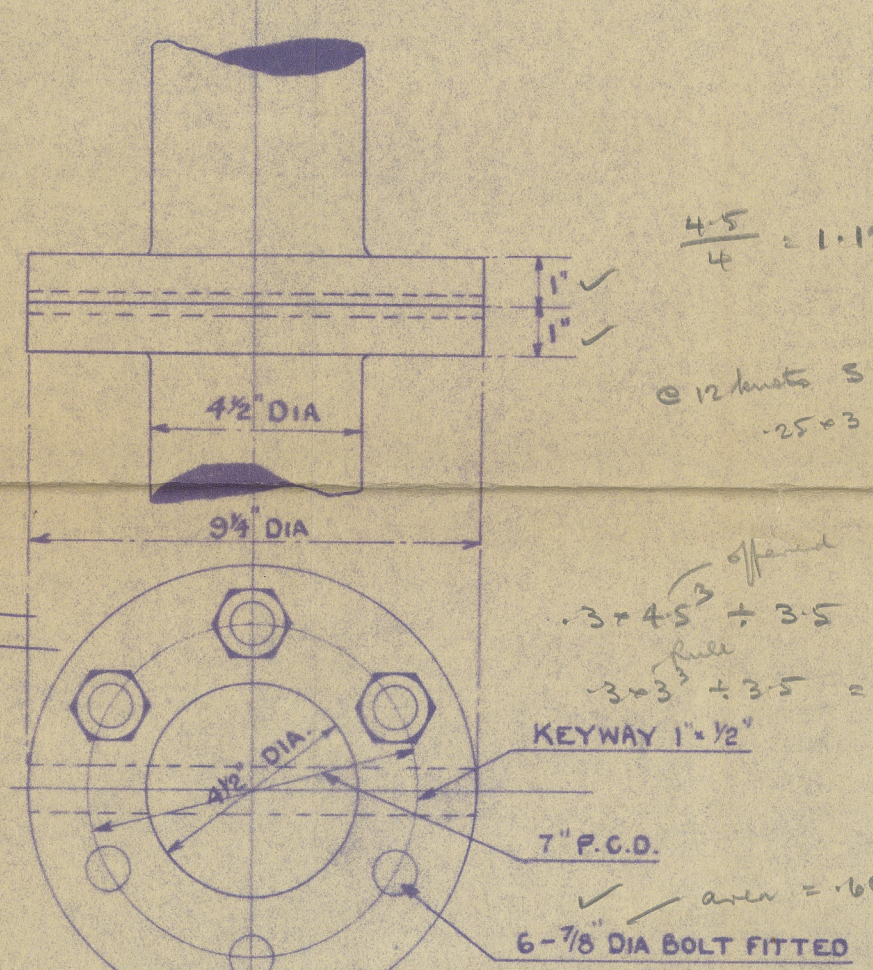


DETAIL OF UPPER GUDGEON  
SCALE 3" = 1 FOOT

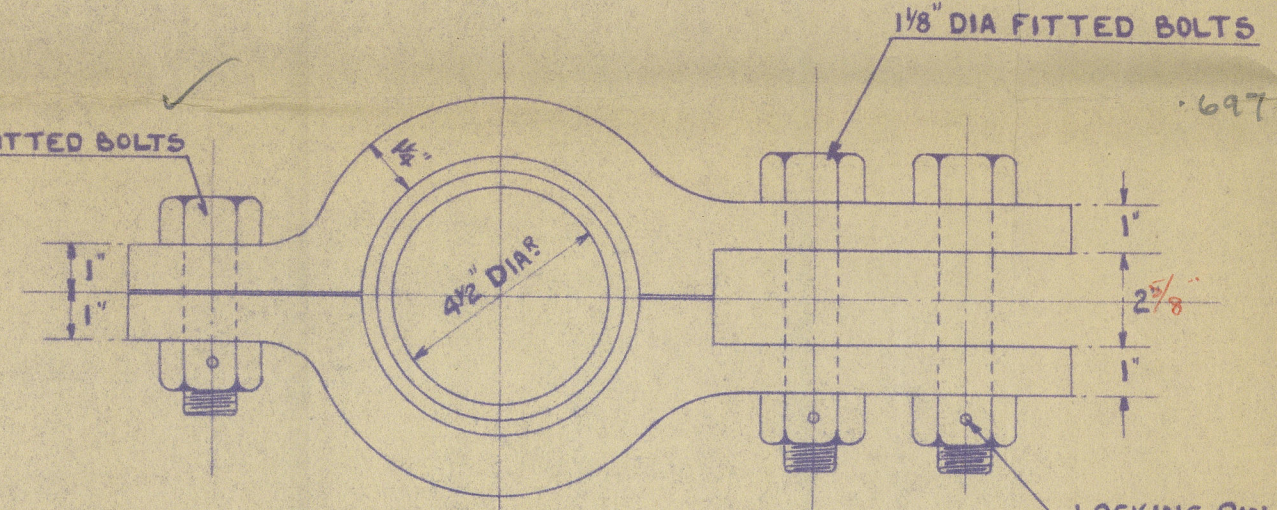

DETAIL OF COLLAR  
SCALE 3" = 1 FOOT

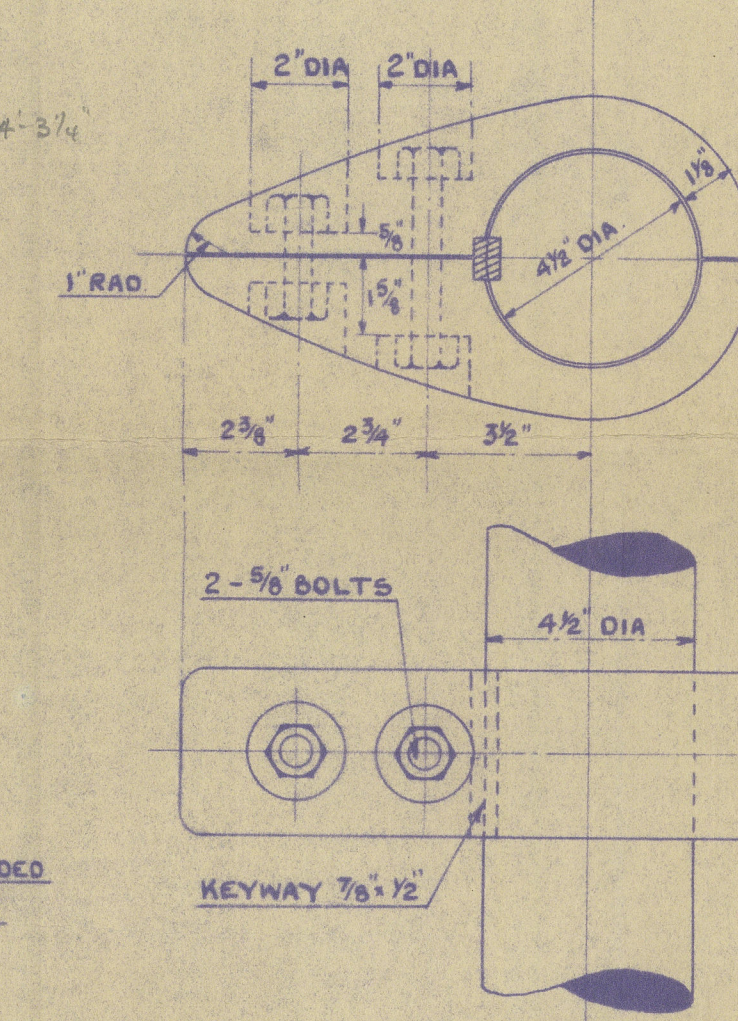


DETAIL OF BOTTOM GUDGEON  
SCALE 3" = 1 FOOT

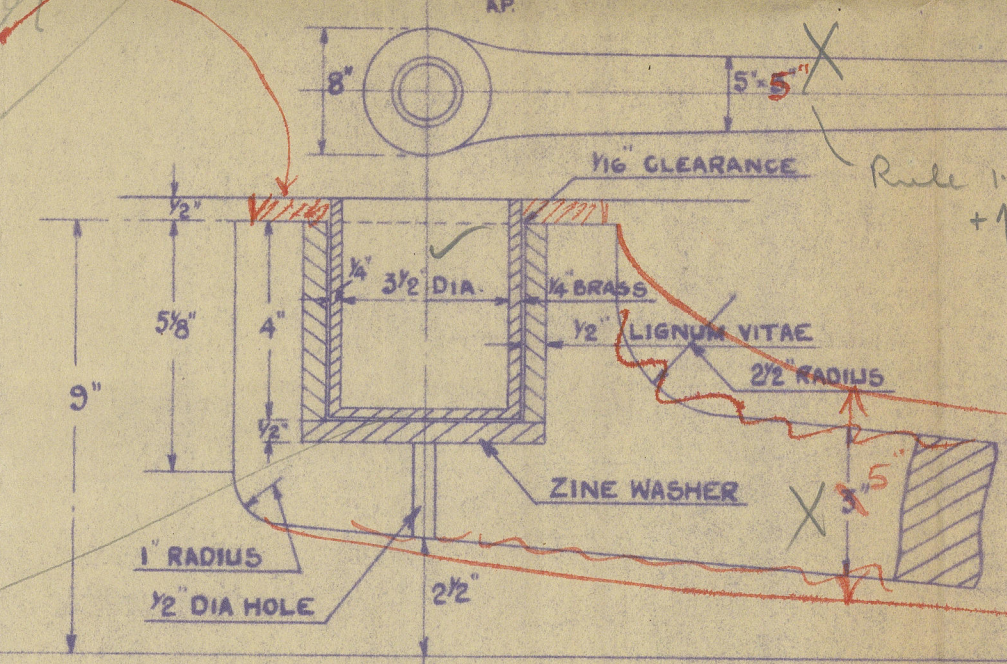


SECTION AT FR. 2

SECTION AT FR. 3

CORNERS ROUNDED AT CHECK

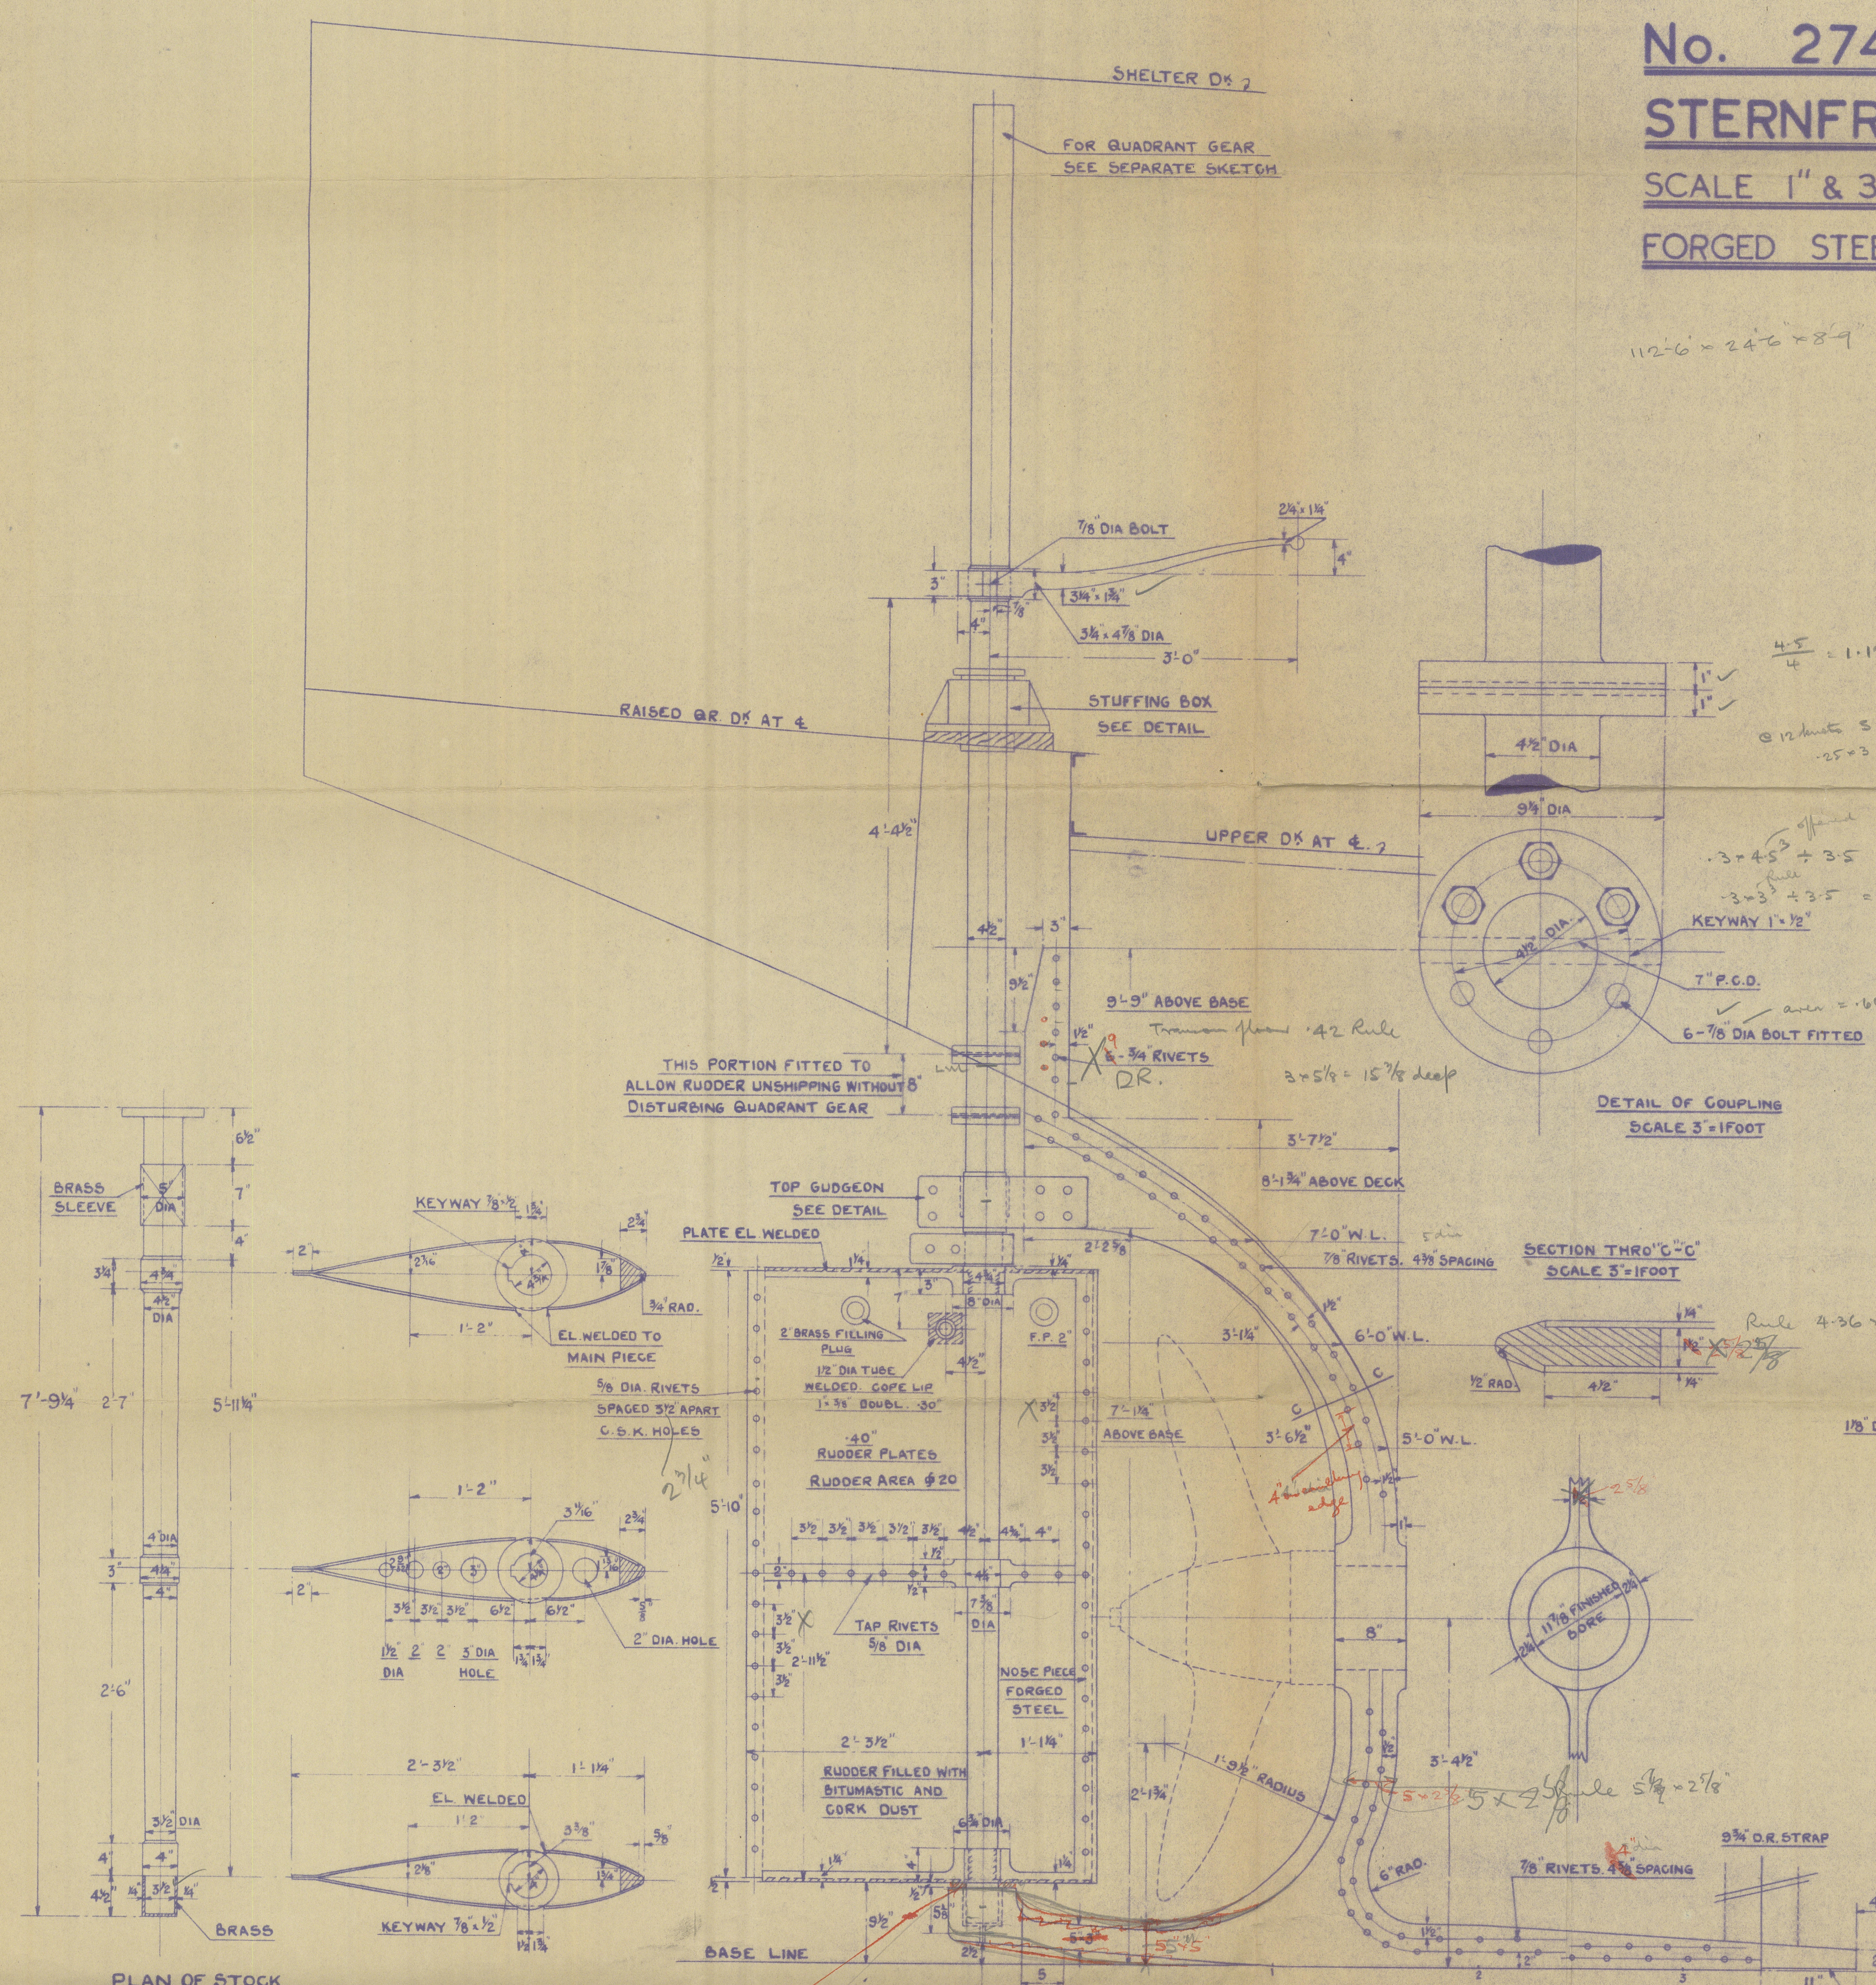

PLAN OF STOCK

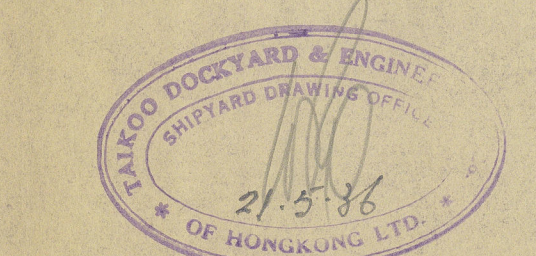

DRAWING No. A. 5196



3

Rudder & Sternframe.

Taikee Dock Co.

No. 274.

9.6.36

S<sup>m</sup> PULAU KIDJANG.

25  
10208



© 2021

Lloyd's Register  
Foundation

012631-012637-0026



3

Rudder & Sternframe

Taikoo Dock Co.

No. 274.

9.6.26

SM PULAU KIDJANG.

Rudder & Sternframe  
Taikoo Dock Co.

Bag

012631-012637-0026



© 2021

Lloyd's Register  
Foundation