



DONAI  
 Damage Repair  
 p.s.a. HAVRE  
 Rept No 9773

LONDON

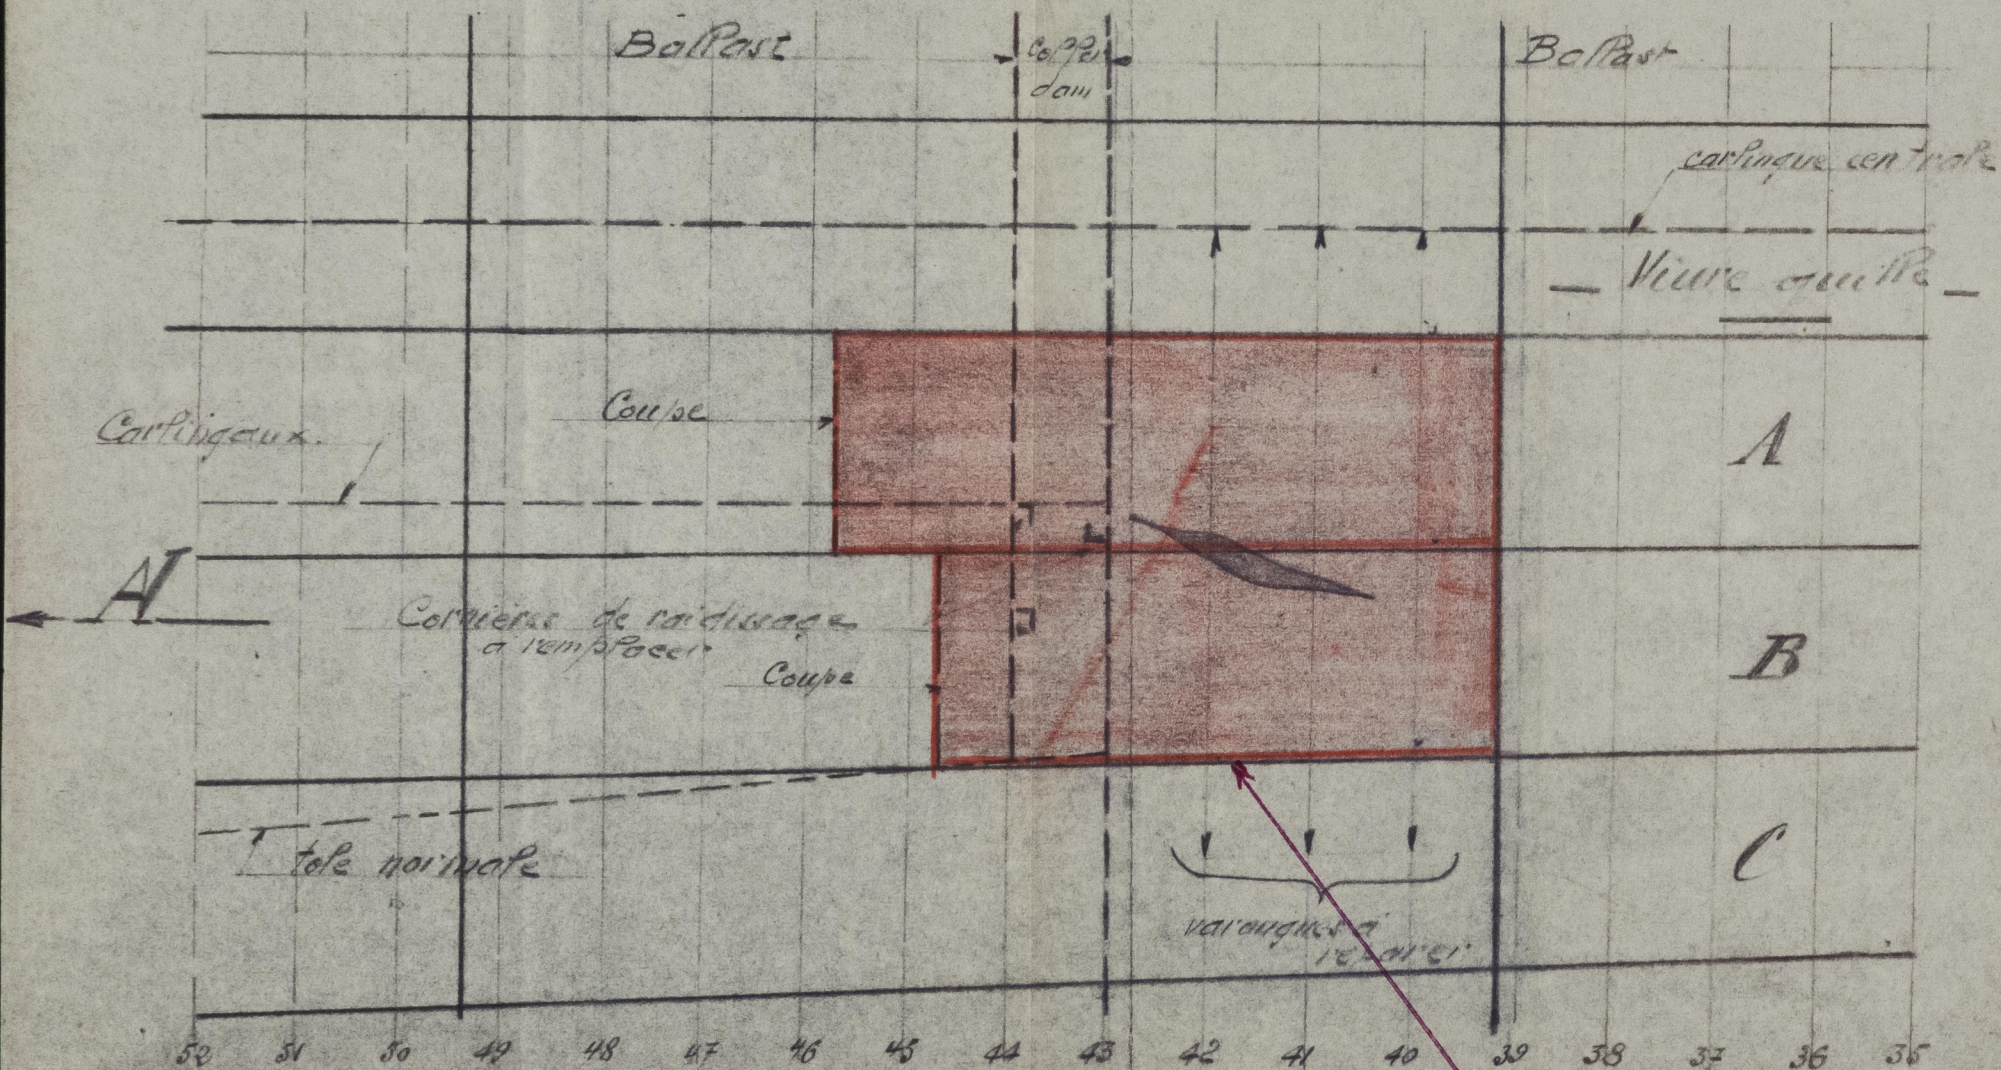


Plates on A & B strakes  
 cropped & part renewed

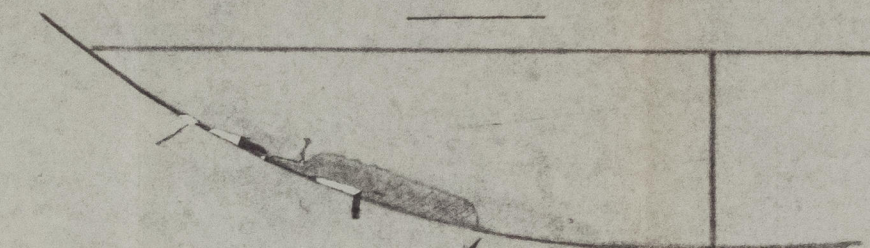


Partie supérieure  
 à Red. s/p. p. p.

Coupe 41

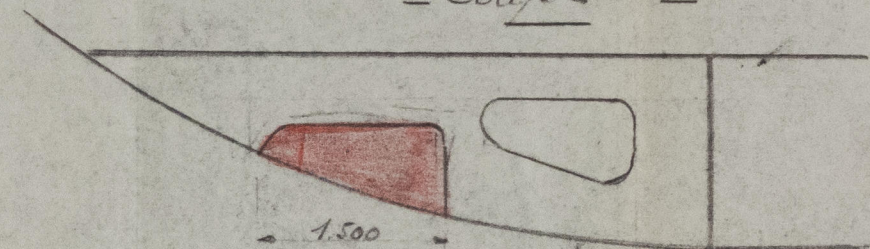


Coupe 42

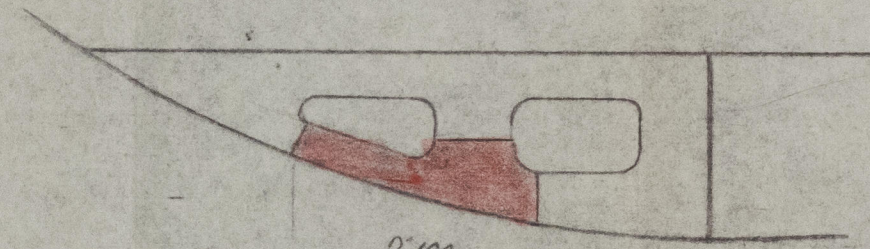

Donai

Remise en état du bord  
 B<sup>d</sup> R par le travers du balast

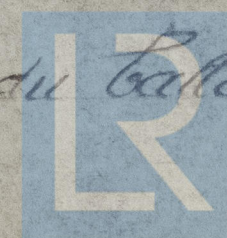

© 2021

Lloyd's Register  
 Foundation  
 18.552

012646-012655-0139



MS "

*Donai .*

"

ACCOMPANY.....*Has.* Rpt. No .....*9773*

Dated.....*11, 56.*

SUBJECT:- *Repairs to bottom platf.*



© 2021

Lloyd's Register  
Foundation

012646 - 012655 - 0139