


CARGO MOTORSHIP "HØEGH CLIPPER"

YARD № 960


SCALE 1:200

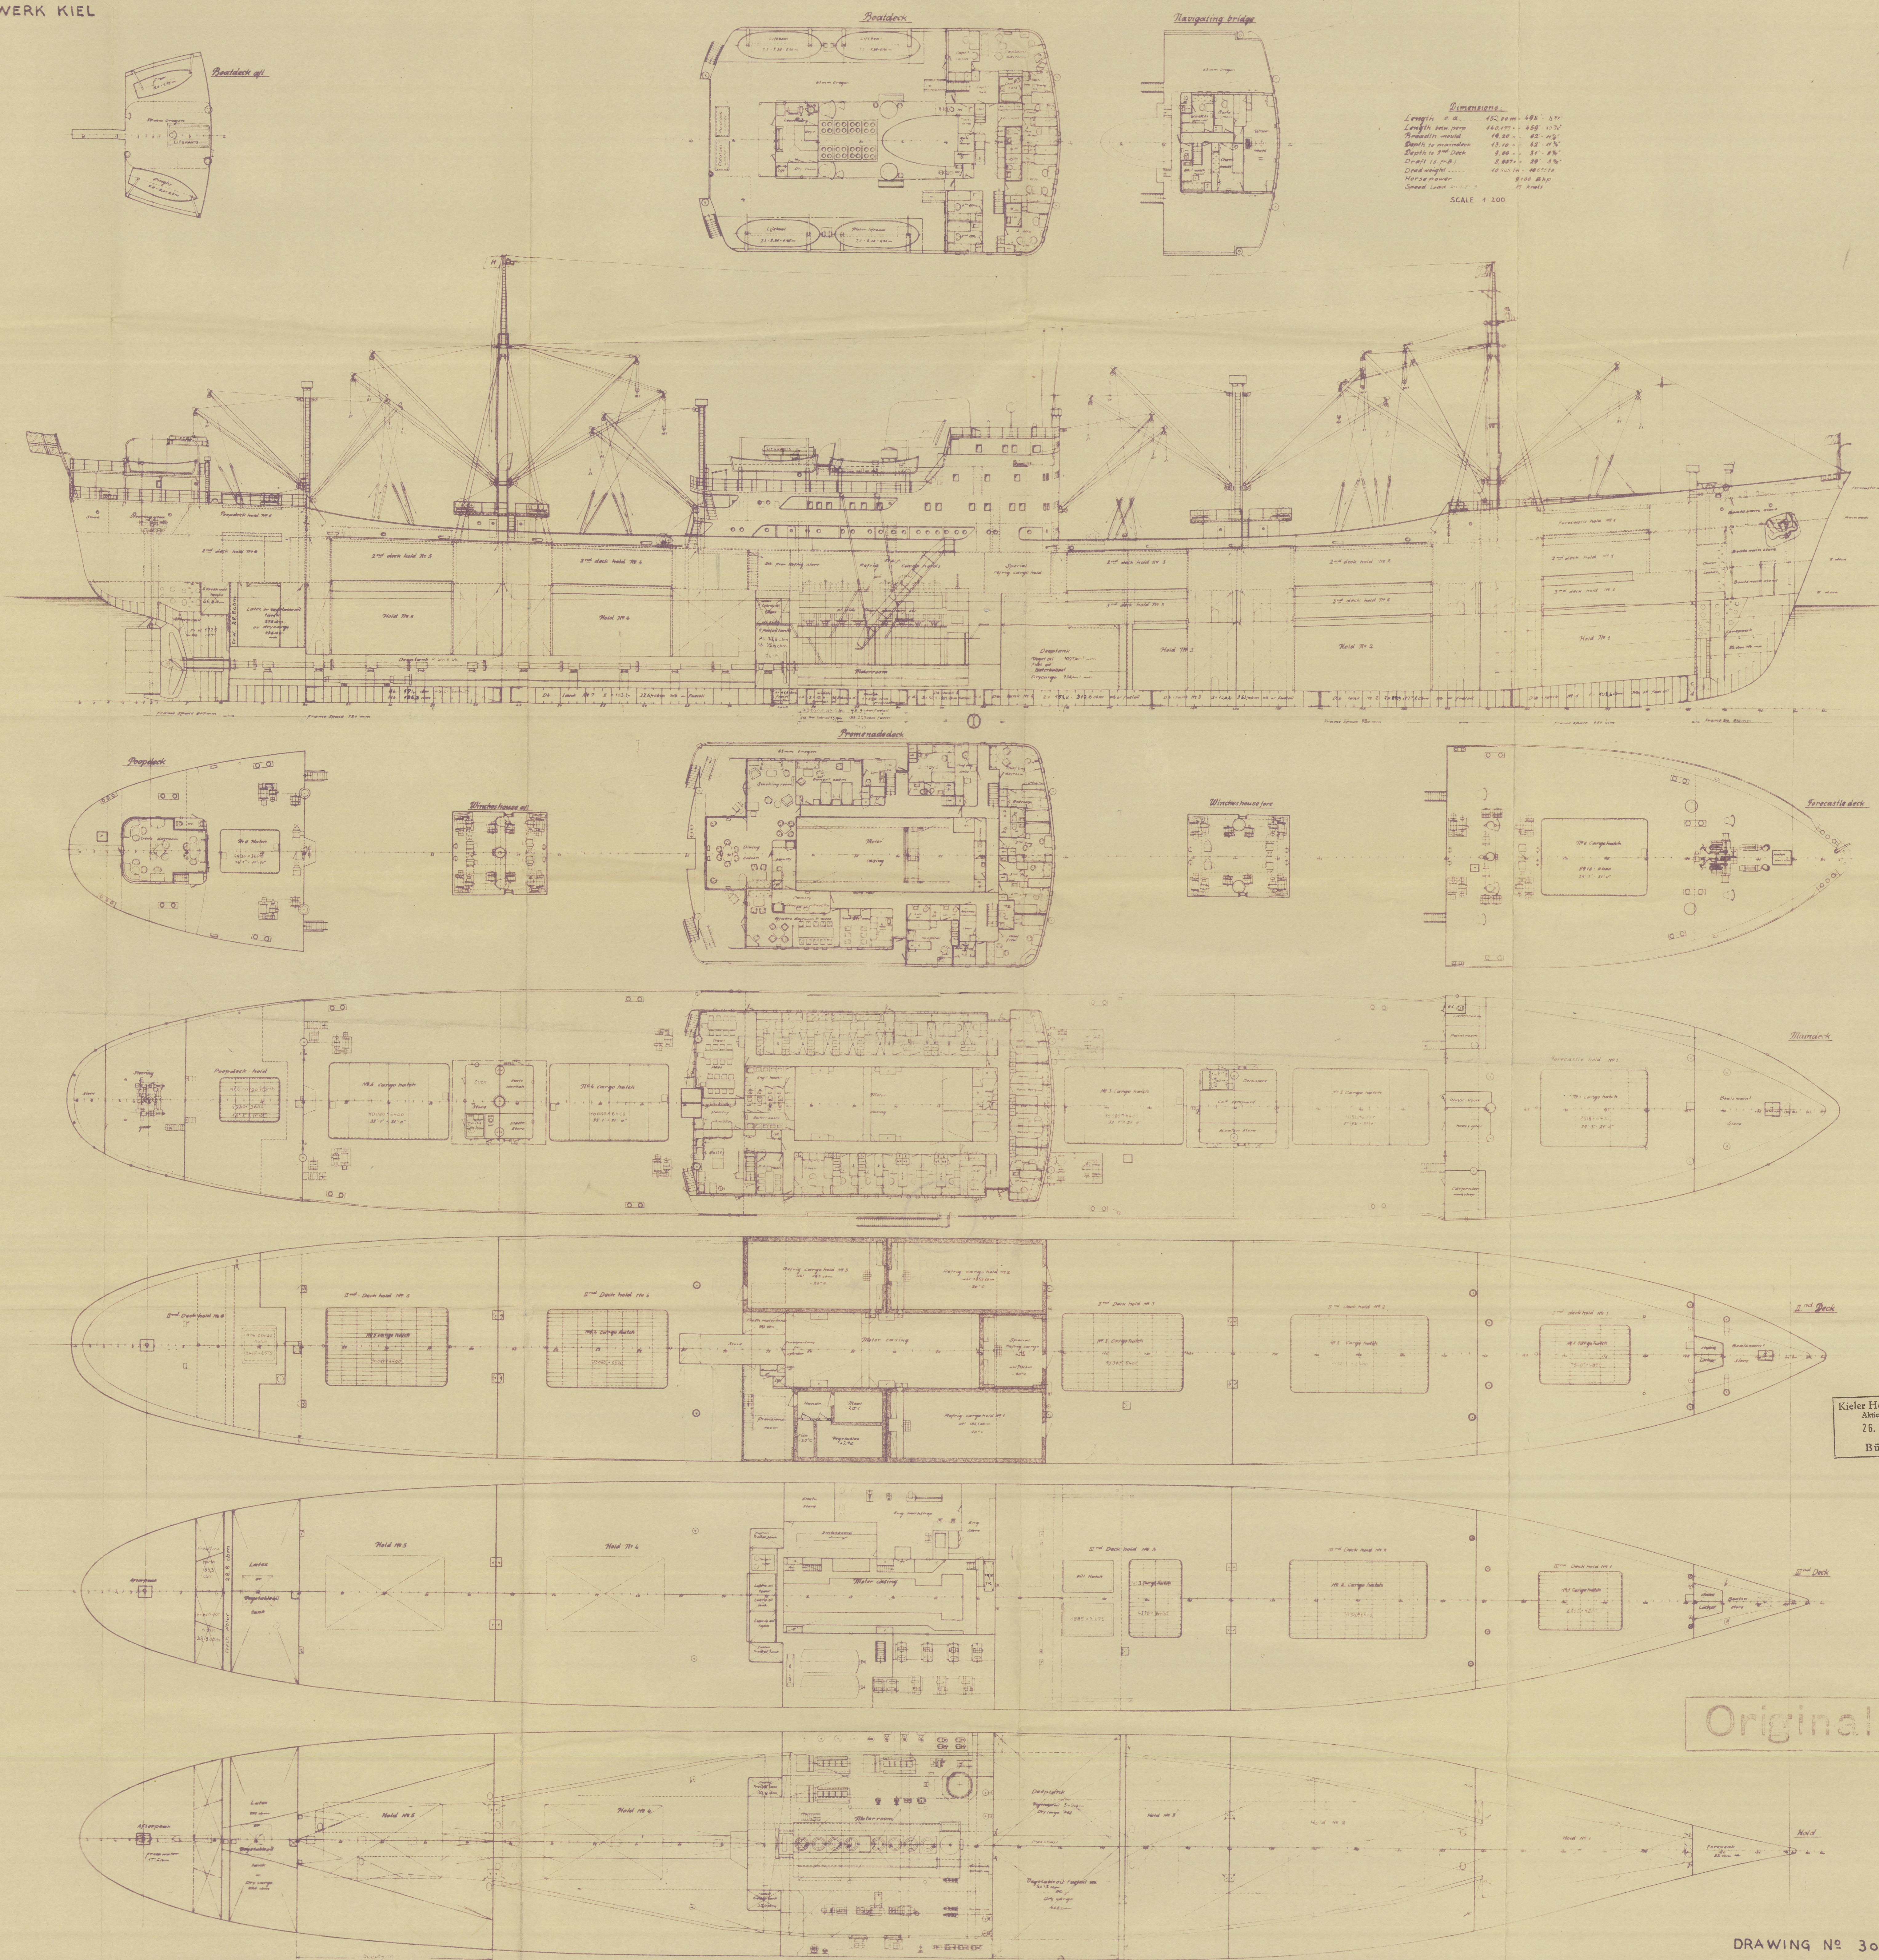

Kieler Howaldtswerke
Aktiengesellschaft
26. FEB. 1953
Büro SK

Original

DRAWING № 3000030

HØEGH CLIPPER ★


Howaldtswerke Kiel Yard No. 960

General Arrangement

Kiel Rpt. No. 794

As fitted

RECORDS DEPT.
LOND

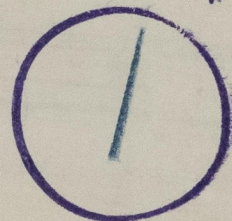

012646-012655-0168



© 2021

Lloyd's Register
Foundation