

SS "ANGLO INDIAN" PROFILE & DECKS

DIMENSIONS: LBP 426'0" MAXIMUM BREADTH MOULDED 61'2" DEPTH MOULDED 36'6" TO UPPER DECK
NORMAL BREADTH MOULDED 57'8"

SCALE: 1" = 10'0"

TO CLASS LLOYDS 100A1 WITH SPECIAL NOTATION

WITH A FREEBOARD CORRESPONDING TO A DRAUGHT NOT EXCEEDING THAT CONTEMPLATED BY THE RULES FOR A COMPLETE SUPERSTRUCTURE VESSEL HAVING A TONNAGE OPENING



ISHWOOD COMBINATION SYSTEM

ARCFORM PATENT

NOTE: ALL BULB ANGLES AND CHANNELS ARE 1924 NEW BRITISH STANDARD SECTIONS

MATS, WINCHES, WINDLASH STEERING GEAR SUPPORTED TO SUPERVISOR'S SATISFACTION

LODGE NUMBERS:-
L.O.D. = 426.305' = 15549
L.(B.O.) = 426.3766(36.5) = 40112
L.D. = 426.365' = 11.67

 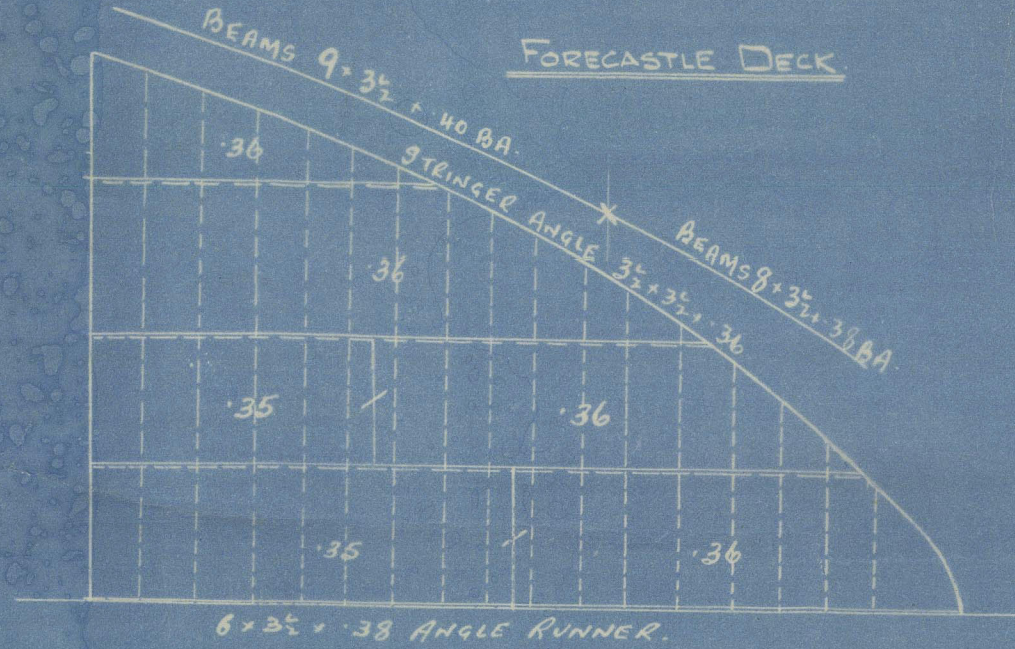

SHORT BROTHERS LTD
SHIPBUILDERS
SUNDERLAND

Shorts

453

Profile + Deeds

As built

N/N TACOMA CITY

"Clyde Indian"

32289.

"

1/2

INCHCASTLE

N/N

'LUCKY'



© 2021

Lloyd's Register
Foundation

012663-012668-0002