
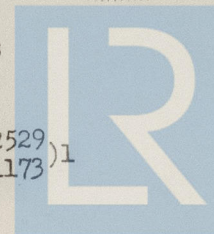


THE DISPOSITION DIAGRAM OF CRANKSHAFT MATERIAL

Takasago Inspection Section
Inspection Department
KOBE STEEL WORKS, LTD.

Engine Builder: Hitachi Shipbuilding & Engineering Co., Ltd. SAKURAJIMA SHIPYARD.
 Eng. No.: 2181 *Shp No 3976*
 Item: Built-up crankshaft for 874VT2BF 160 type diesel engine:
 Identification marks on the crankshaft: KOB No. KT-CK 552

Material used:

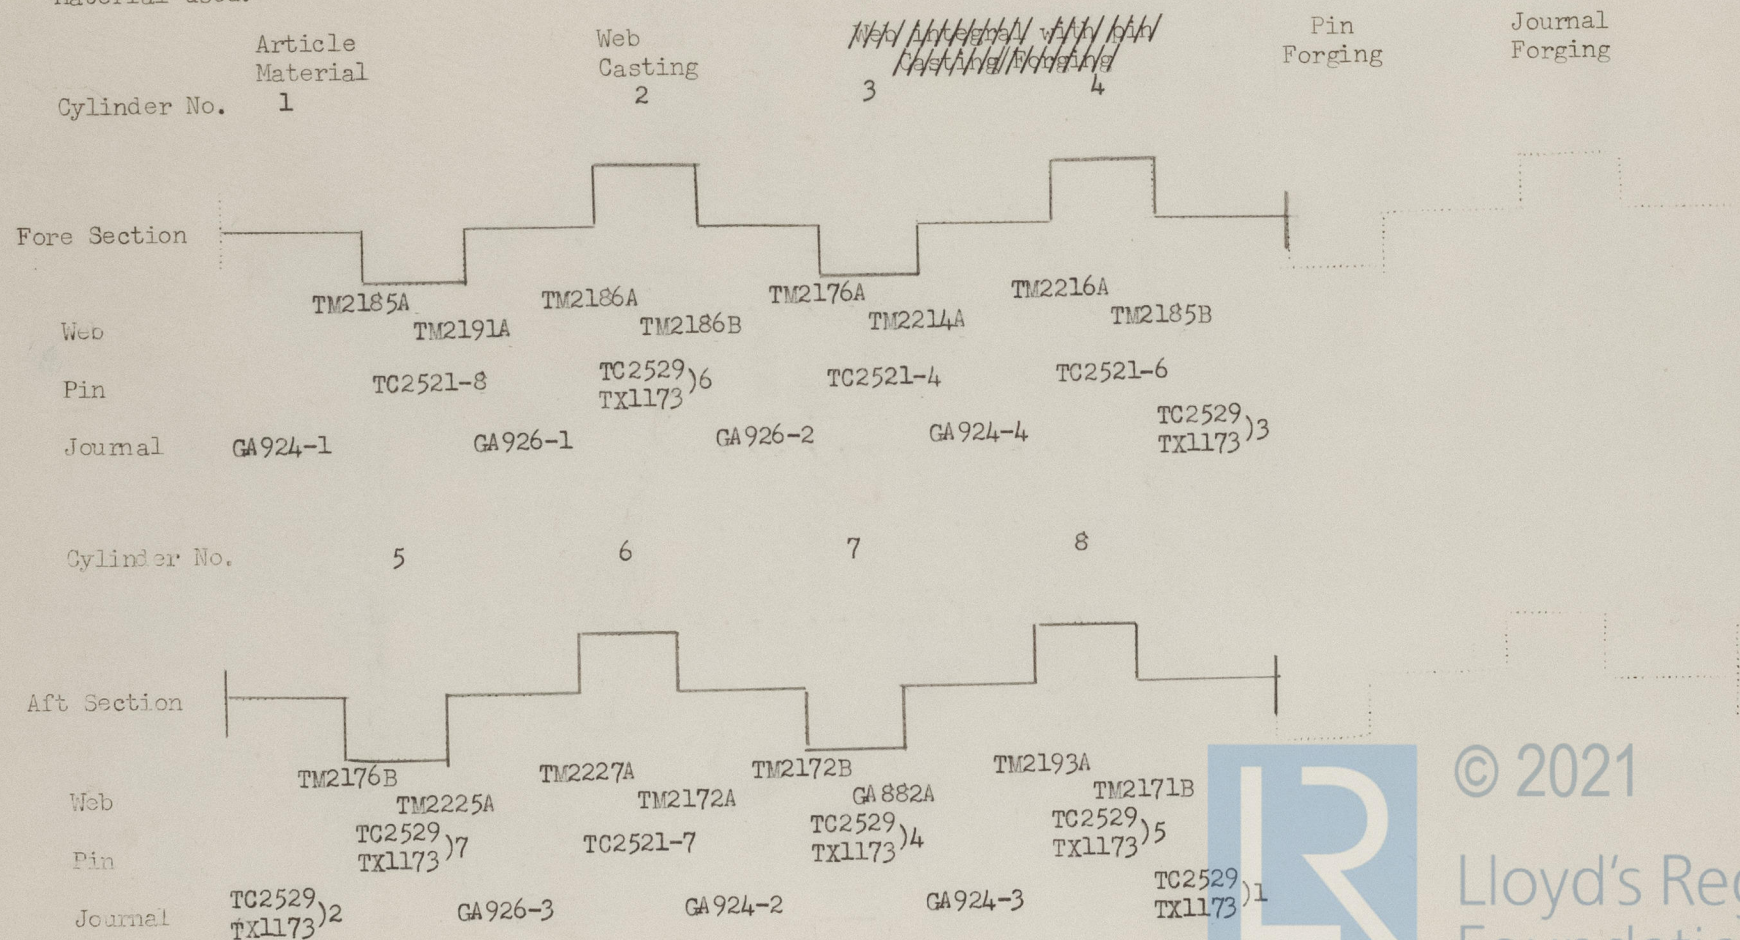

© 2021

Lloyd's Register
Foundation

012722-012727-0031