


# 350 TON ALL WELDED SEAGOING BARGE. FOR SERVICE AT CHITTAGONG.

Rule 45 (B)  
PL 40 + 2 1/2 0.

## MID SECTION - (PRELIMINARY).

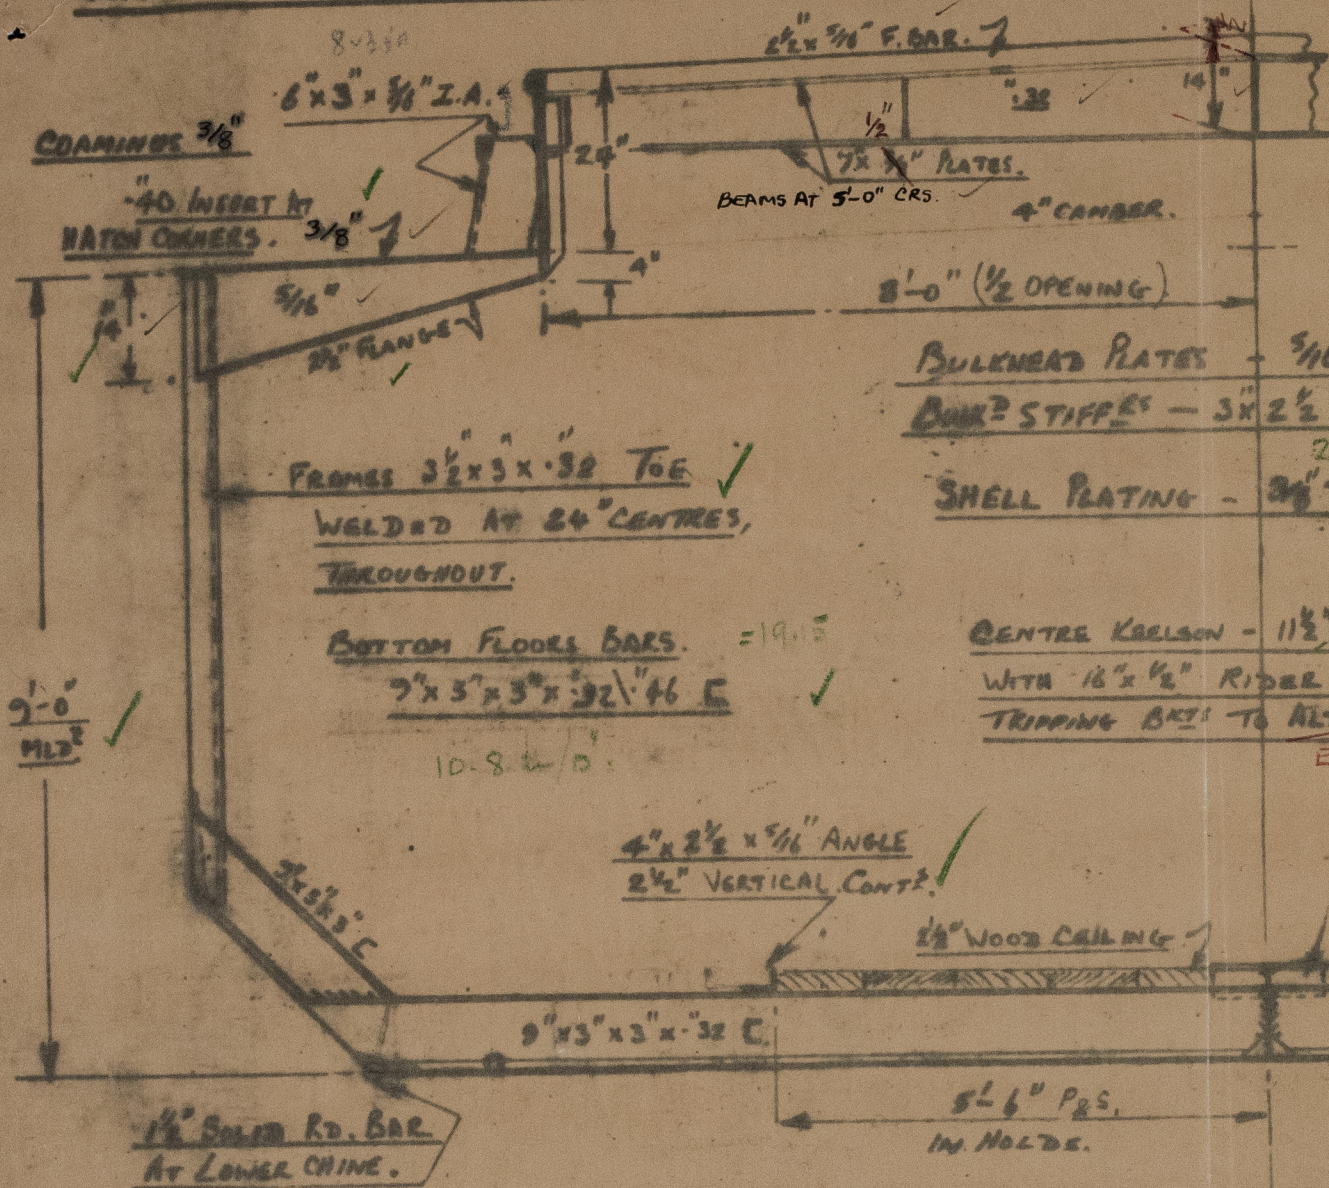


L.O.A. 115'-4"  
L.B.P. 114'-0"  
BEAM. 24'-0"  
DEPTH. 9'-0"  
SERVICE DRAUGHT. 7'-3"

BULKHEAD PLATES - 3/16"  
BULK STIFFERS - 3x2 1/2 x 1/4" TOE WELDED.  
24" SPACING?  
SHELL PLATING - 3/16" THROUGHOUT.

EQUIPMENT LETTER 'a'.

CENTRE KEELSON - 11 1/2 x 3/8" CONTINUOUS.  
WITH 16 x 1/2" RIDER TOP PLATE.  
TRIPPING BKT TO ALTERNATE FLOOR.  
EVERY

TRIPPING BKT 5/16" PL.

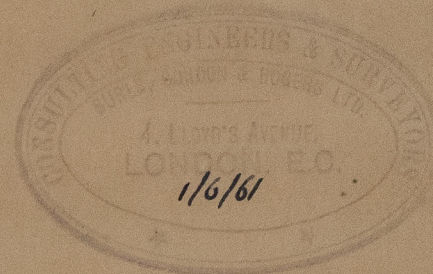

OFFICE



Lloyd's Register Foundation  
012734.012743.0054