

LLOYD'S REGISTER OF SHIPPING


Index No.
(For London Office only.)

SURVEYS FOR FREEBOARD

(CONDITIONS OF ASSIGNMENT)

Ship's Name UNITED SIX Port of Survey KARACHI
 Official Number Surveyor's Signature KS Boothman for J MACLEOD.
 Nationality and Port of Registry PAKISTAN CHITTAGONG Date of Survey WHILST BUILDING

Disposition and dimensions of superstructures, trunks, deckhouses, machinery casings and wood sheathing to be inserted in the diagrams and tabular statement :-

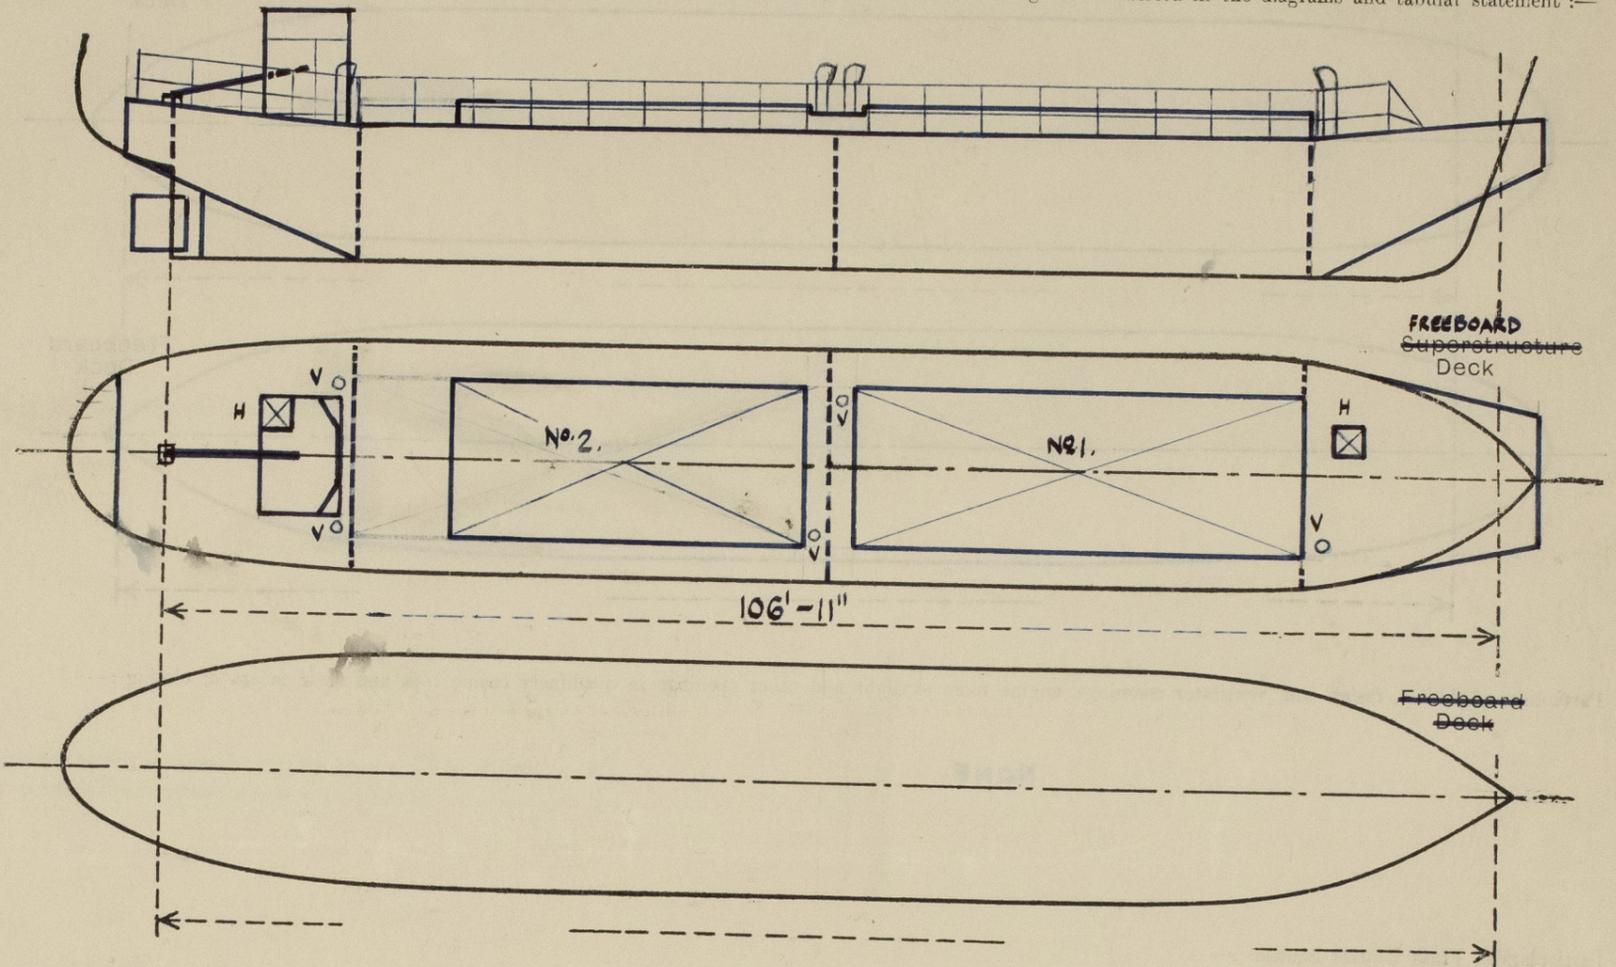

Particulars of Superstructures, Trunks, Casings, Deckhouses.


	Coaming	Plating	Stiffeners	Spacing	End Attachments of Stiffeners	Size of Openings	Height of Sills	Height, Beam to Beam
Poop Bulkhead								
Raised Quarter Deck Bulkhead ...								
Bridge, After Bulkhead								
Bridge, Forward Bulkhead								
Forecastle Bulkhead								
Trunk, Aft								
Trunk, Forward								
Exposed Machinery Casings on Freeboard or Raised Quarter Decks ...								
Exposed Machinery Casings on Superstructure Decks								
Machinery Casings within Superstructures not fitted with Class I Closing Appliances								
Deckhouses and Pump Room Entrances								

Particulars of Closing Appliances (state if capable of being manipulated from both sides).

Poop Bulkhead	
Raised Quarter Deck Bulkhead ...	
Bridge, After Bulkhead	
Bridge, Forward Bulkhead	
Forecastle Bulkhead	
Exposed Machinery Casings on Freeboard or Raised Quarter Decks ...	
Exposed Machinery Casings on Superstructure Decks	
Machinery Casings within Superstructures not fitted with Class I Closing Appliances	
Deckhouses and Pump Room Entrances	

PARTICULARS OF PROTECTION TO OPENINGS, ETC.

The following diagrams should be used to indicate the positions of cargo and coaling hatchways, gangway, cargo and coaling ports, side scuttles, scuppers, ventilators, companionways, etc., which would affect the seaworthiness of the ship :-

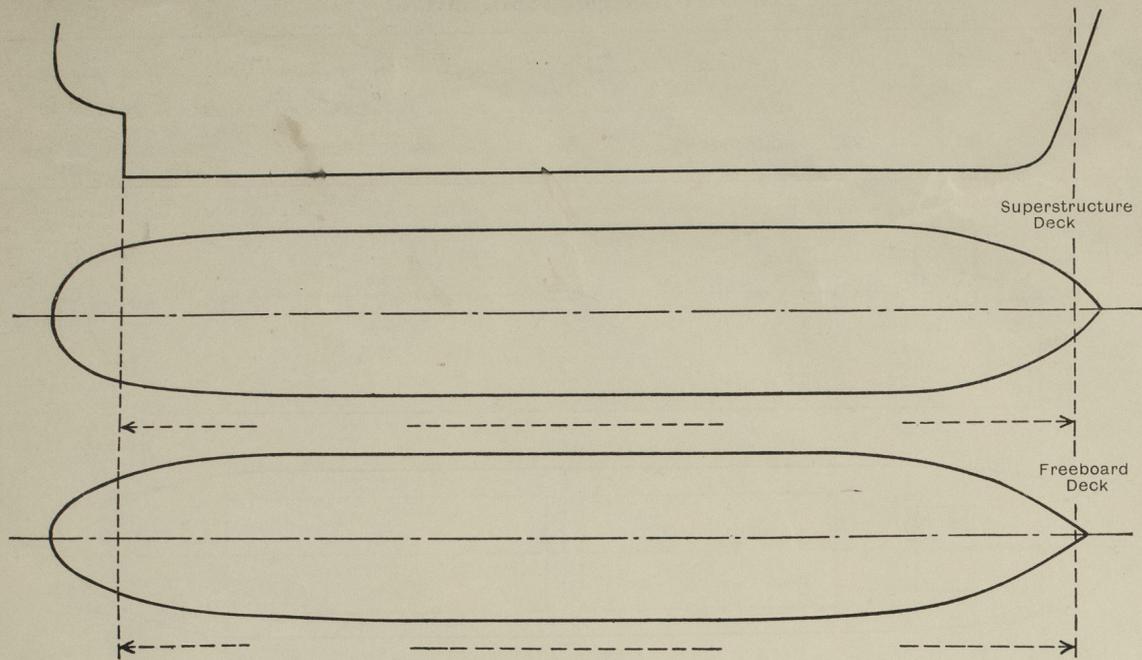

Particulars of fiddley, funnel and ventilator coamings, engine room skylight and other openings in machinery casing tops and their means of closing :-

NONE.

Particulars of Flush Bunker Scuttles :-

NONE.

Particulars of Companionways :-
(including those incorporated in deckhouses and masthouses)

NONE.

Particulars of Ventilators in exposed positions on freeboard and superstructure decks :-

5 IN NUMBER 7" DIA & 3/8" COAMINGS 36" HIGH. FITTED WITH WOOD PLUGS AND CANVAS COVERS.

Particulars of Air Pipes in exposed positions on freeboard, raised quarter, or superstructure decks :-

NONE.

Particulars of Gangway Cargo and Coaling Ports :-

NONE.

Particulars of Scuppers and Sanitary Discharge Pipes :-

NONE.

Particulars of Side Scuttles and Deadlights :-

NONE.

Vertical distance of Sill of lowest Side Scuttle above top of keel ✓

Distance from amidships to centre of lowest Side Scuttle ✓

Particulars of Guard Rails and Bulwarks :-

FITTED ALL AROUND.
STANCHIONS 36" HIGH, 1 1/2" DIA M.S. TUBE. SPACED 5'-0" APART.
RAILS - TWO - F.S.W.R. ✓

Particulars of Gangways, Lifelines, etc. :-

NONE.

Particulars of Freeing Arrangements.

	Length of Bulwark	Height of Bulwark	Size of Freeing Ports	Number each side	Area each side	Rule area each side
After Well						
Forward Well						

State position of each freeing port { After Well :-
(F. and A. position and height above deck edge) { Forward Well :-

State whether the freeing ports are fitted with shutters, bars, or rails, and give particulars of such :-

Additional area where sheer is less than standard.

NONE.

United Co.

PARTICULARS OF PROTECTION TO OPENINGS, ETC.

HATCHWAYS ON FREEBOARD AND SUPERSTRUCTURE DECKS.					
Description of Hatchway	No. 1.	No. 2.	ACCESS FORWARD.	ACCESS AFT.	
Dimensions of Hatchway	40' x 16'	28'-8" x 16'	2' x 2'	2' x 2'	
COAMINGS	Height above Deck	24"	24"	6"	6"
	Thickness	3/8"	3/8"	3/8"	3/8"
	Stiffeners	8" x 3" x 35" B.A.	8" x 3" x 35" B.A.	-	-
	Brackets, Stays	6" x 3" x 5/16" O.A.	6" x 3" x 5/16" O.A.	-	-
HATCH BEAMS	Number	6	4	NONE.	
	Spacing	5-7 1/2'	5-7 1/2'		
	Scantling and Sketch				
Bearing Surface	3 3/8"	3 3/8"			
FORE AND AFTERS	Number	NONE.			
	Spacing				
	Unsupported Lengths				
Bearing Surface					
HATCH COVERS	Material	WOOD	WOOD	STEEL	STEEL
	Thickness	2 1/2"	2 1/2"	3/8"	3/8"
	How fitted	F&A.	F&A.	W.T.	W.T.
	Bearing Surface	3"	3"	-	-
Spacing of Cleats	24"	24"	TOGGLES	TOGGLES.	
Number of Tarpaulins	2	2	-	-	
*Are wood fore and afters steel shod at all bearing surfaces? <input checked="" type="checkbox"/> YES. Are battens and wedges efficient and in good condition? <input checked="" type="checkbox"/> YES. Are tarpaulins in good condition and in accordance with rule requirements? <input checked="" type="checkbox"/> YES. Are lashings provided in accordance with rule requirements? <input checked="" type="checkbox"/> YES. Are wood covers fitted with galvanised end bands? <input checked="" type="checkbox"/> YES.					

Particulars of any special features:— (Timber Deck-cargo Fittings, Skylights, Sewage Systems, Ash Ejectors, Rubbish Shoots, etc.)



© 2021

Lloyd's Register Foundation