












DRAWING N^o 22

BUILDING N^{os} 2002-3 & 2007

BOSS PLATING & BOSS FRAMING

SCALE = 1/2" = 1 FOOT

Office copy

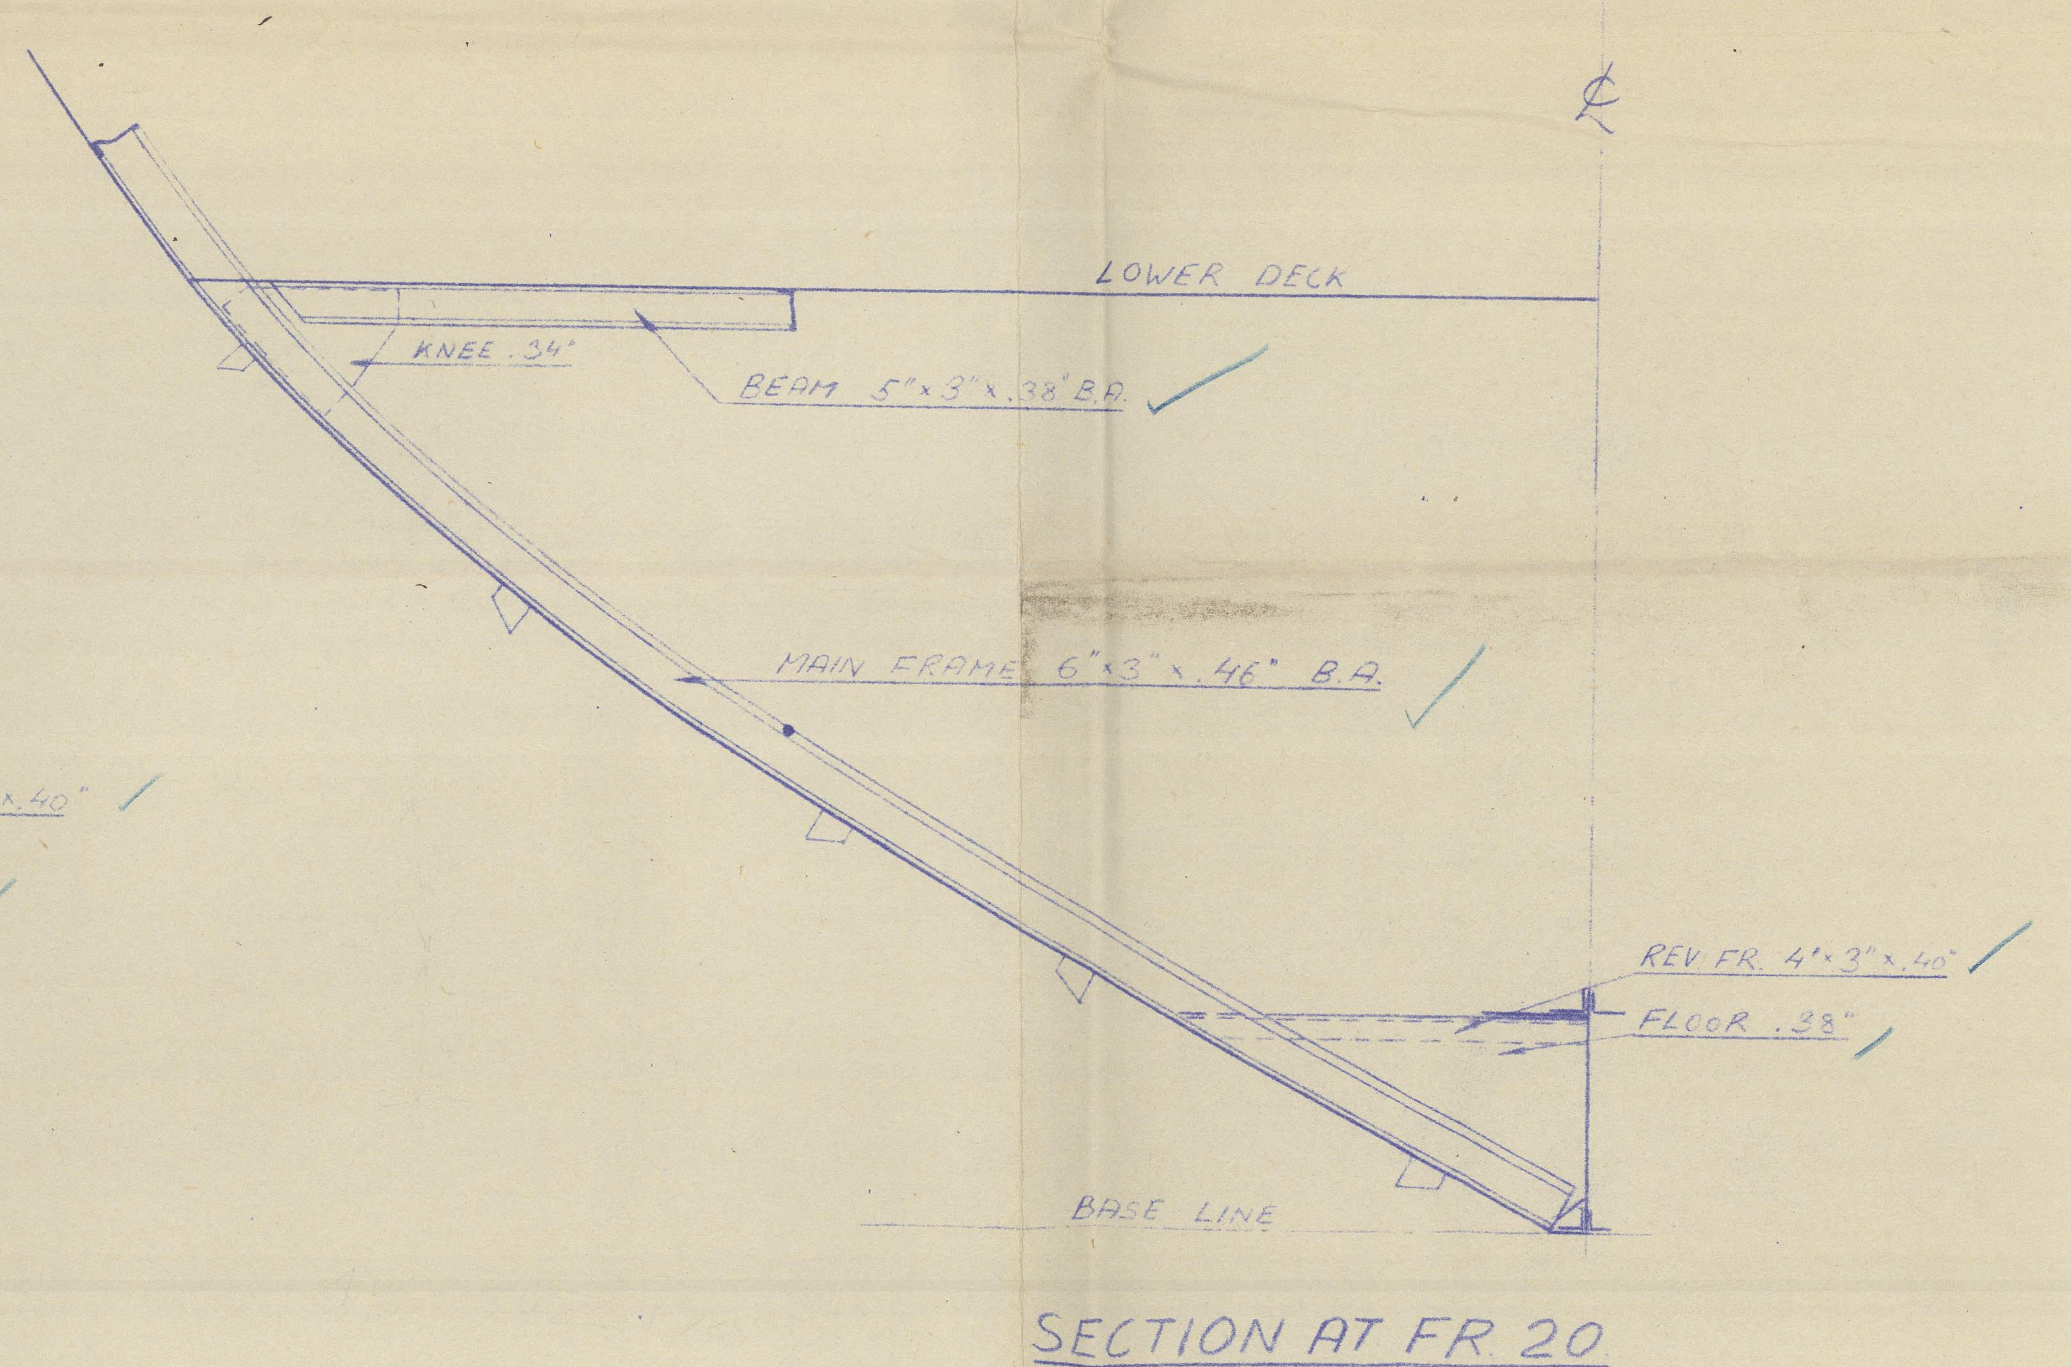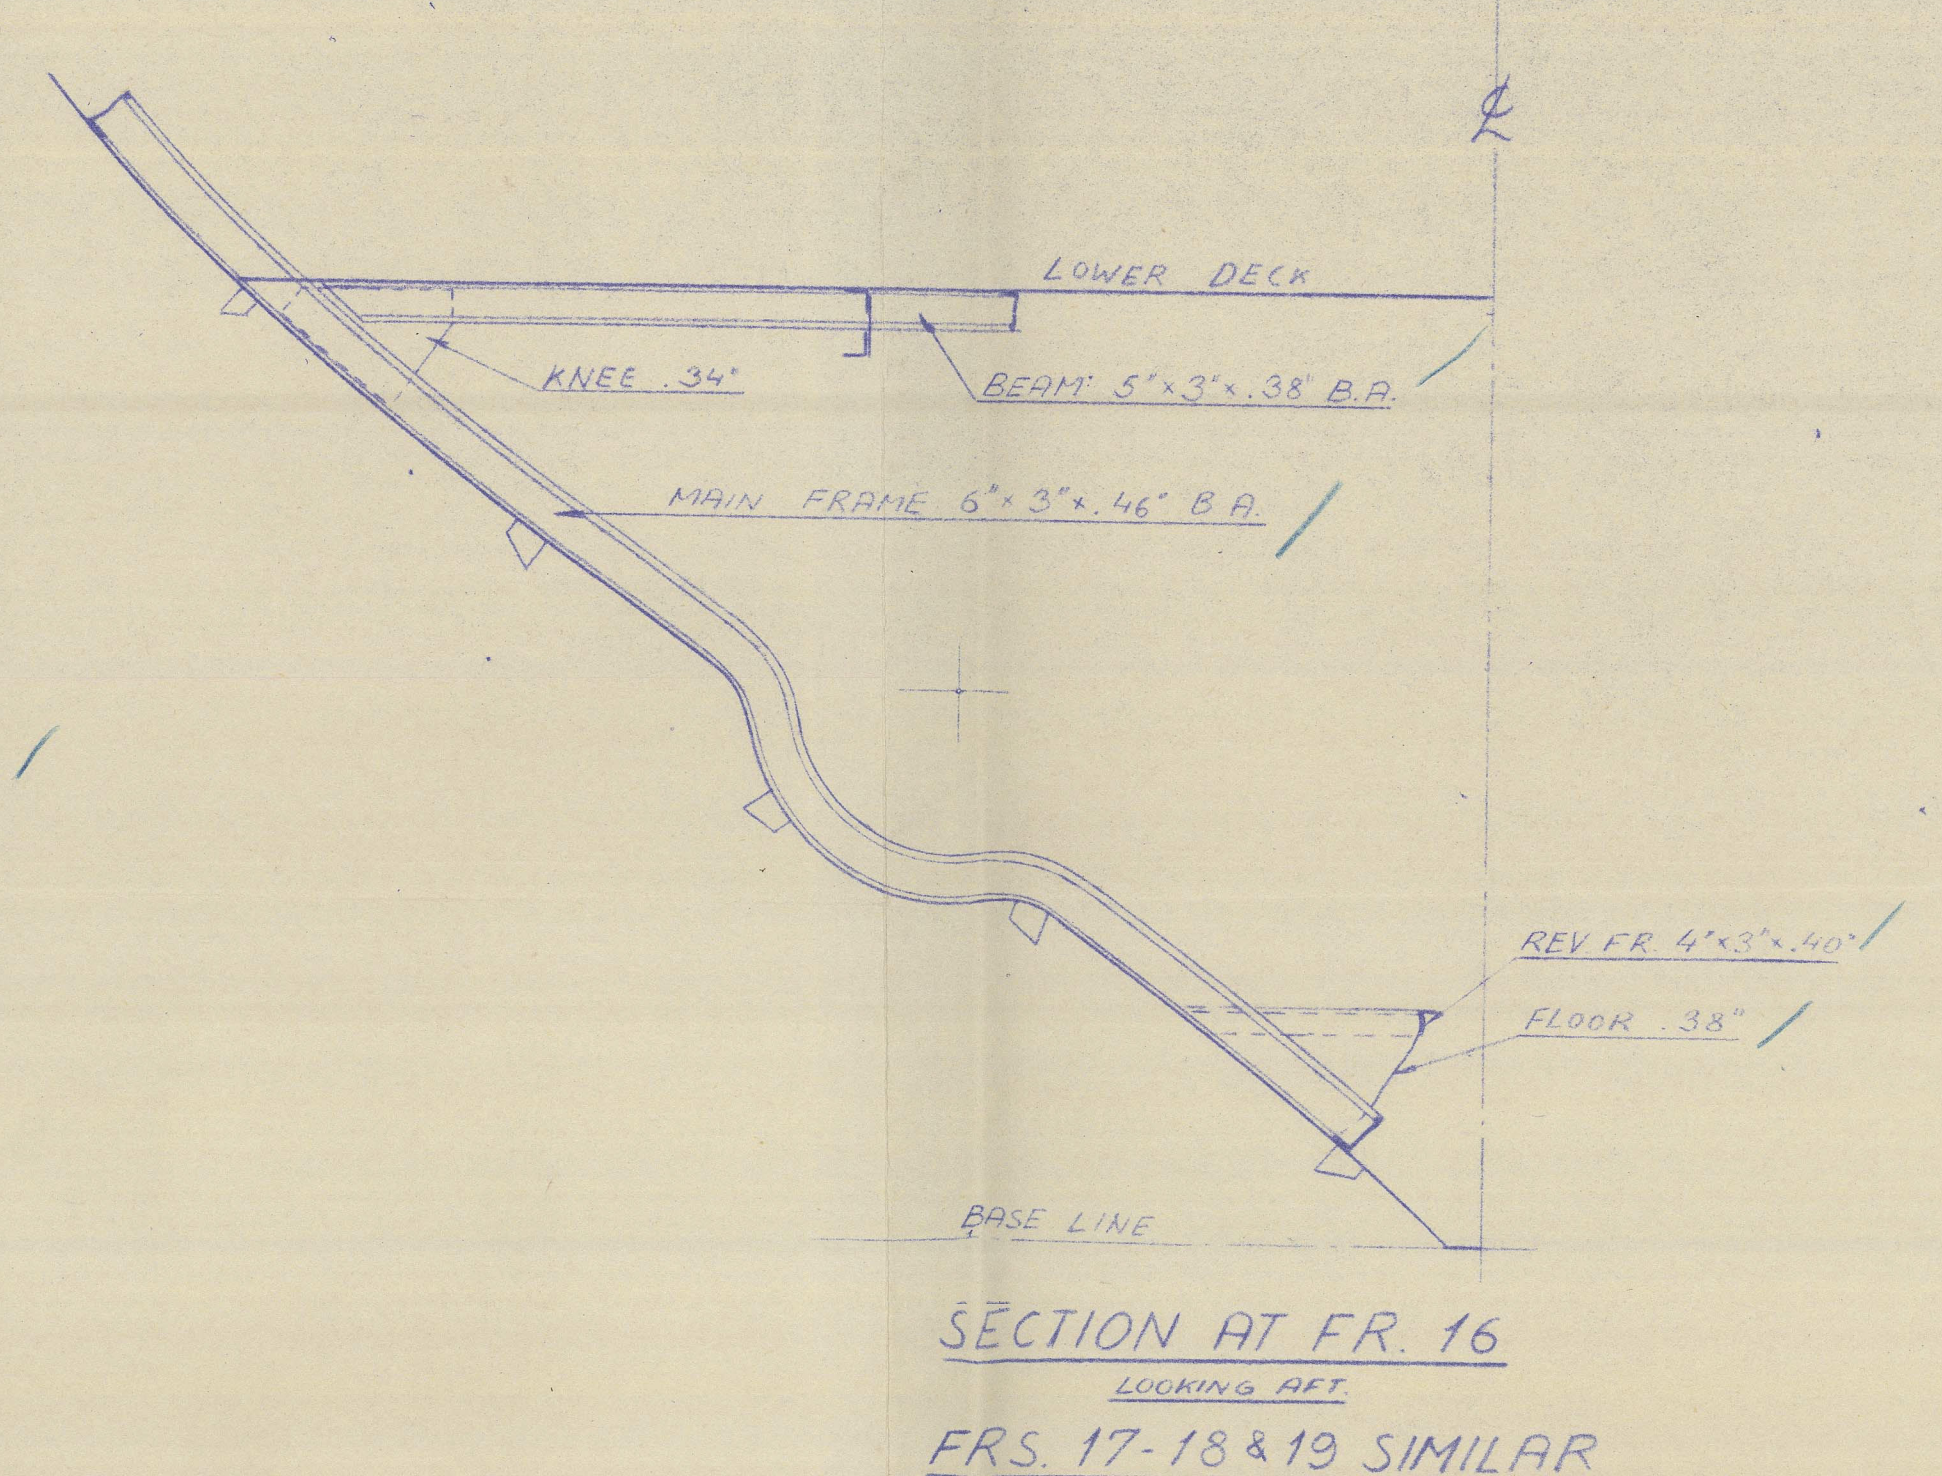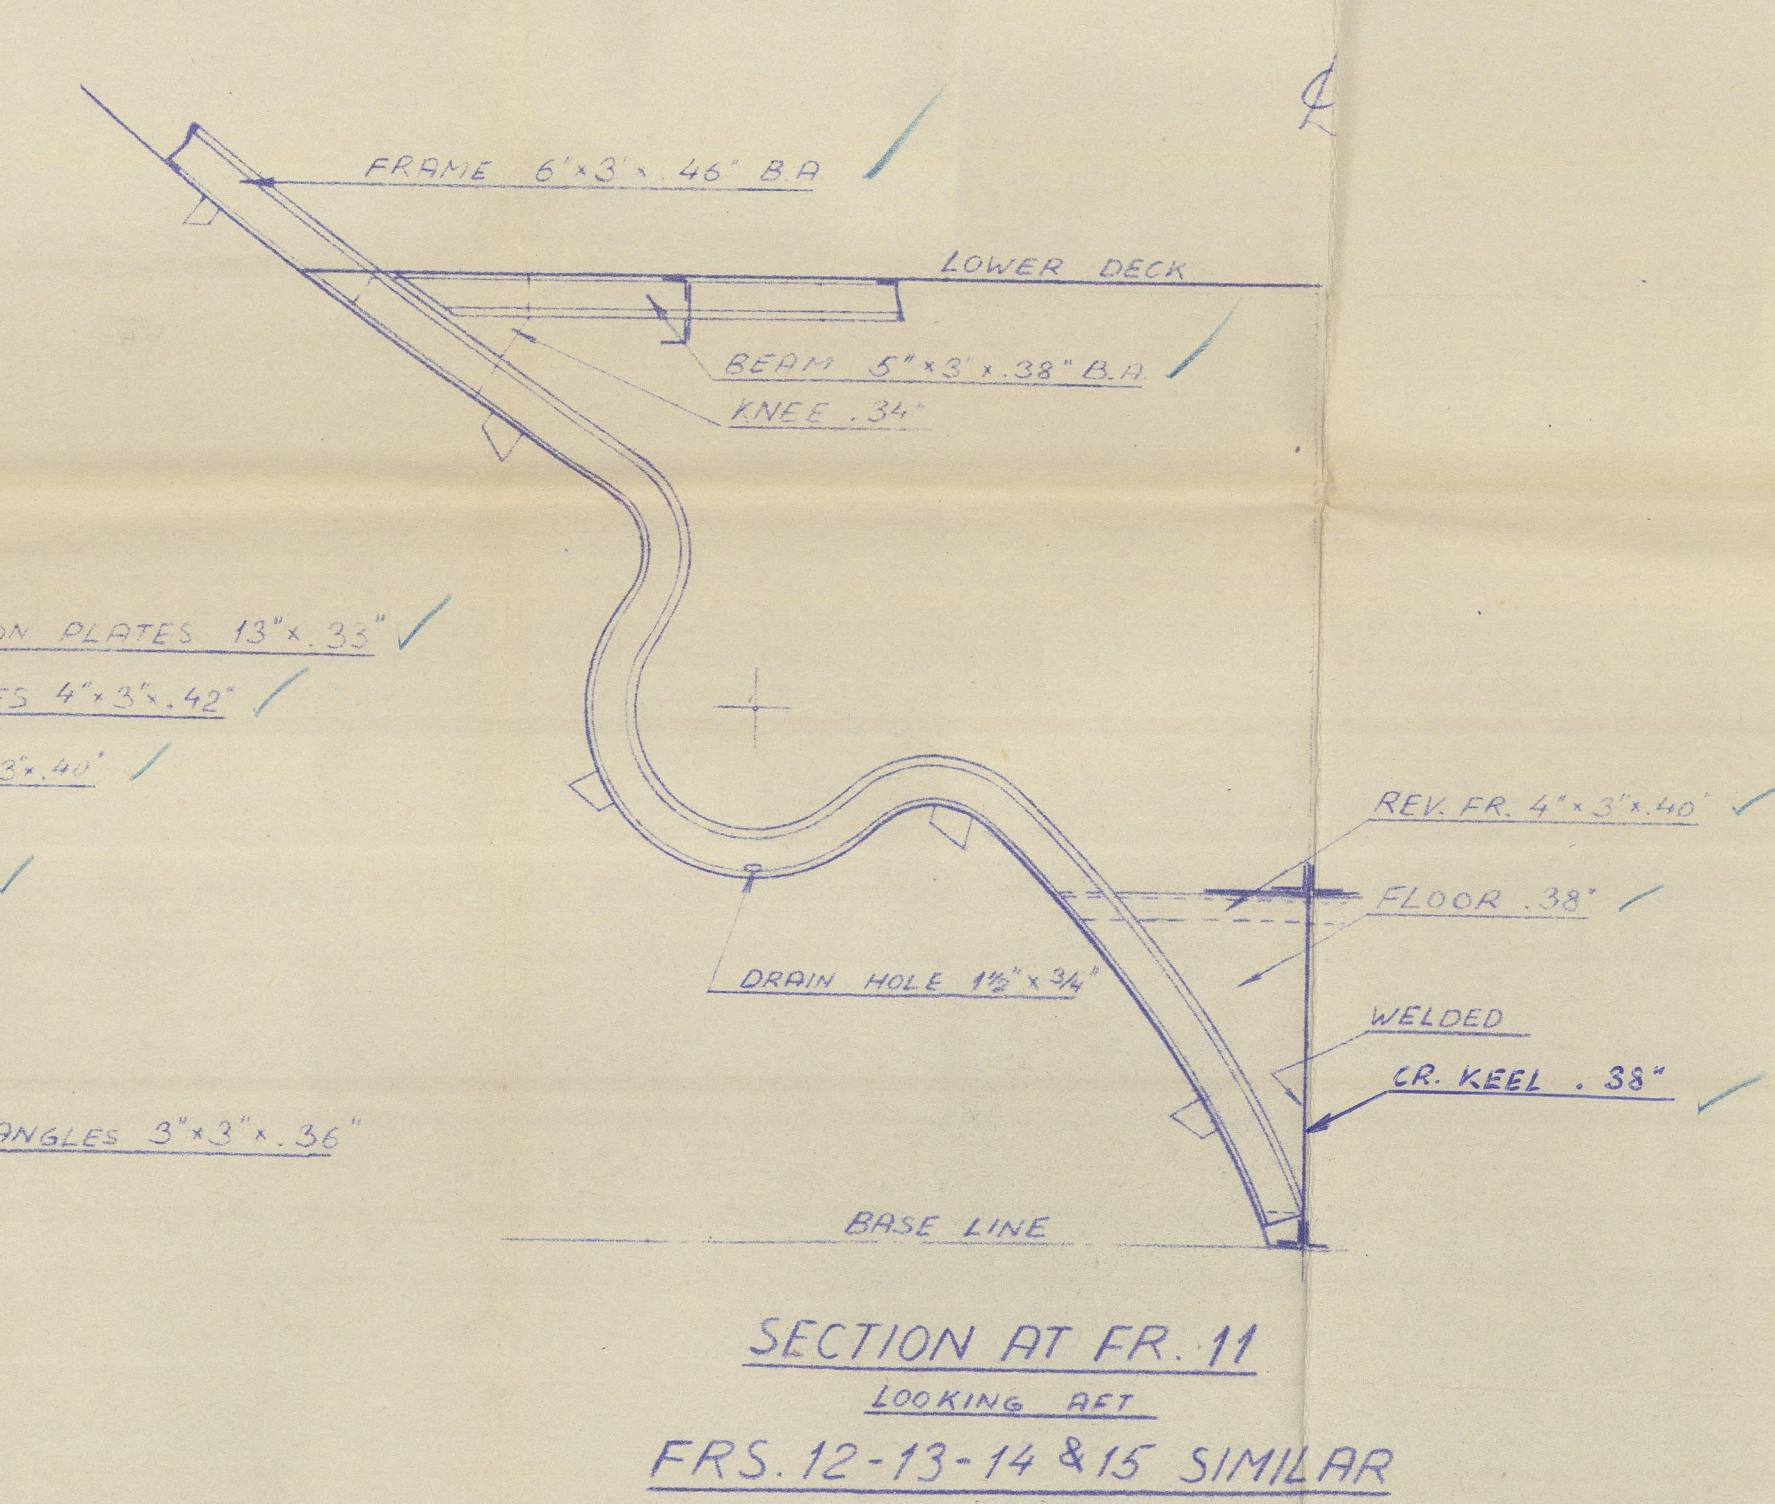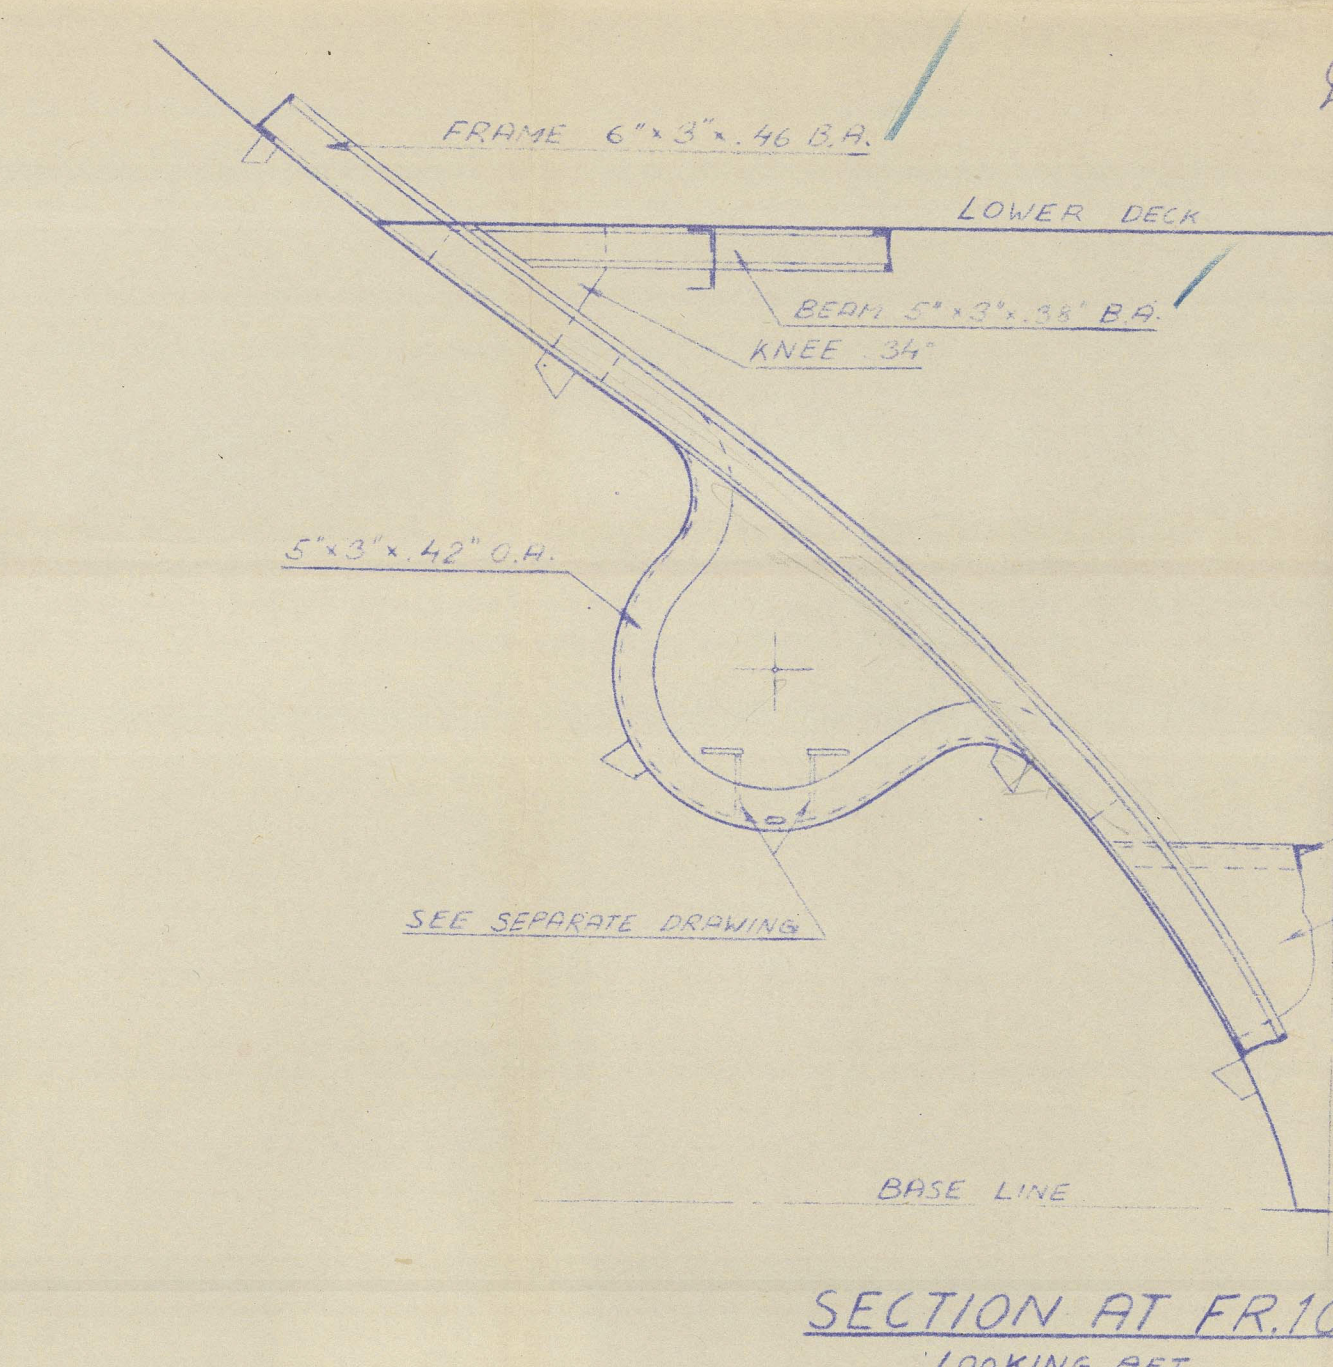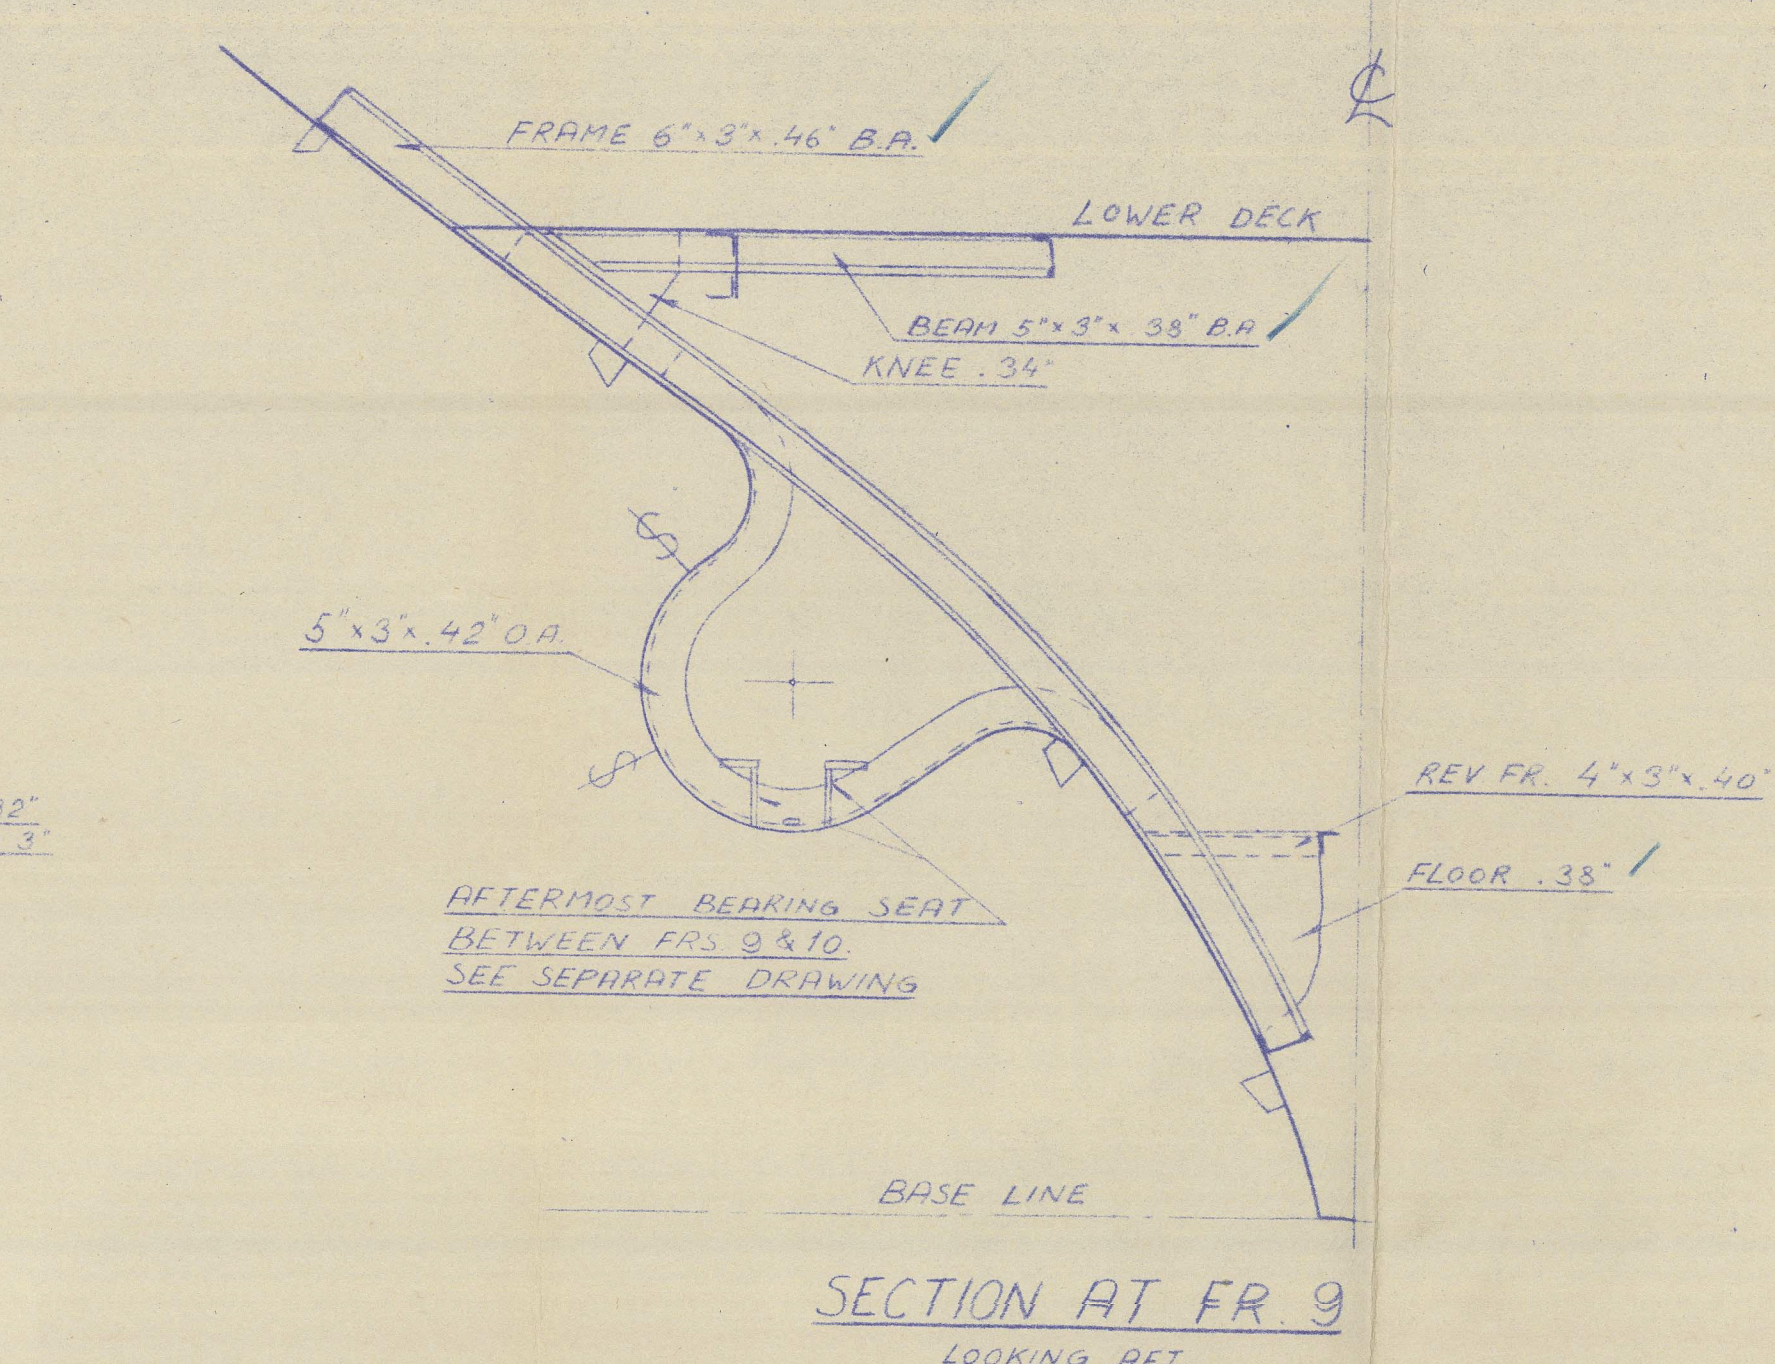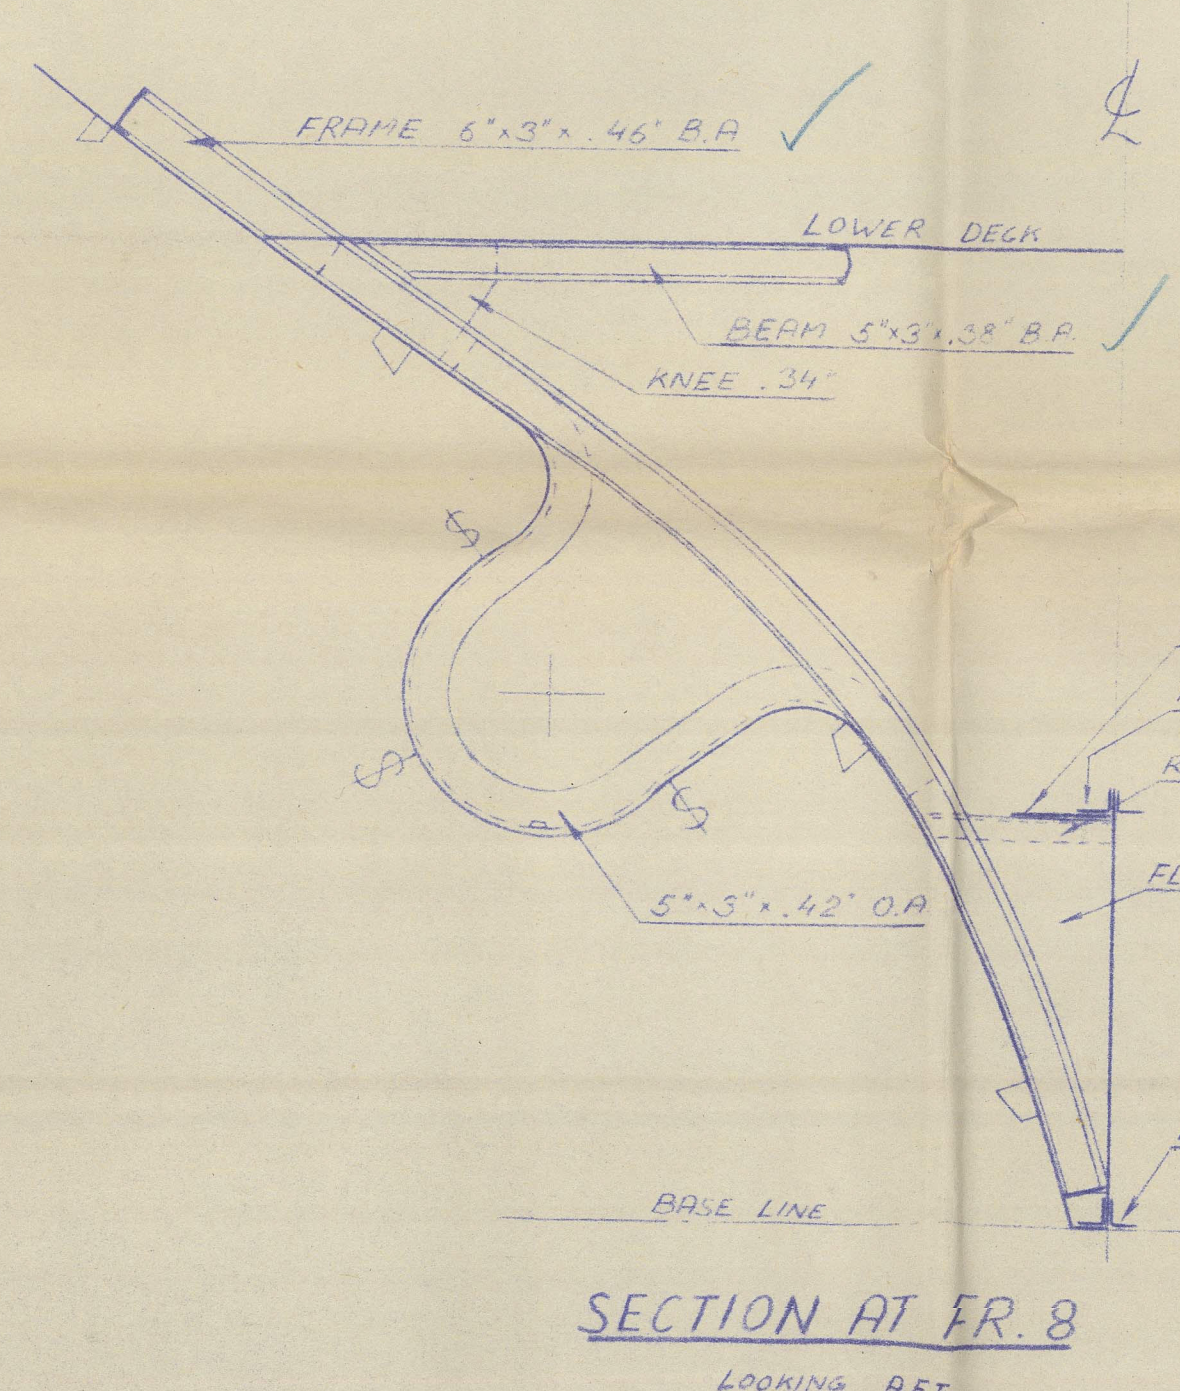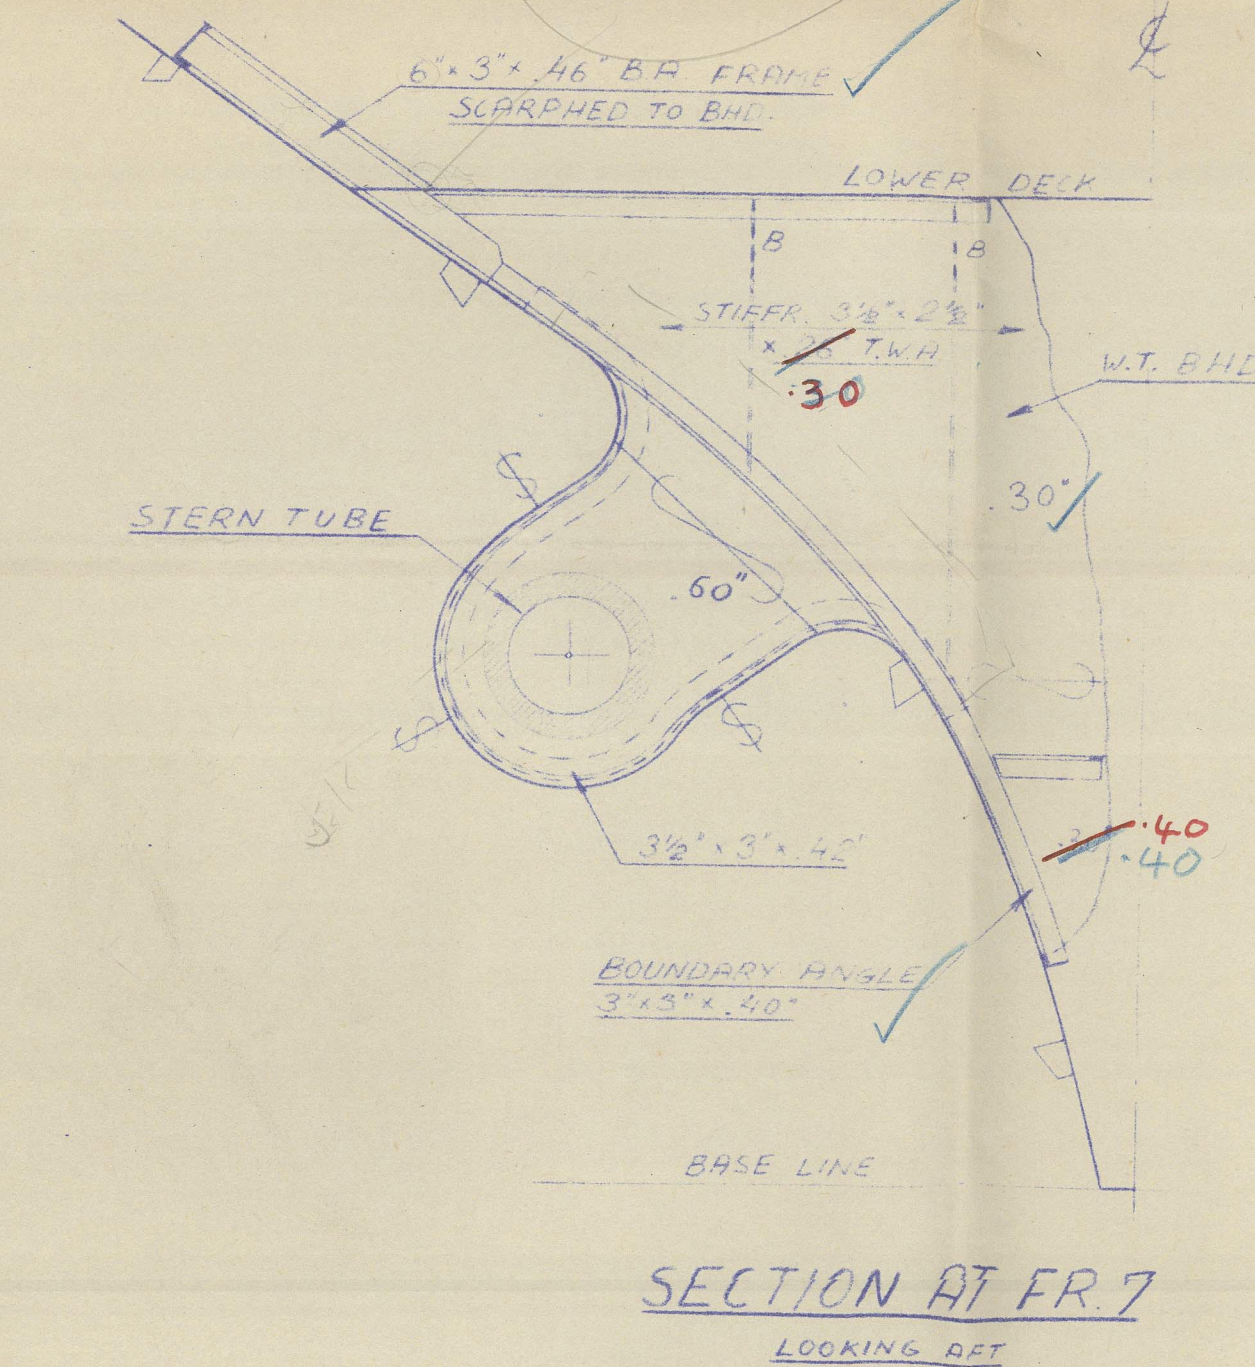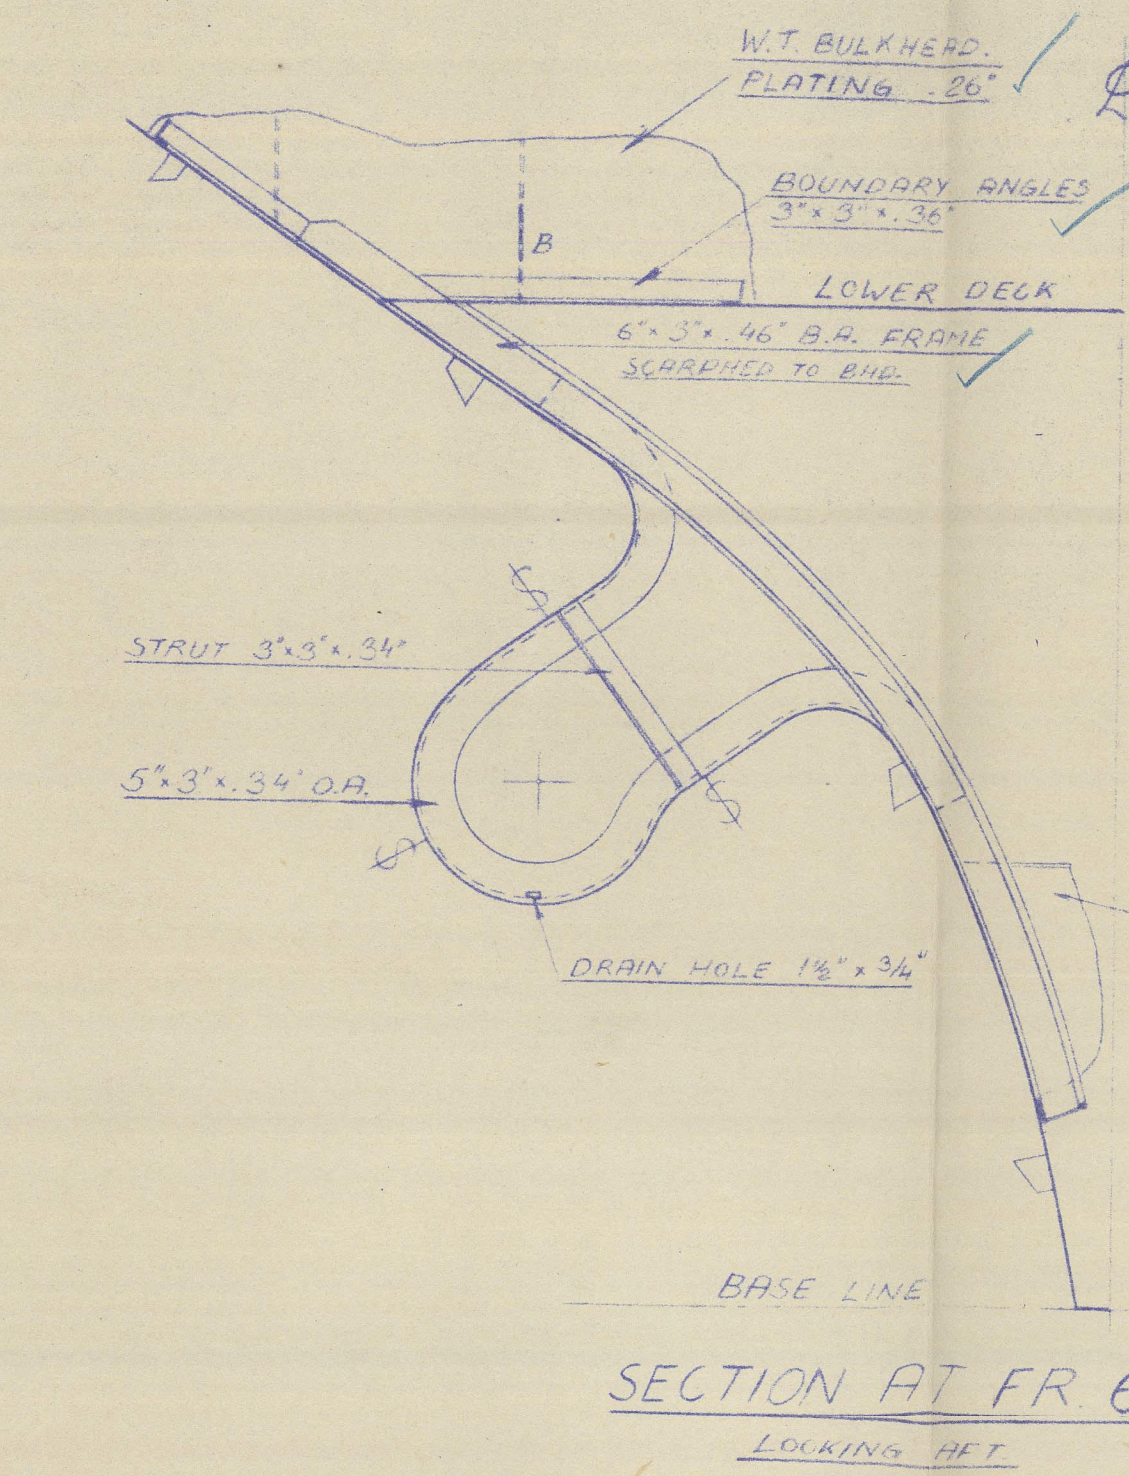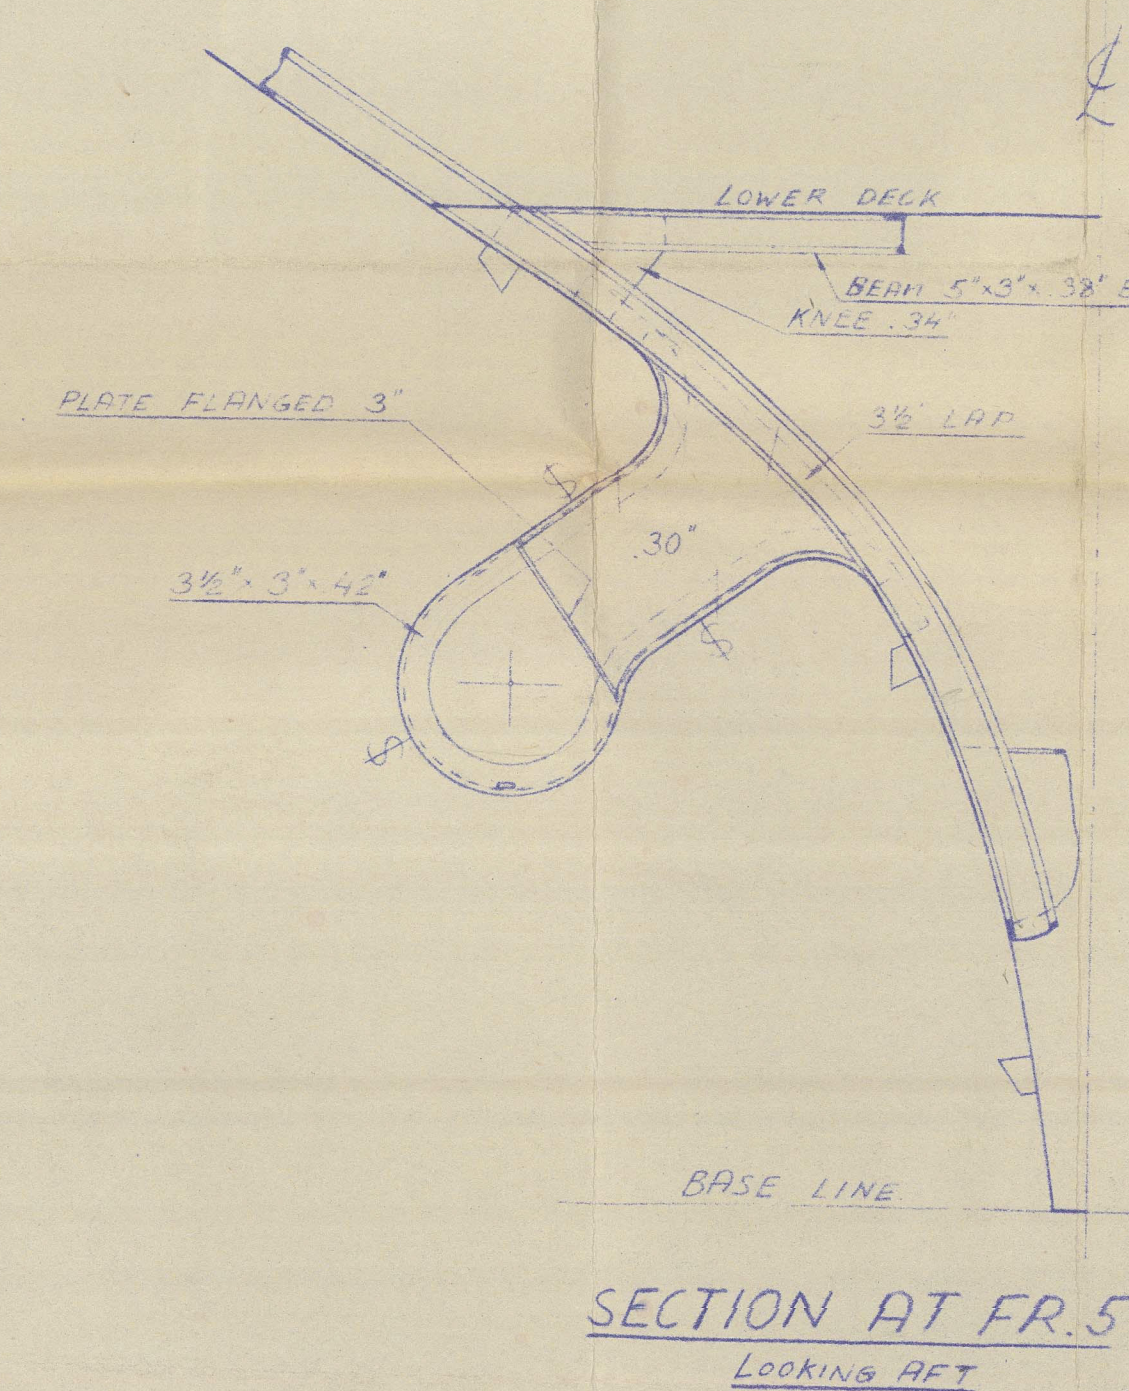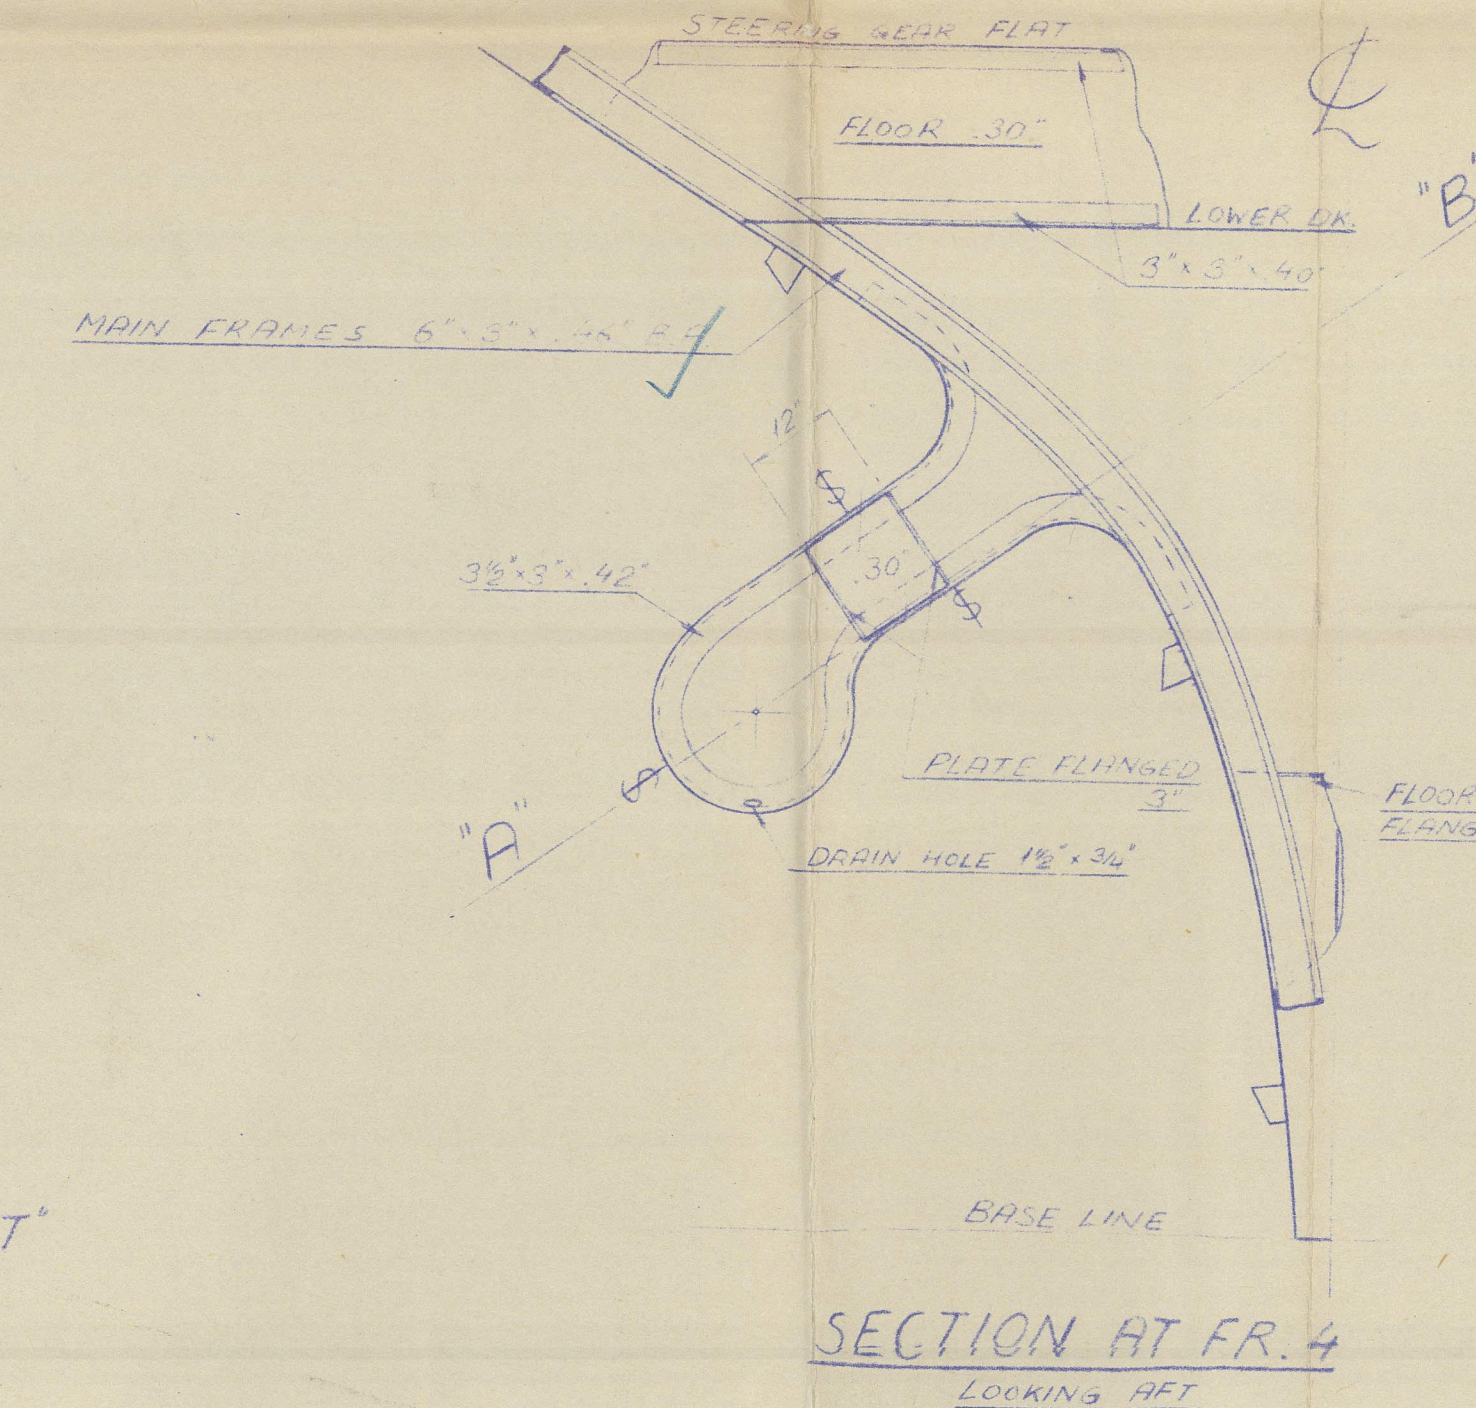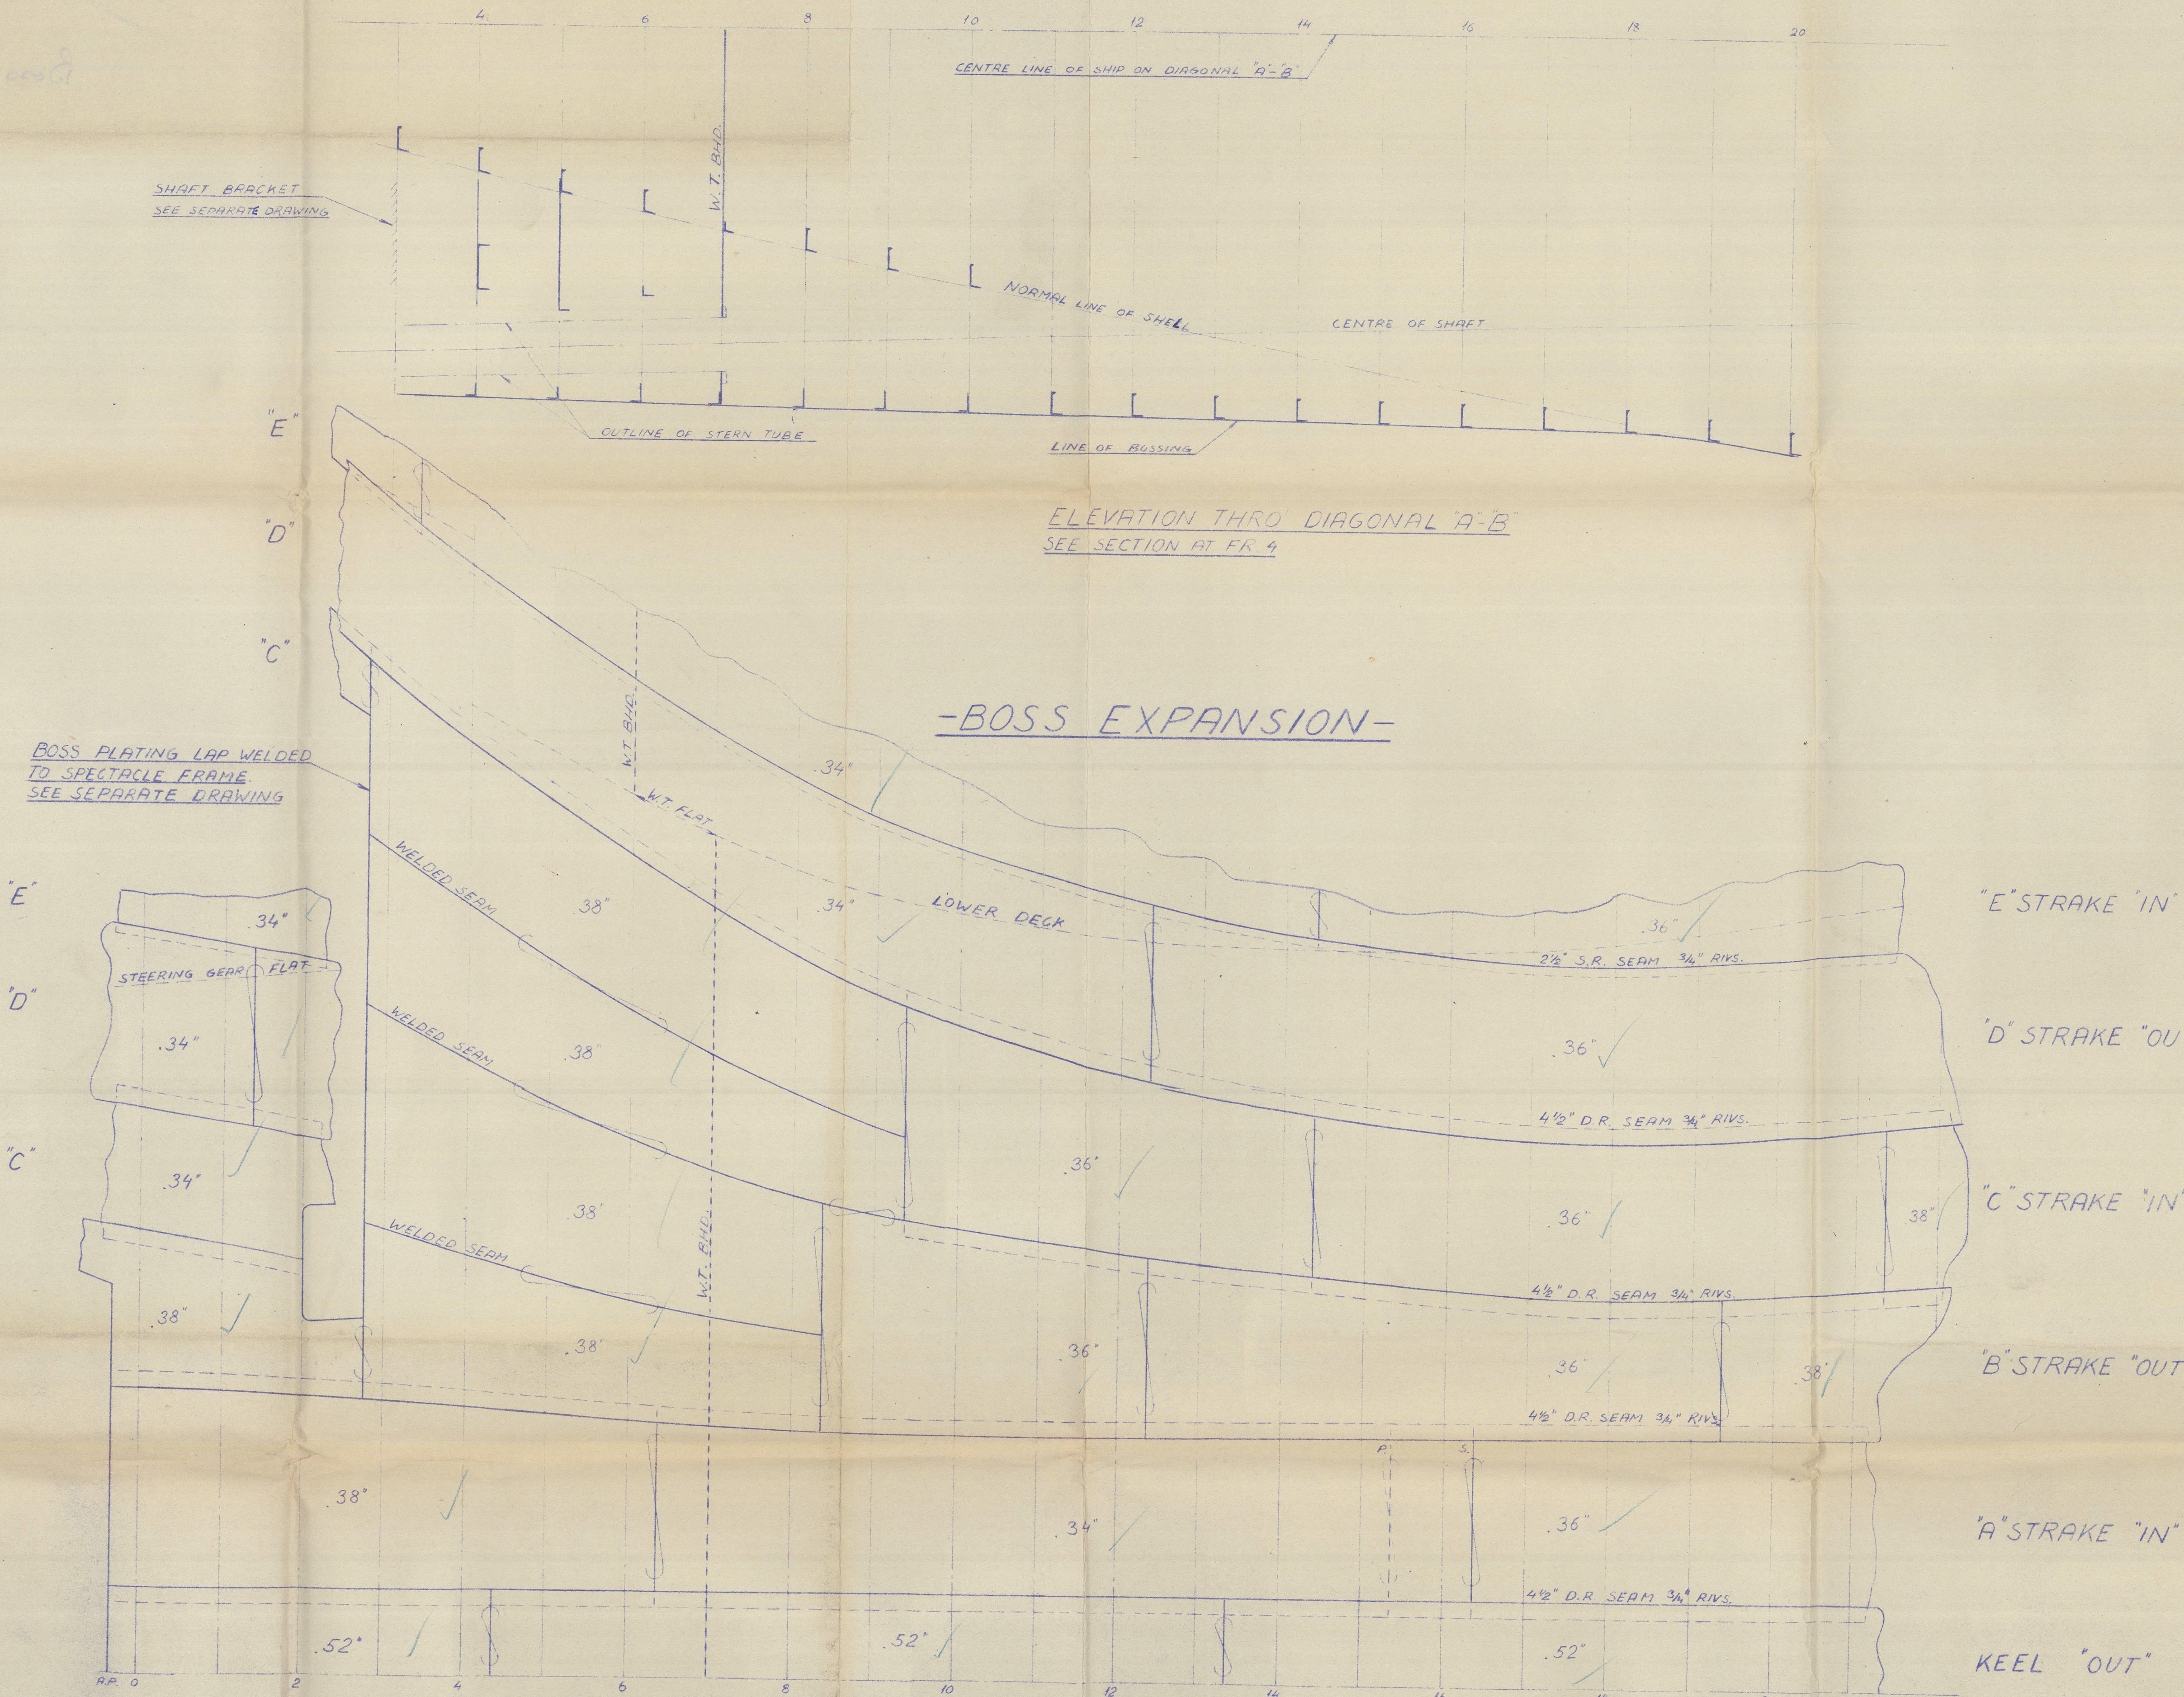

RECORDS DEPT.
LONDON.

7

MERMAID



Boss Framing & Plating

J.S. WHITE & CO. LTD.

YARD NOS 2002-3+7

BOSS FRAMING & PLATING



© 2021

Lloyd's Register
Foundation

012774-012785-0147