
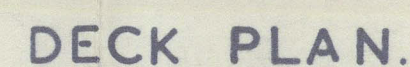
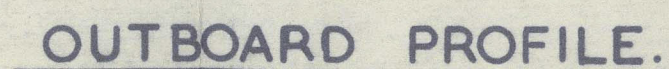


500 TON TANKER (CARGO ABOVE 150° FLASH)

PRINCIPAL DIMENSIONS LO:164-9 BREADTH MLD:32-6 DEPTH MLD:10-6

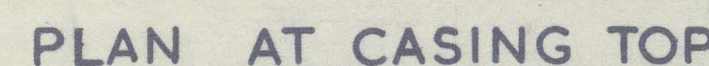

BUILDERS • CHARRINGTON • GARDNER • LOCKET • (LONDON LTD) • PRIORY WORKS • DARTFORD • KENT

FAIRMILE
MARINE CONSULTANTS LTD
COBHAM SURREY ENGLAND

GENERAL ARRANGEMENT

SCALE. $\frac{1}{4}$ = 1 FOOT

DATE: DRG NO. FMC. H74/6


© 2021

CHARRINGTON GARDNER LOCKET LTD


CHARCREST



GENERAL ARRANGEMENT (AS FITTED)

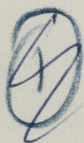

RECORDS DEPT.
LONDON.

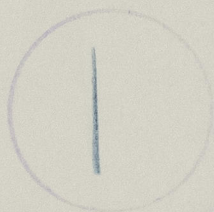

© 2021

Lloyd's Register
Foundation

012786-012791-0125