
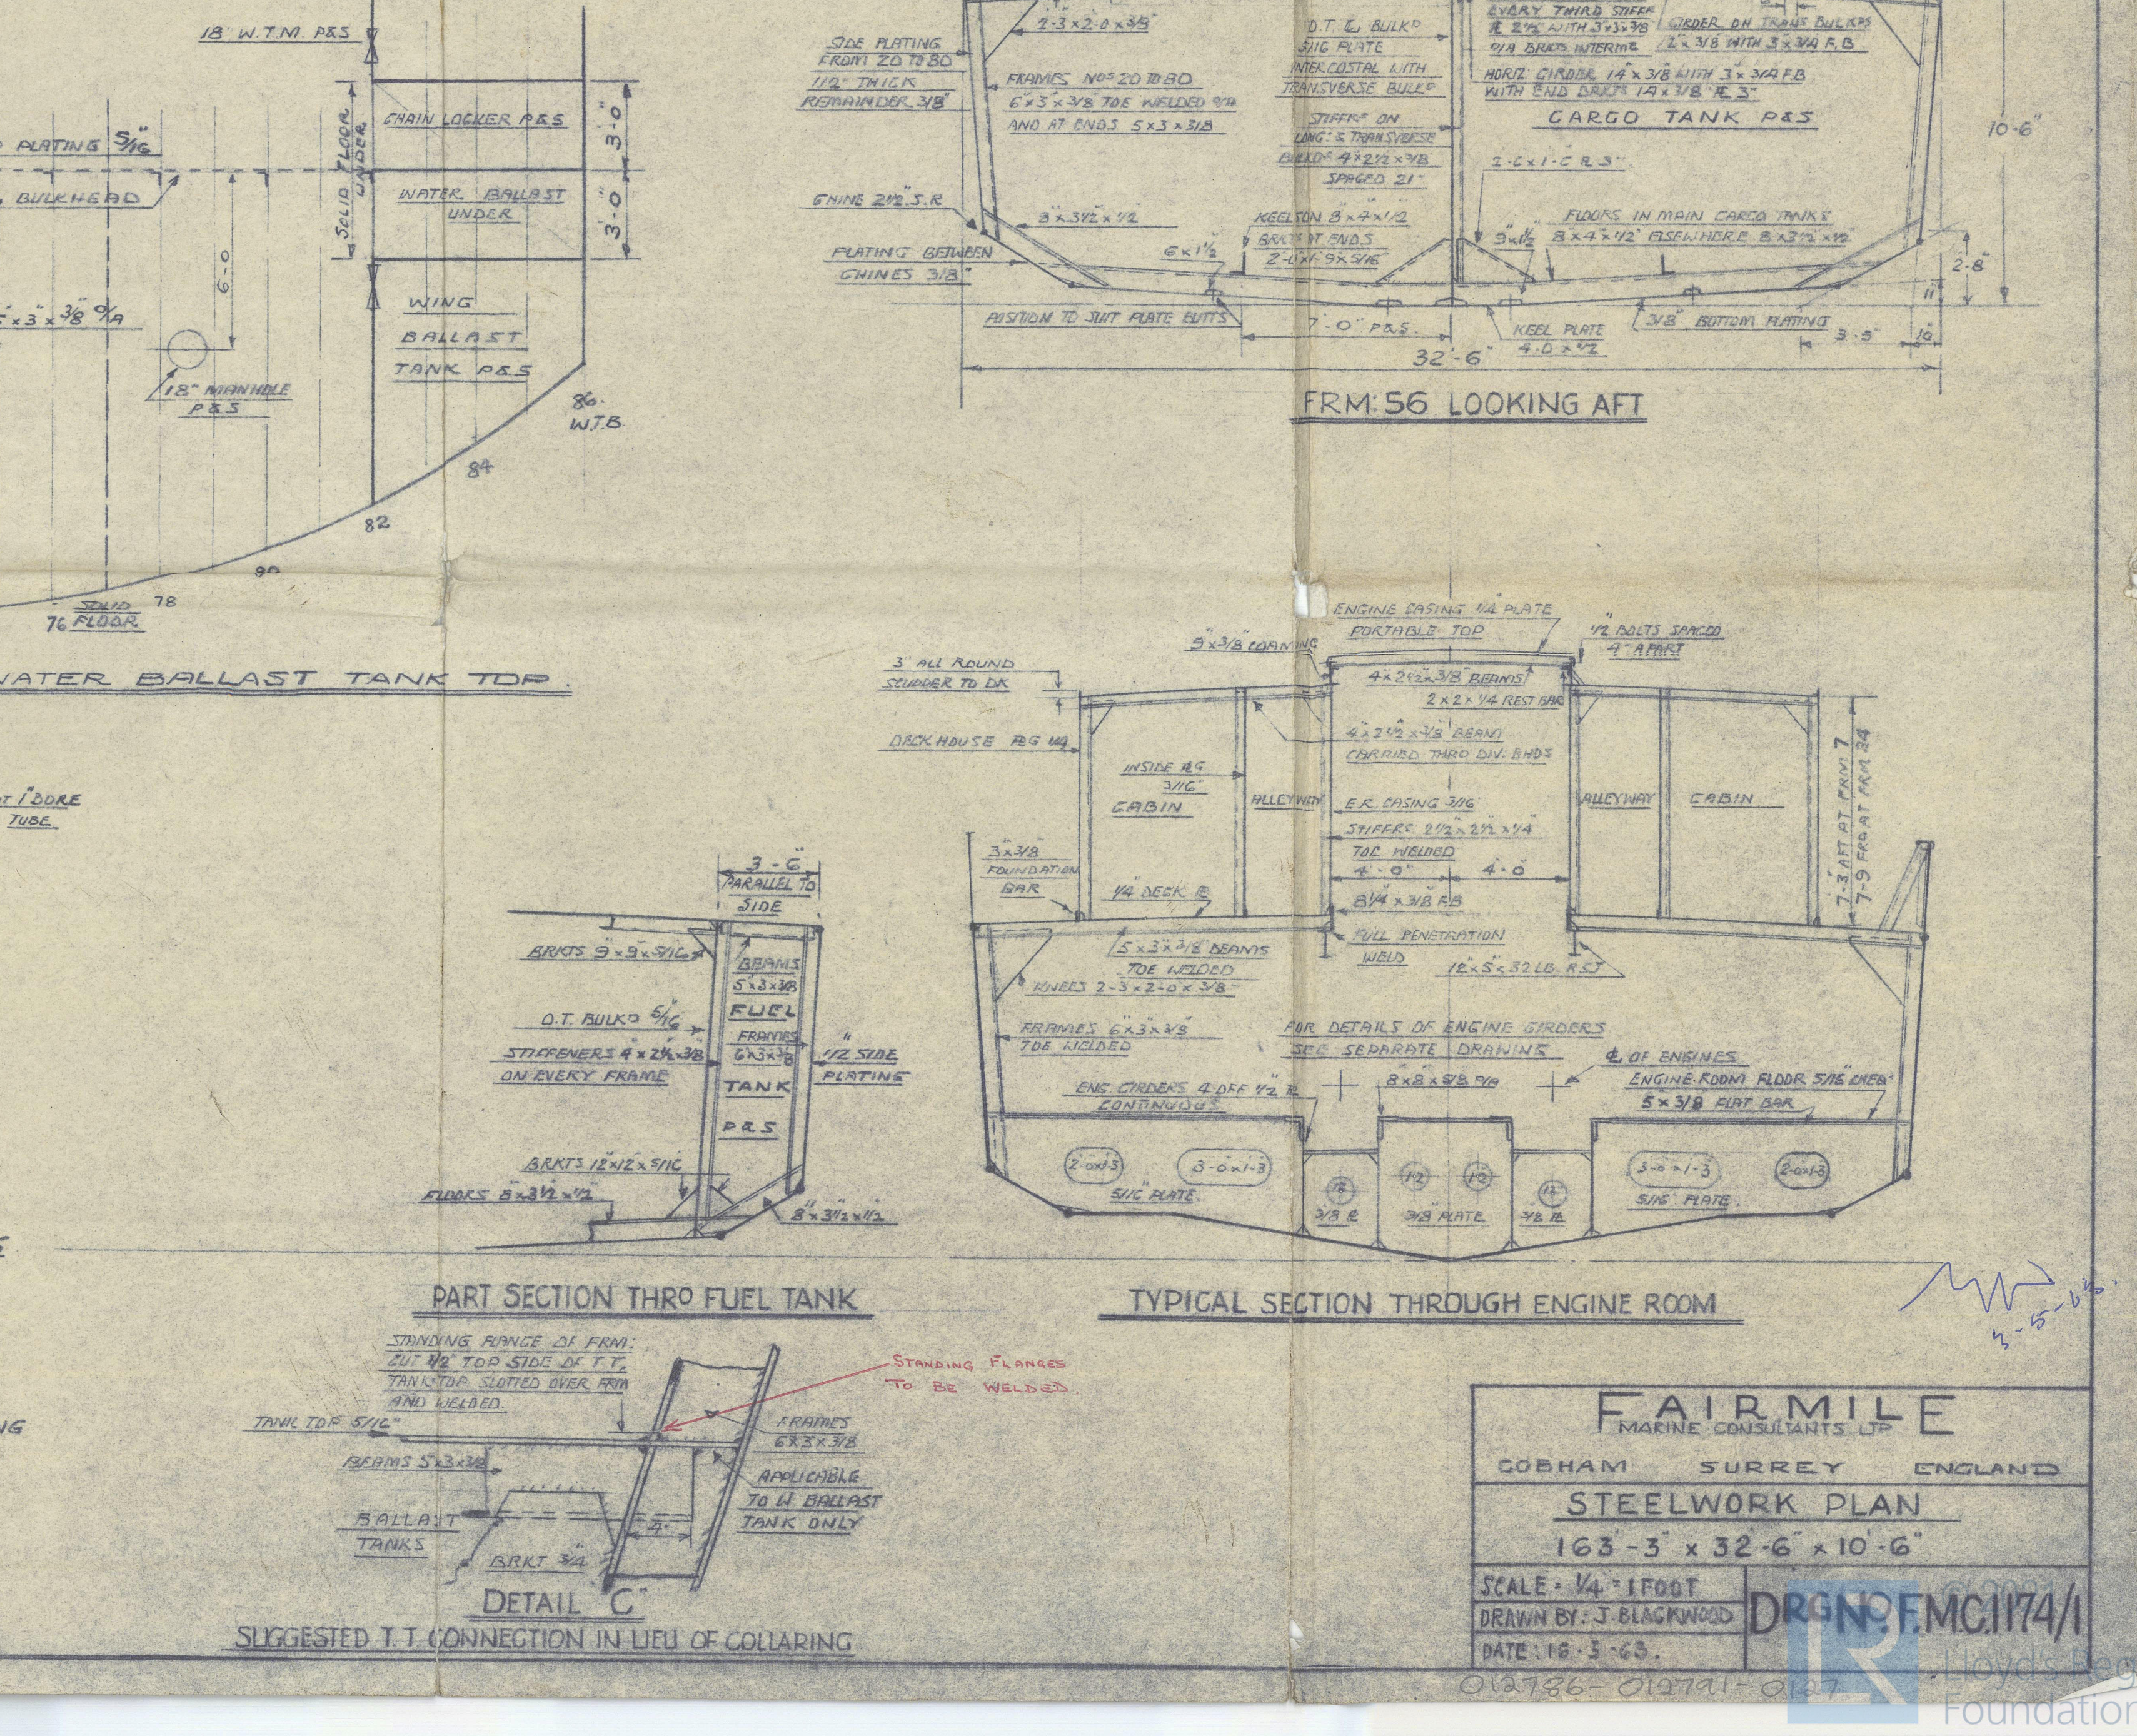
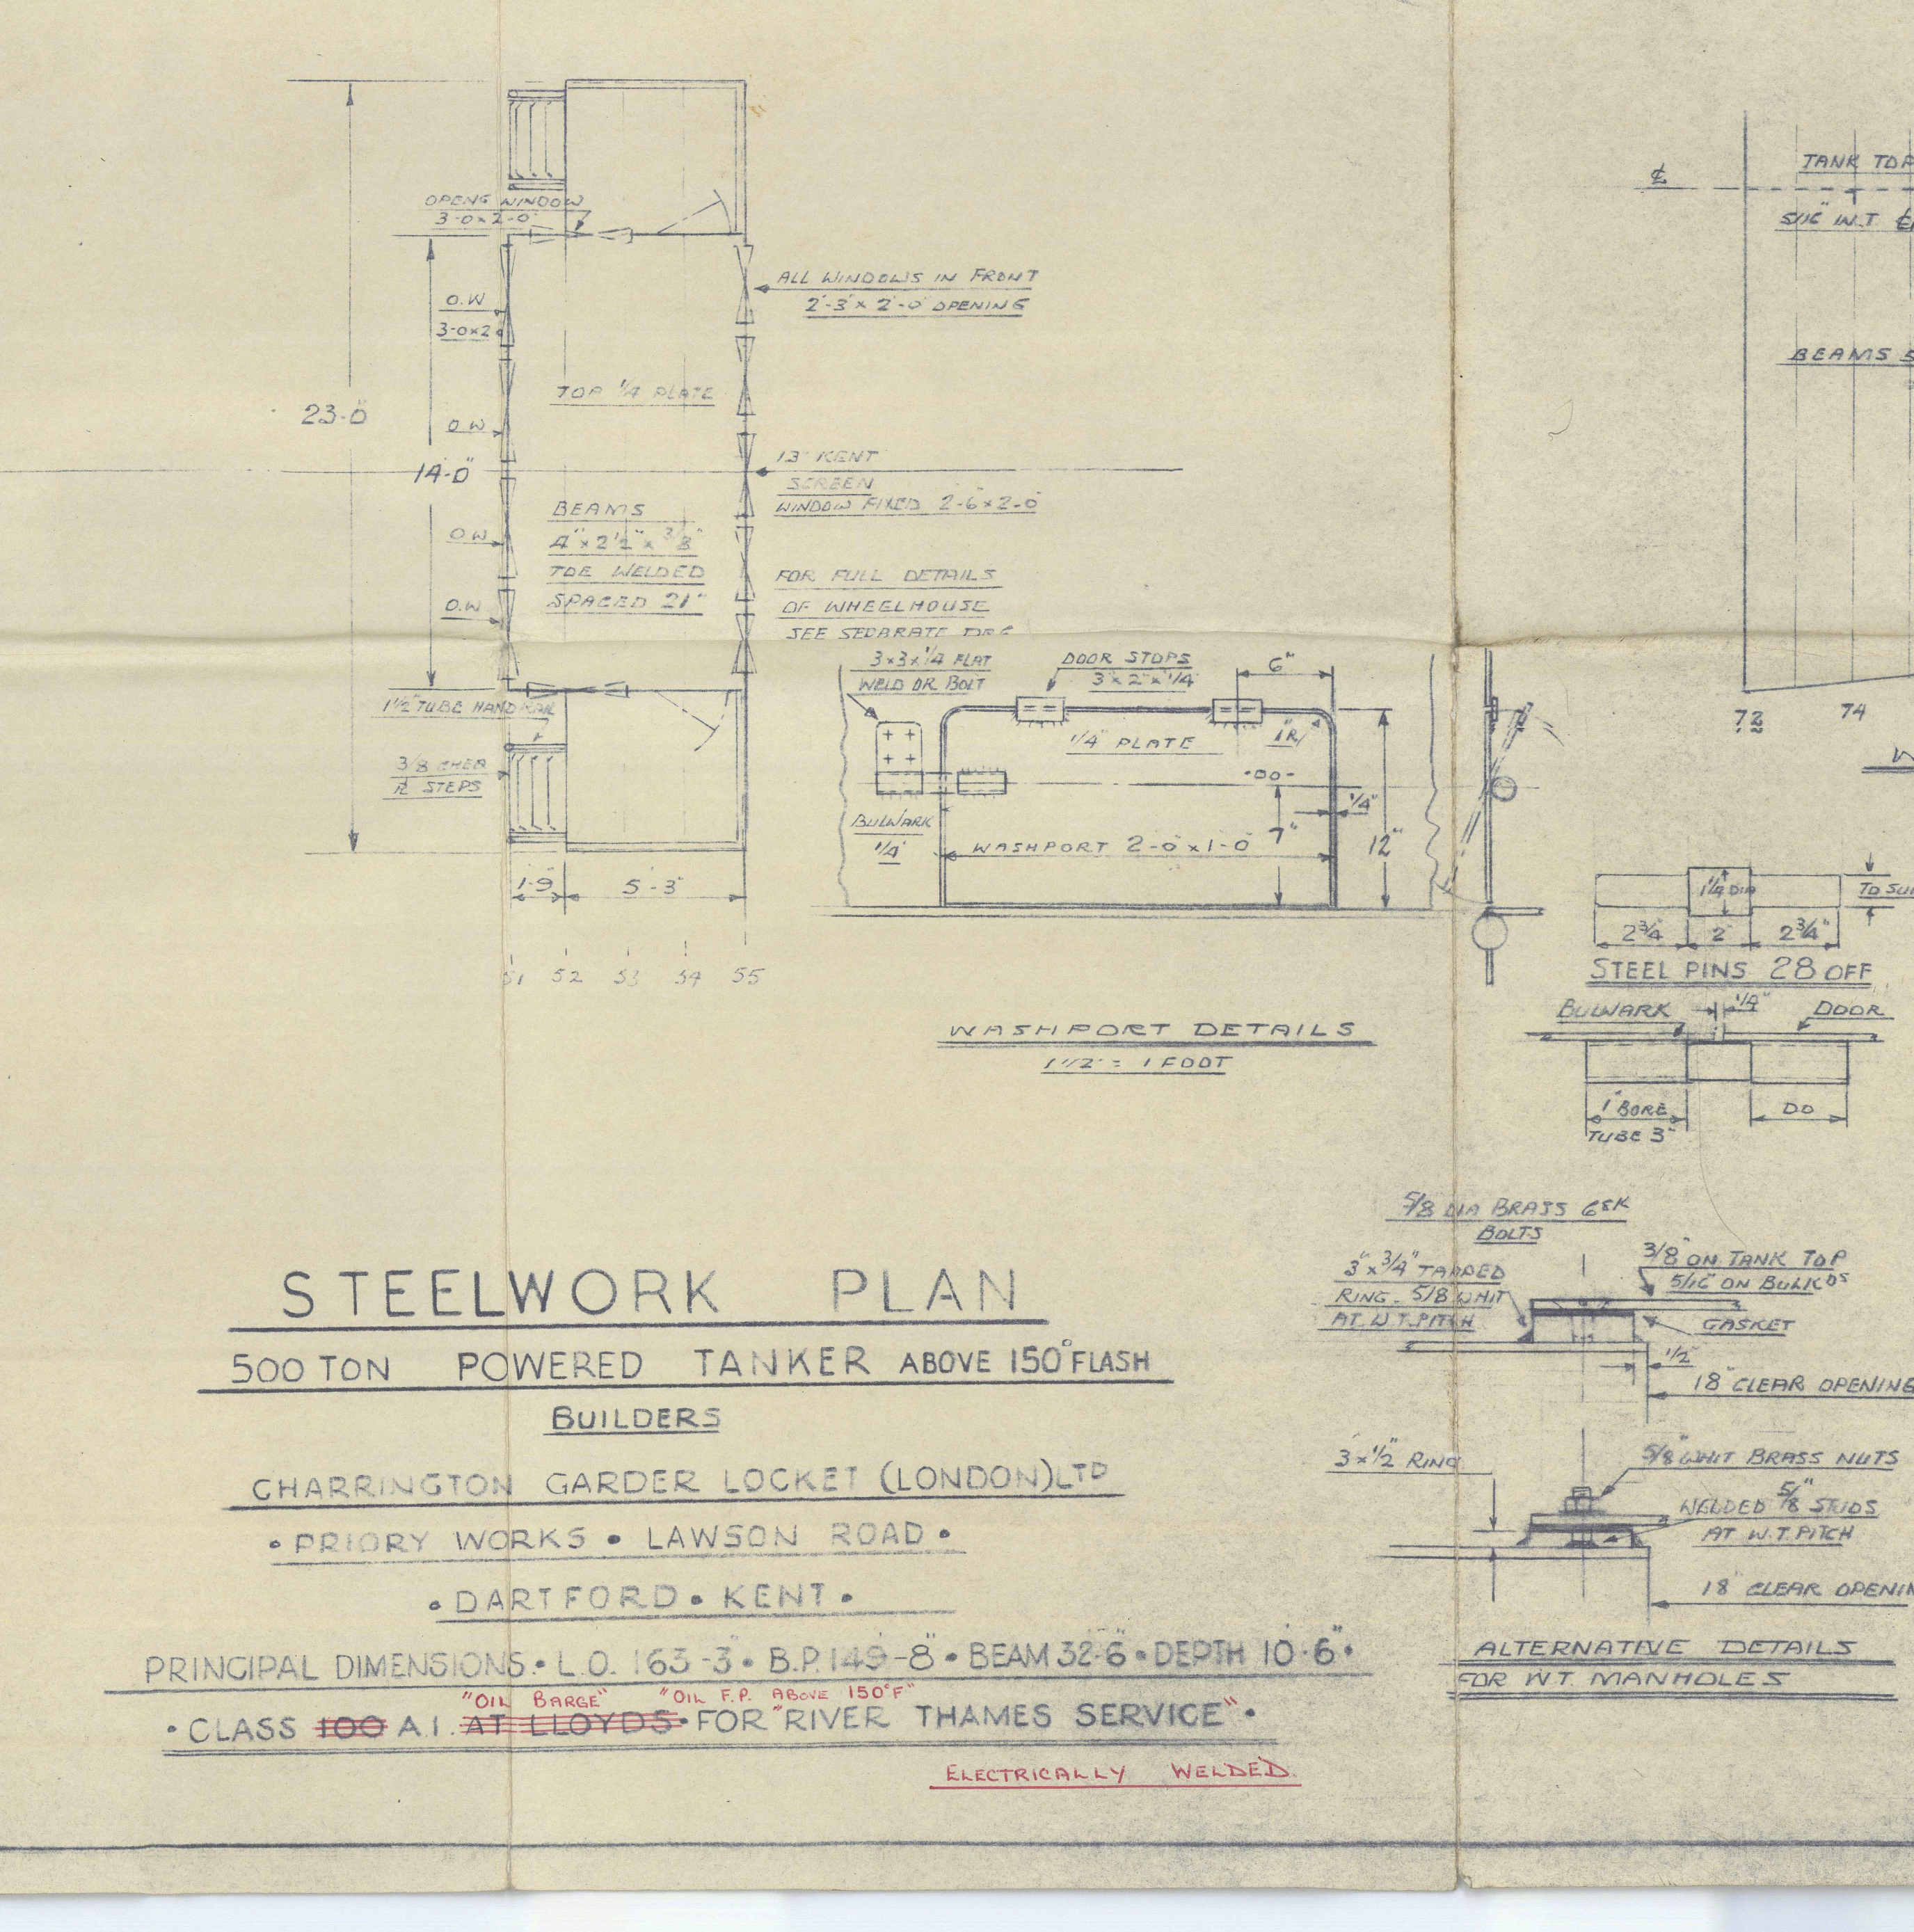
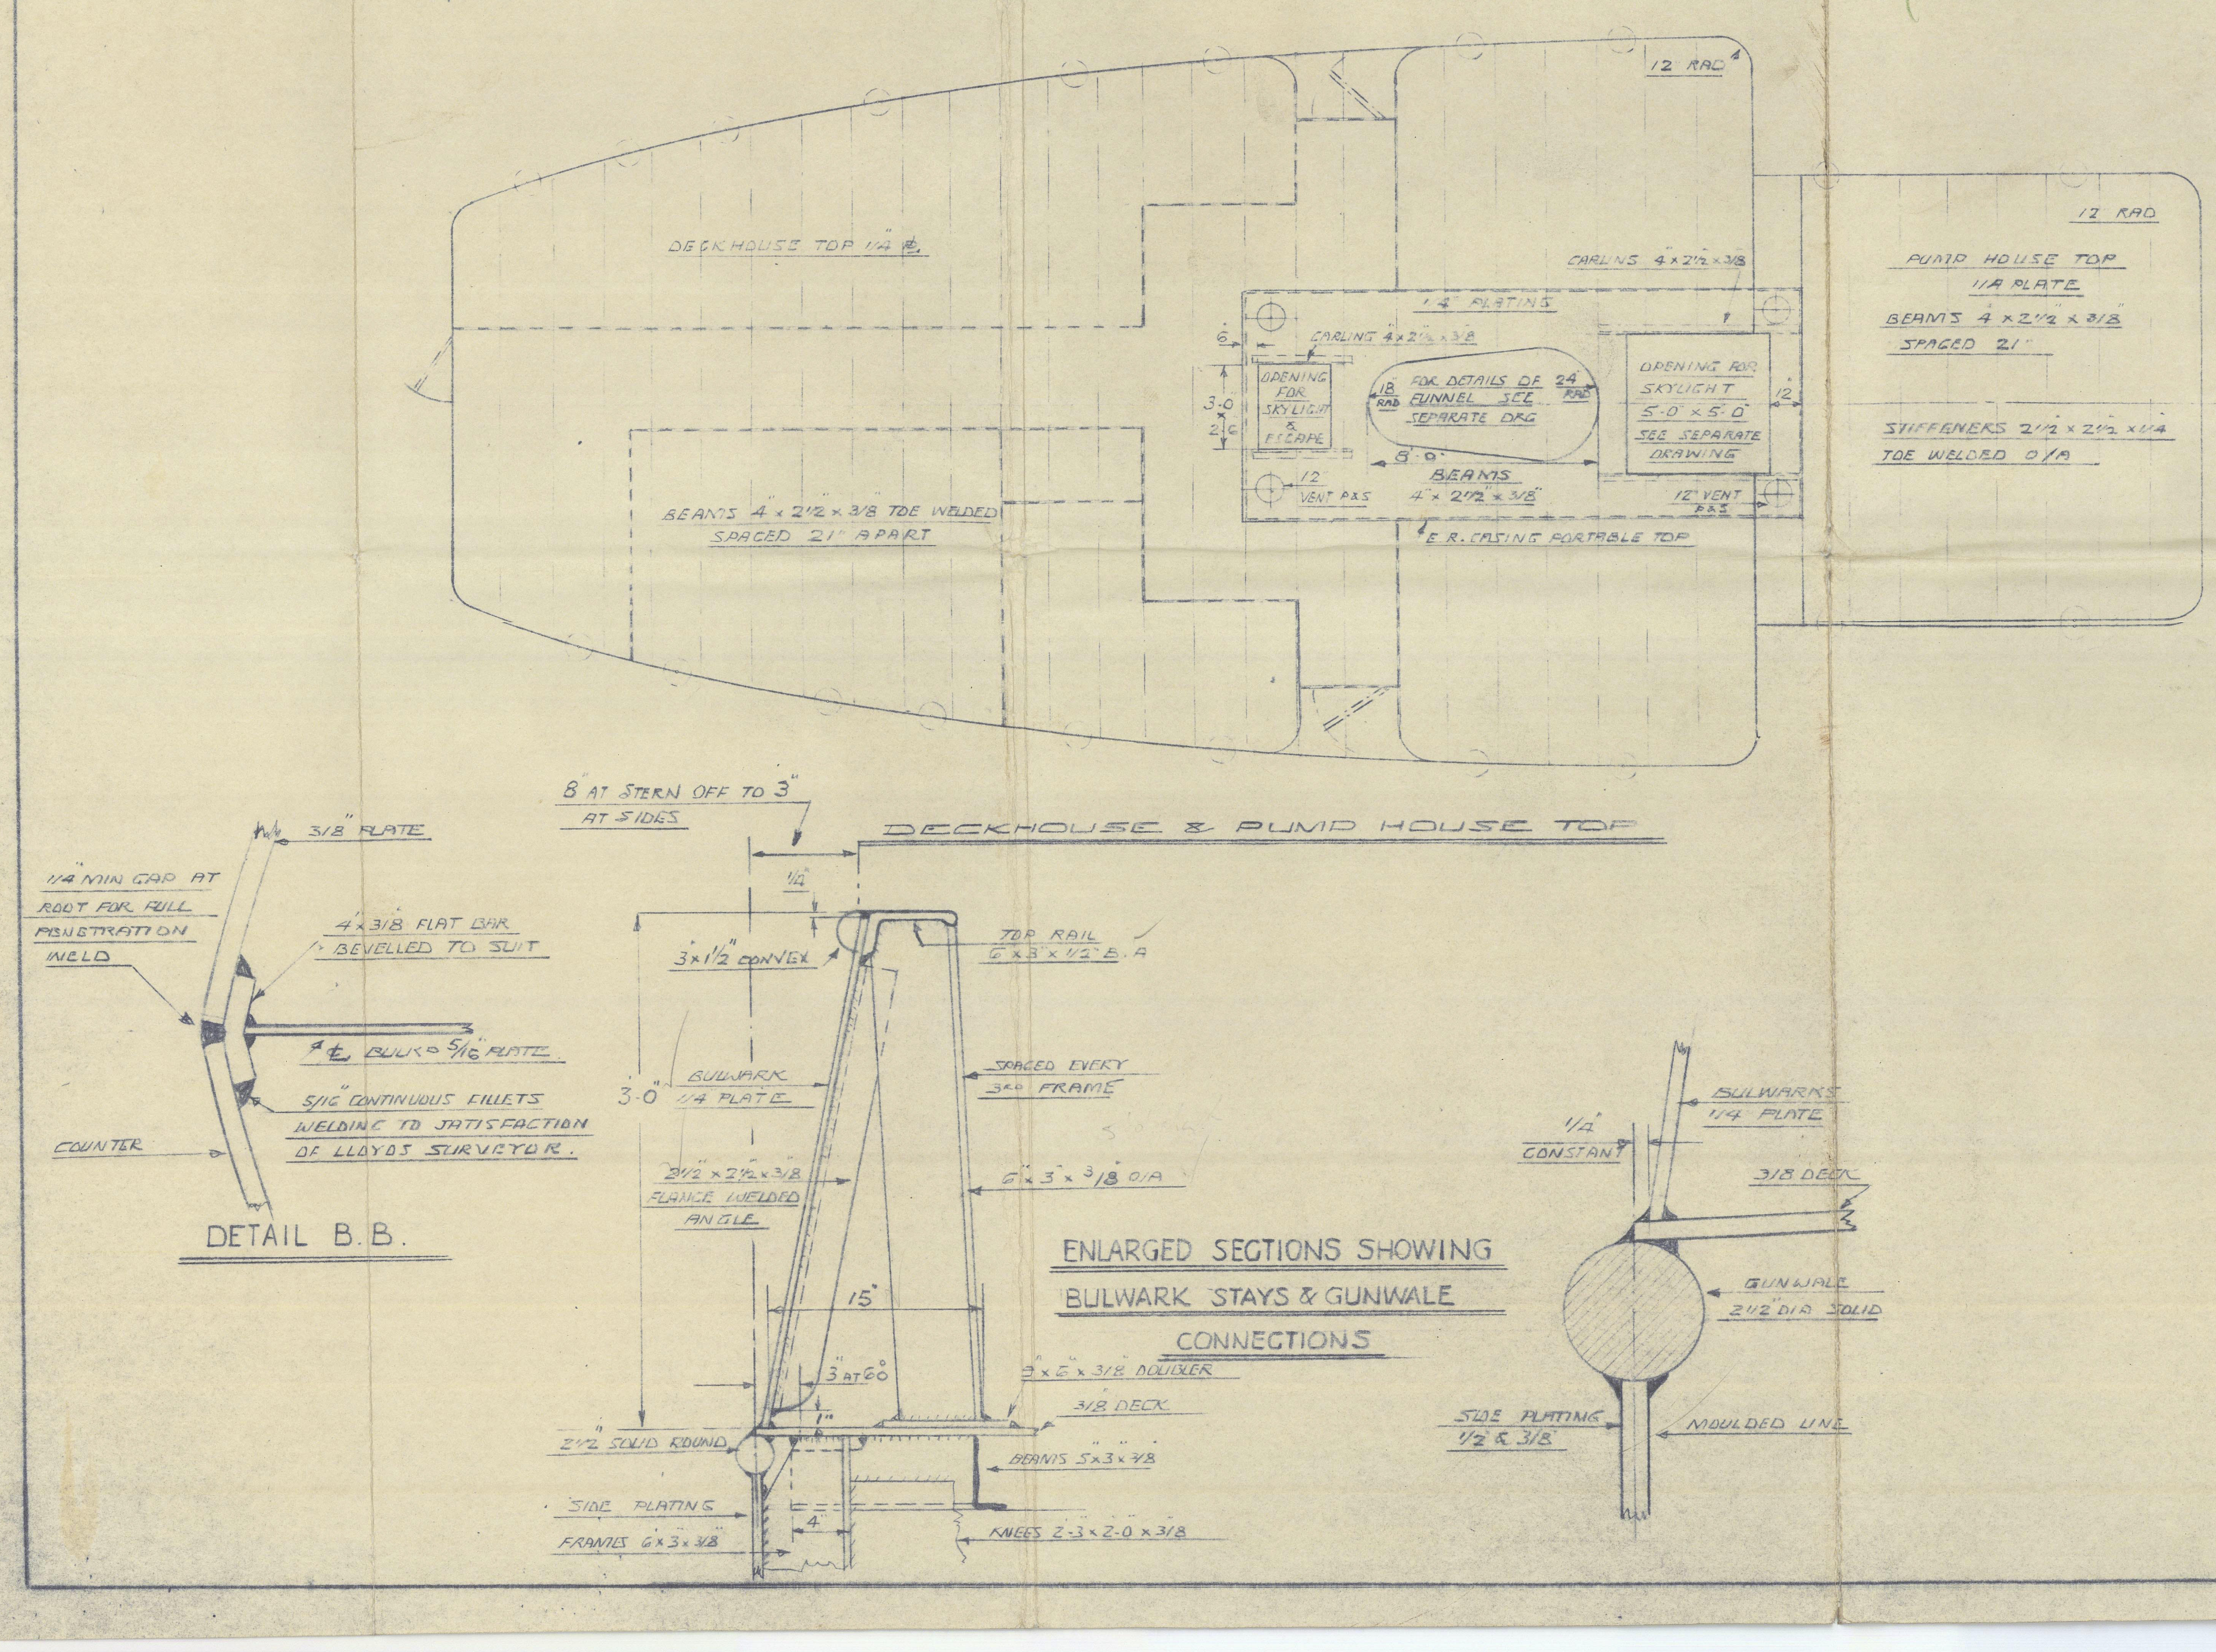
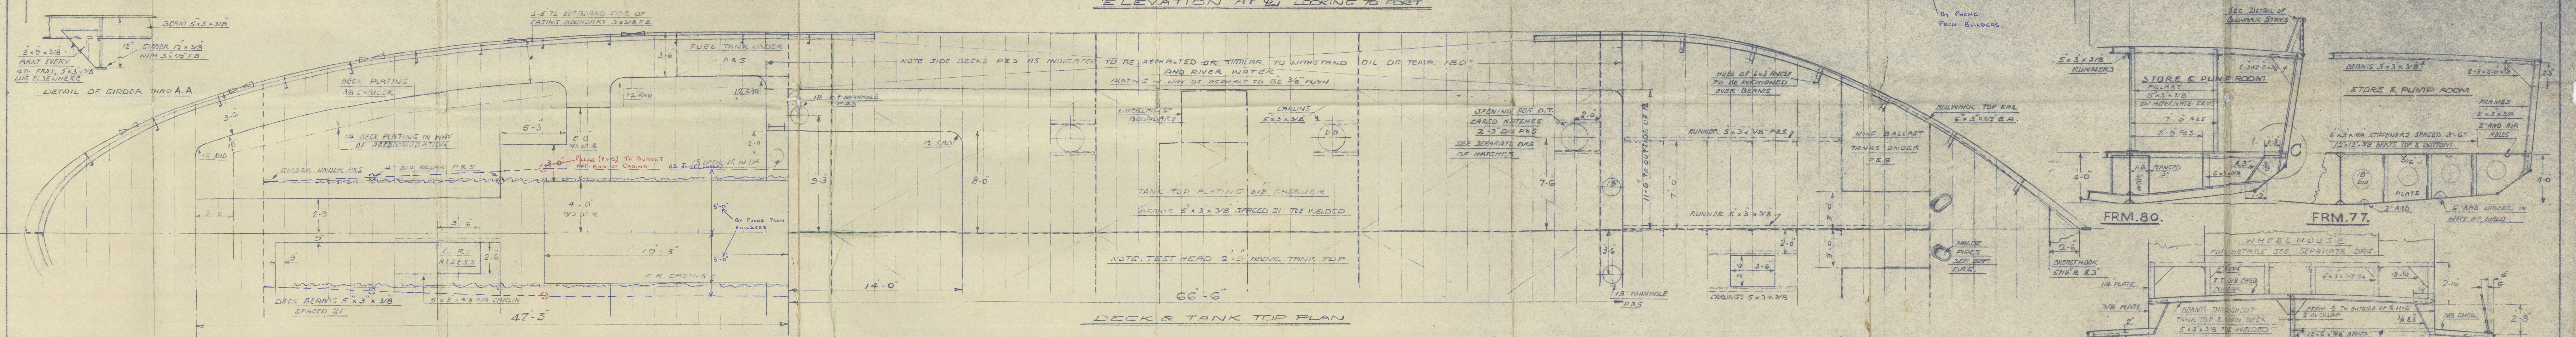


13 MAY 1963


FOR FULL DETAILS OF DECKHOUSES FUNNEL SKYLIGHTS ETC SEE SEPARATE DRAWINGS

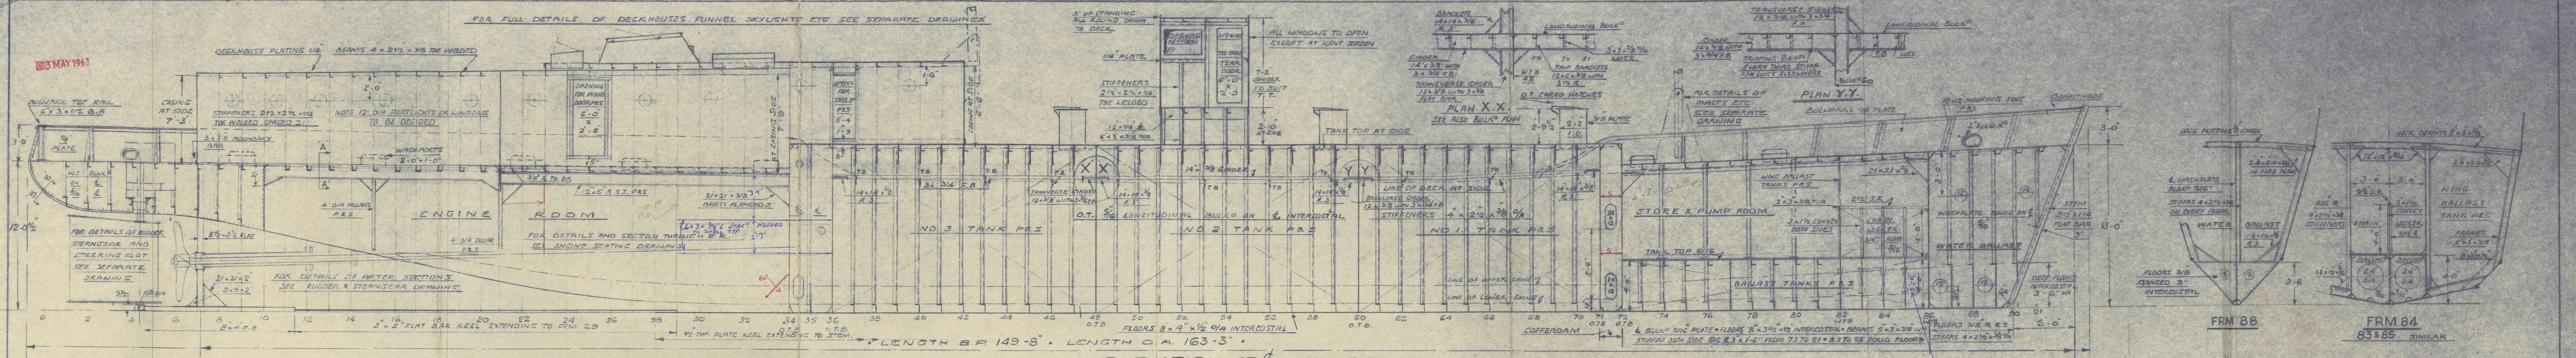

STEELWORK PLAN
500 TON POWERED TANKER ABOVE 150' FLASH
BUILDERS
CHARRINGTON GARDER LOCKET (LONDON) LTD
• PRIORITY WORKS • LAWSON ROAD •
• DARTFORD • KENT •
PRINCIPAL DIMENSIONS • L.O. 163'-3" • B.P. 149'-8" • BEAM 32'-6" • DEPTH 10'-6"
• CLASS 100 A1 AT LLOYD'S FOR RIVER THAMES SERVICE •
ELECTRICALLY WELDED

FAIRMILE
MARINE CONSULTANTS, LTD
COBHAM • SURREY • ENGLAND
STEELWORK PLAN
163'-3" x 32'-6" x 10'-6"
SCALE: 1/4" = 1 FOOT
DRAWN BY: J. BLACKWOOD
DATE: 16.5.63
DRG. NO. FMC1174/1
012786-012787-012788

CHARRINGTON GARDNER LOCKET LTD.

"CHARCREST" 

STEELWORK PLAN (DRG. N^o FM/1174/1)

③

RECORDS DEPT.
LONDON.

③

This plan has been verified with the approved plans, and includes any modifications and/or additions to the original approved arrangements made during construction which have been approved locally as being in accordance with or equivalent to Rule Requirements.

Signature
Surveyor to Lloyd's
Register

Date



© 2021

Lloyd's Register
Foundation

012786-012791-0127