



M.V. "CAMROUX 1"

PROPOSED ALTERATION TO ENGINE SEATING TO SUIT WIDDOP "ZH6" ENGINE

—SCALE ~ 1½" TO 1 FT.—

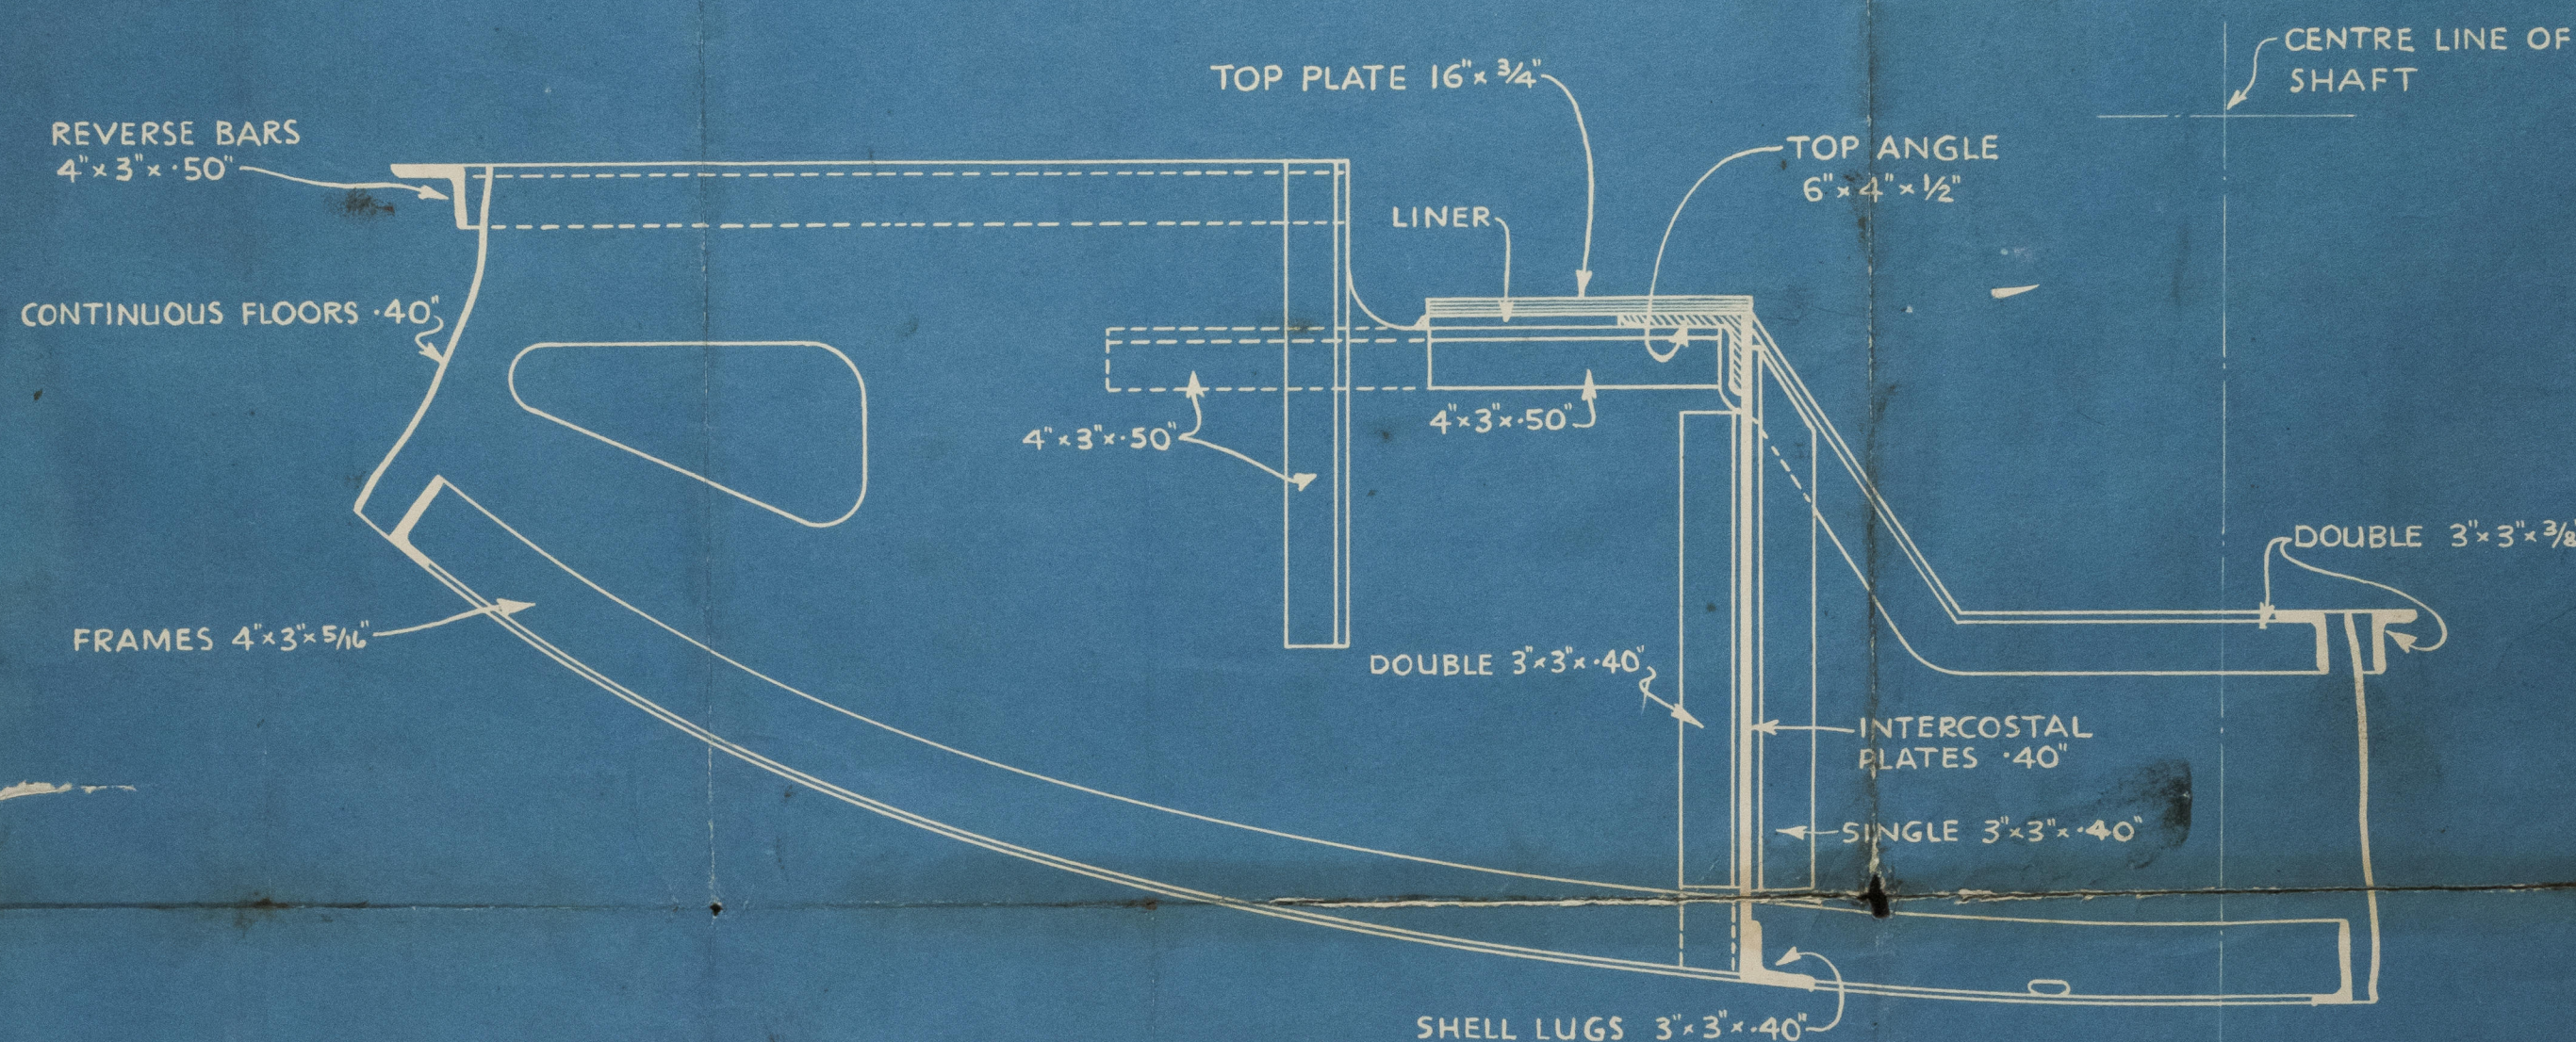

TYPICAL SECTION OF EXISTING SEATING

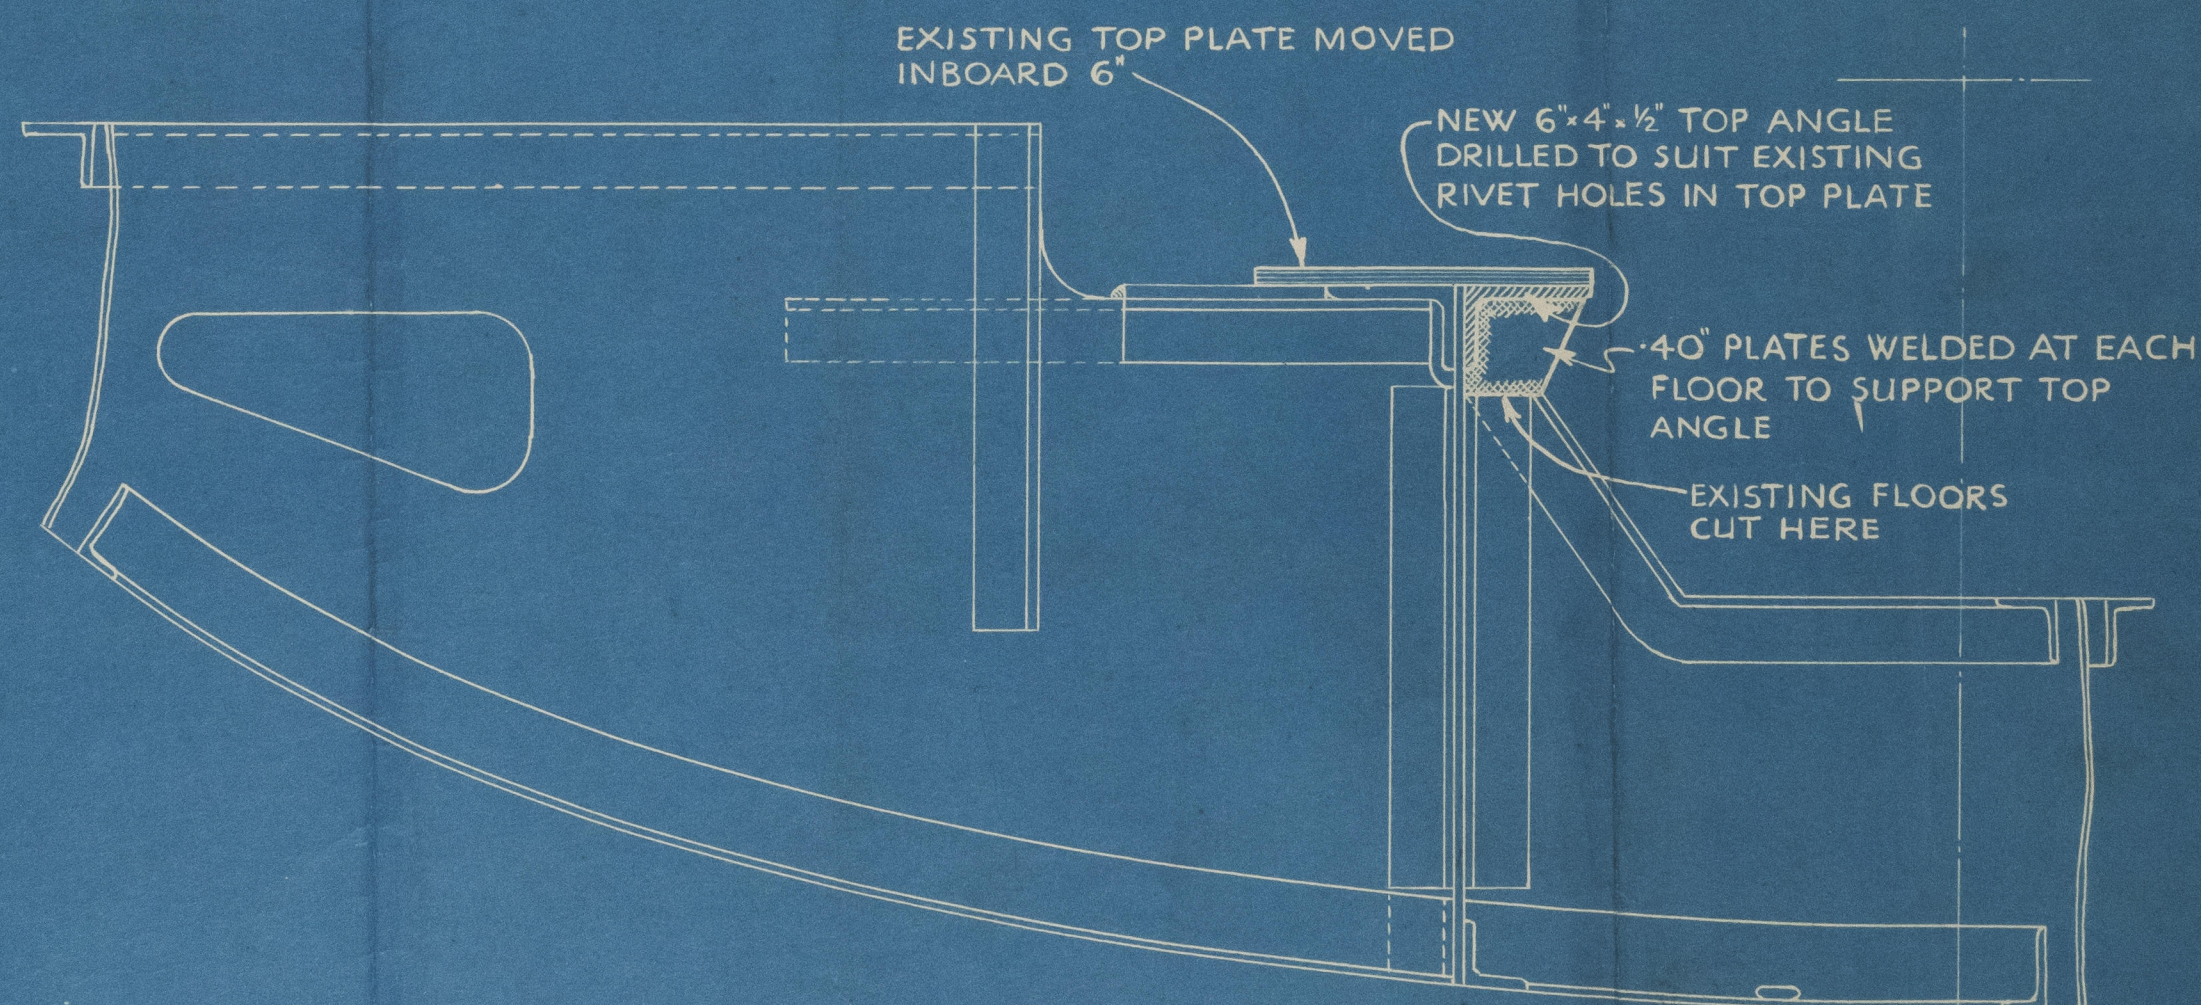



SECTION SHOWING PROPOSED ALTERATIONS

How alteration for carrying out work



Lloyd's Register
Foundation

012792-012795-0001

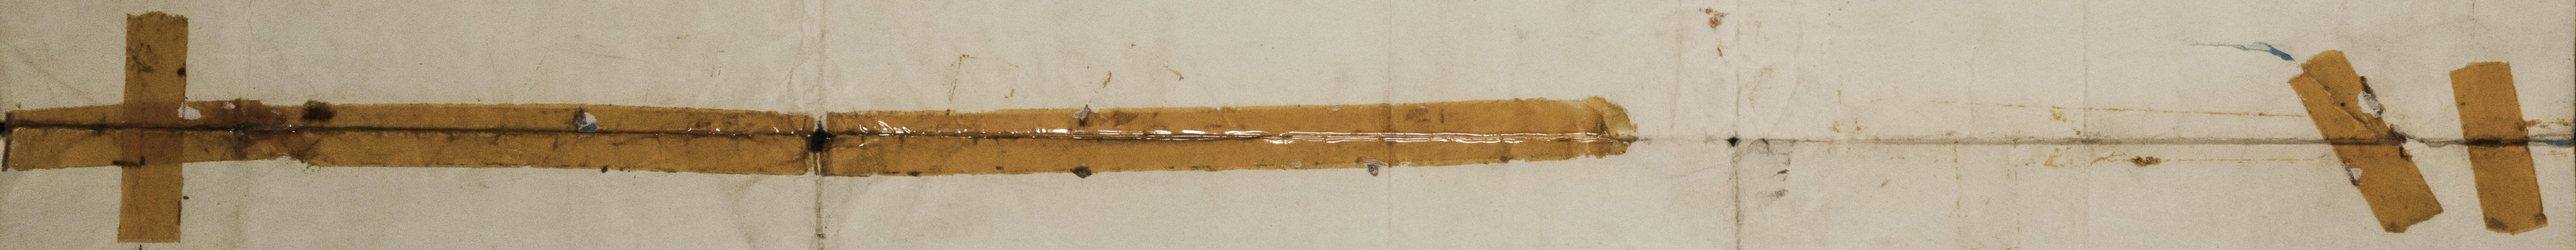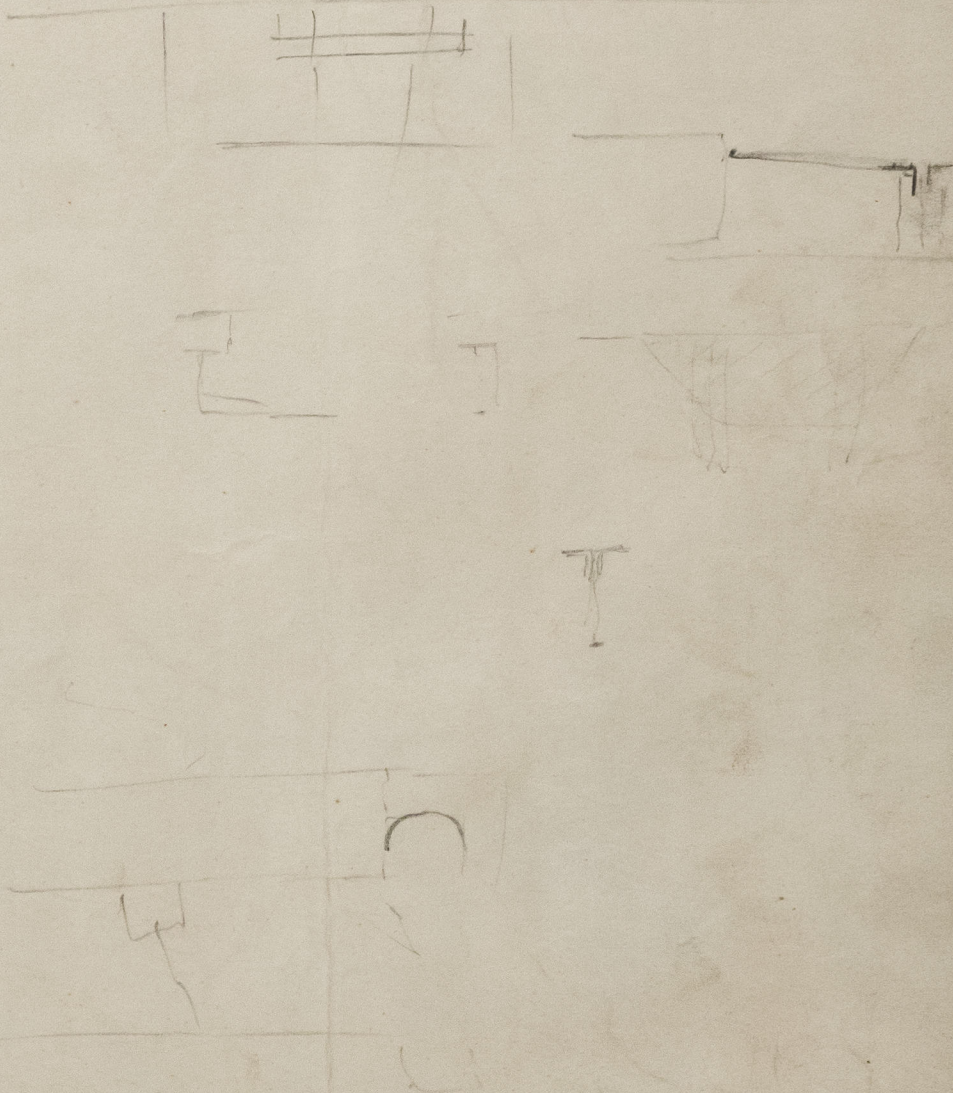

(Hull)

=

m/ Camroux I

Proposed alteration to
Engine seating to suit Widdop
"ZH6" Engine.

Nwc 99879

