

GENERAL ARRANGEMENT OF SINGLE SCREW MOTOR COASTERS.


SHIP NOS. 1465/6.

DIMENSIONS

LENGTH O.A.	136'-0"
LENGTH B.P.	130'-0"
BREADTH MLD.	25'-0"
DEPTH MLD.	10'-9"
DRAFT LOADED.	8'-9"
ENGINE.	300/330 BHP. ALLEN 4 STROKE DIESEL.
CLASSIFICATION.	LLOYDS 100 A.I.

— SCALE 1/4" TO 1 FOOT —

"CAMROUX I." & "CAMROUX II."

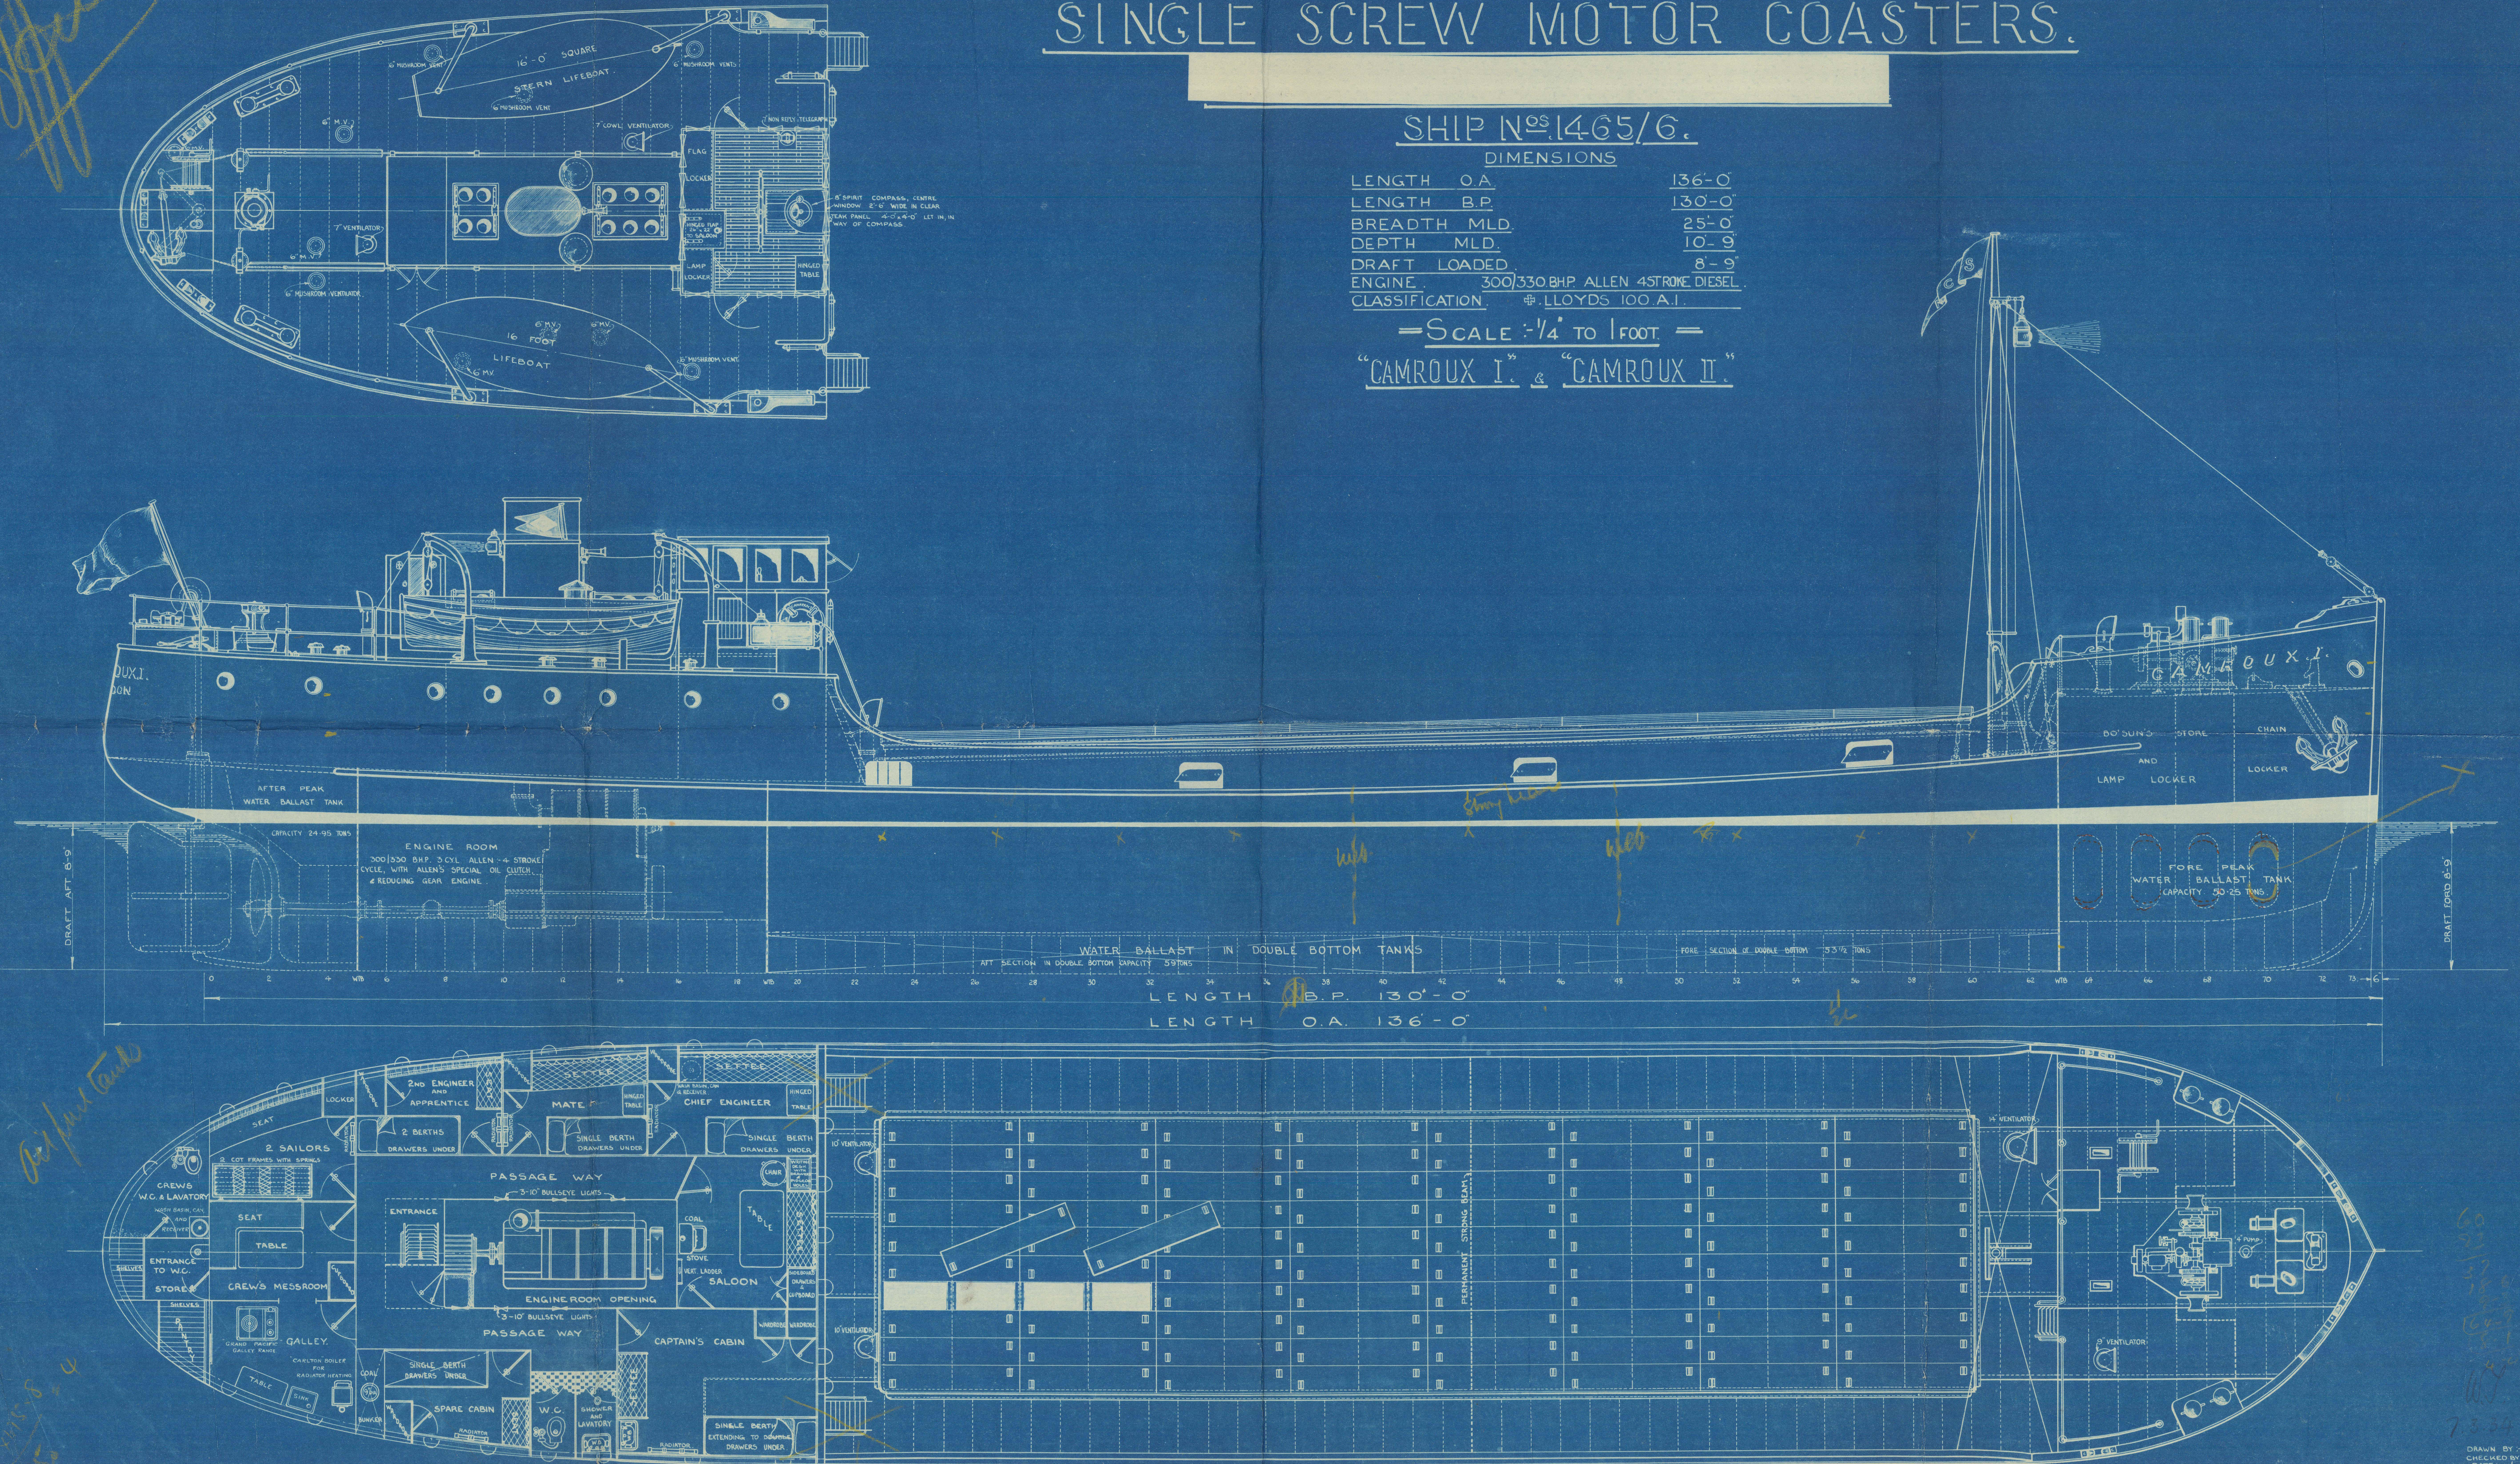

PLAN No. 20,138.
JAMES POLLOCK, SONS & CO. LTD.
SHIPBUILDERS & ENGINEERS
3, LLOYDS AVENUE,
— LONDON, E.C.3. —

GEN. BOX 11

87

(1)


POLLOCK'S

145576.

Camroux I

Camroux II

Gen. Ang &

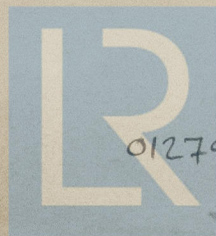

© 2021

012792-012795-0006

Lloyd's Register
Foundation