

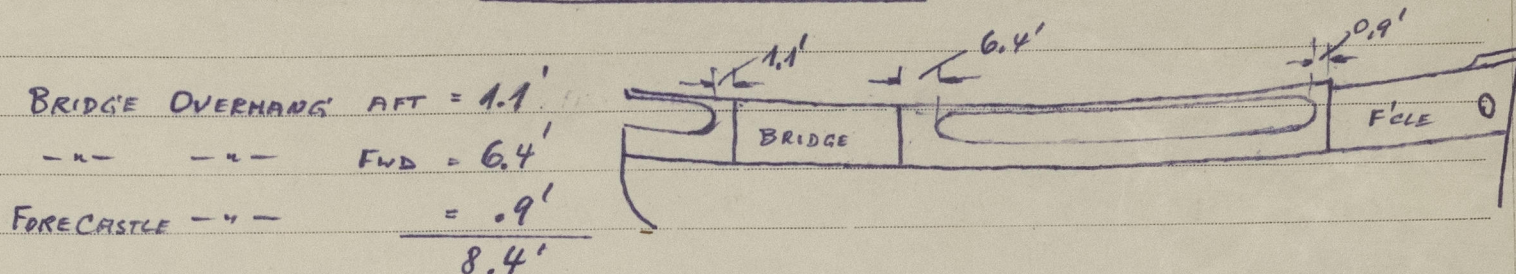
LLOYD'S REGISTER OF SHIPPING

UNITED WITH THE BRITISH CORPORATION REGISTER

Ship's Name "SEVEN SEAS"

Official No. _____

Memorandum of alterations reported since ship was surveyed for assignment of Load Lines in FEBRUARY AT BREMERHAVEN (1954)

AMENDMENTSTO FREEBOARD REPORT BREMEN No. F 91A.) FORM CM (COMP.)B.) FORM CM (ADDITION)

- 1 COMPANIONWAY ON FREEBOARD DECK (B-DECK) AFT FITTED AT FRAME 183/184 ON STARBOARD SIDE OF SUBSTANTIAL STEEL CONSTRUCTION. OPENING 65" x 25" CLOSED BY W.T. STEEL DOOR CAPABLE OF BEING MANIPULATED FROM BOTH SIDES. SILL 18."

Bremen, the 12th FEBRUARY, 1954
 O. H. B. C.