

STEEL SINGLE SCREW TUG BOAT.

DIMS:- 90'-0" B.P x 21'-6" x 10'-0" MLD

SCALE $\frac{1}{2}" = 1$ FOOT.

NUMERALS

L = 90 B = 21.5 D = 10


$$\underline{L \times D = 900}$$
$$\underline{L \times B + D = 2835}$$
$$\frac{L/D}{\quad} = 9$$
$$\underline{a} = 8.92$$
EQUIPMENT

2 BOWER ANCHORS 4 CWT EACH EX STOCK

60 FATHOMS $14/16$ STUD CHAIN CABLE

60" ✓ 5½" ✓ HAWSER

60 " 3" WARP.

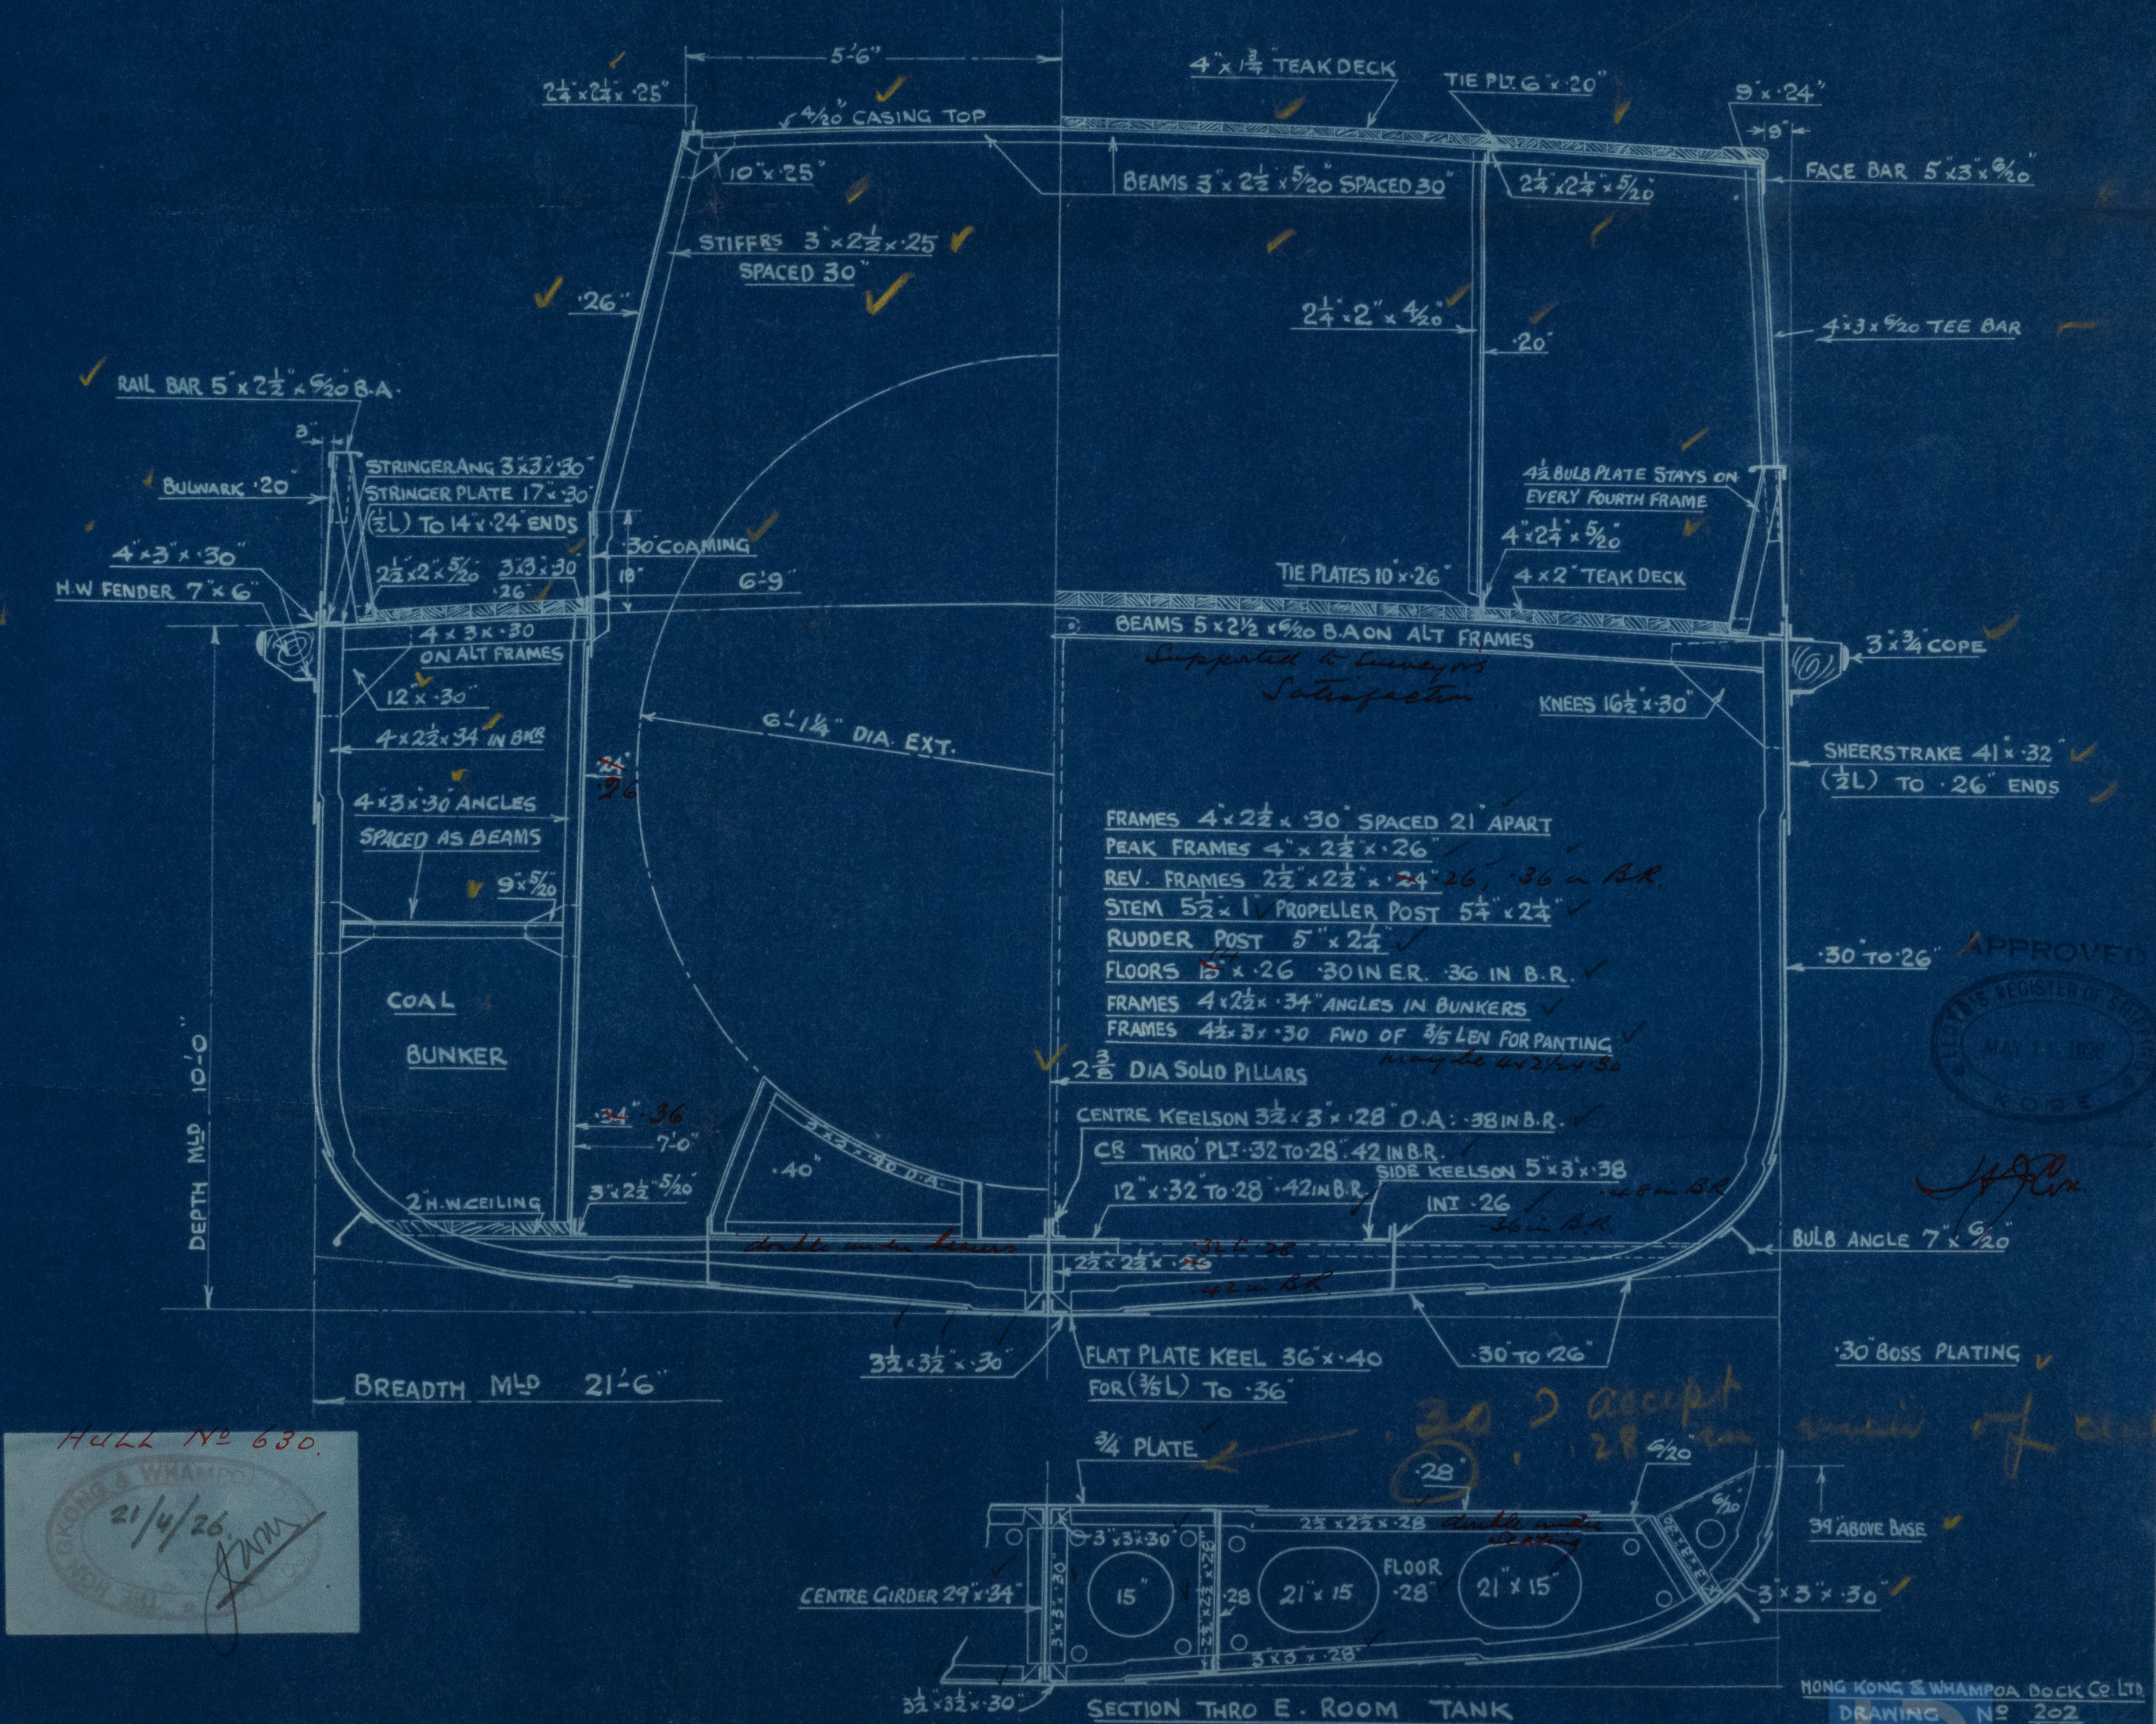

HALL No 630.

21/4/26.

HONG KONG & WHAMPOA DOCK CO. LTD.
DRAWING NO. 202
4.26

DRAWING


GEN. BOX N2 946

630

012810-012817-0112



© 2021

Lloyd's Register
Foundation