

M.V. "QUEENSGATE".

GENERAL ARRANGEMENT.

SCALE :- $\frac{1}{8}$ " = ONE FOOT.


OFFICIAL N° 300221 SIGNAL LETTERS

PRINCIPAL DIMENSIONS 117'-8" LOA x 110'-3" LBP x 25'-0" BMLD x 9'-2" DMLD


REGISTERED DIMENSIONS 113'-33" x 25'-04" x 7'-50"

GROSS TONNAGE 199-97 TONS NETT TONNAGE 98-5 TONS


CLELANDS SHIPBUILDING CO LTD WALLSEND ENGLAND YARD N° 239 DECEMBER 1959.

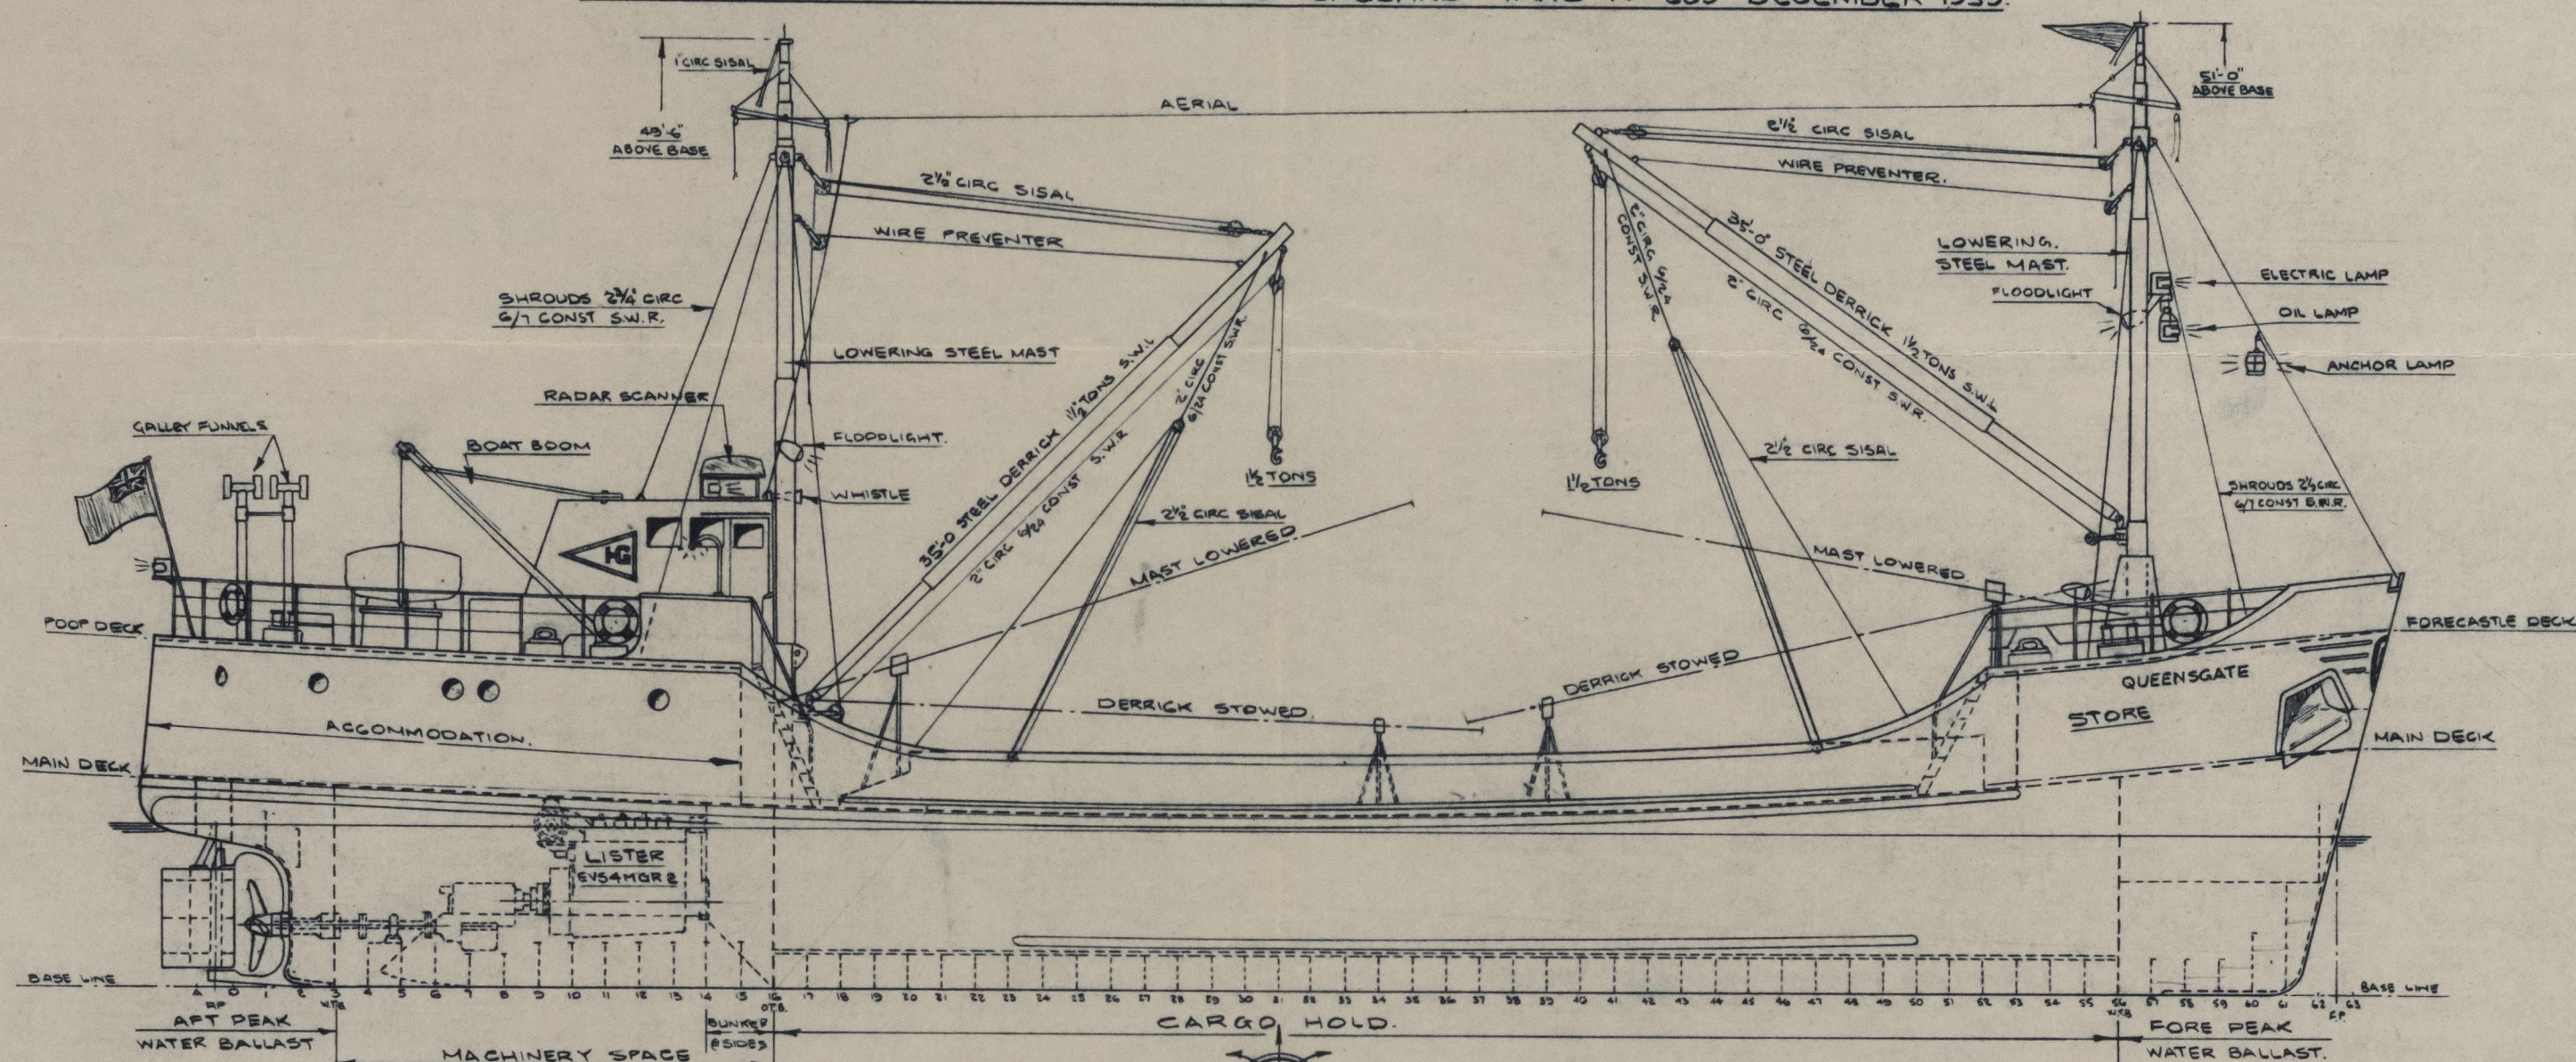


FRAMES SPACED 21" THROUGHOUT.

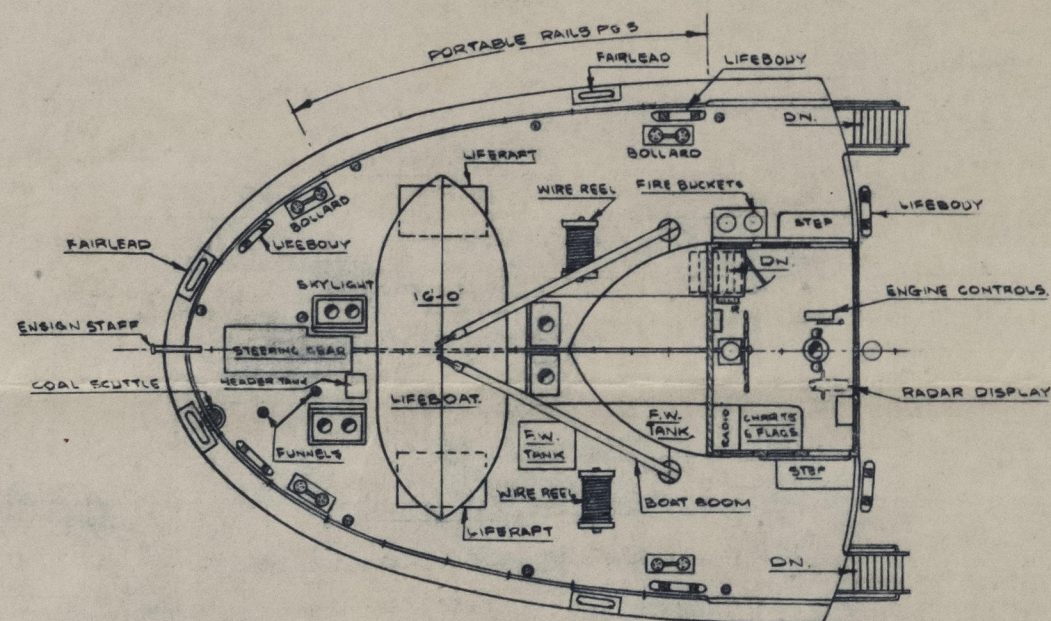

POOP DECK.

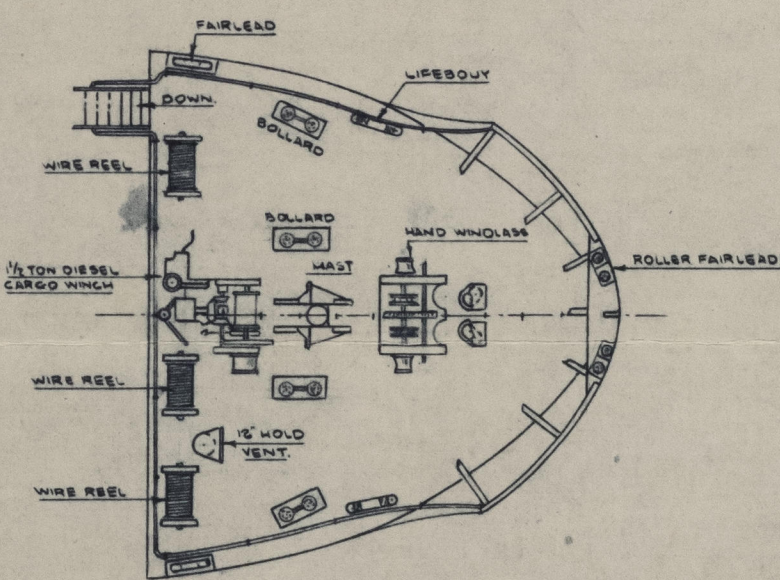

FORECASTLE DECK.

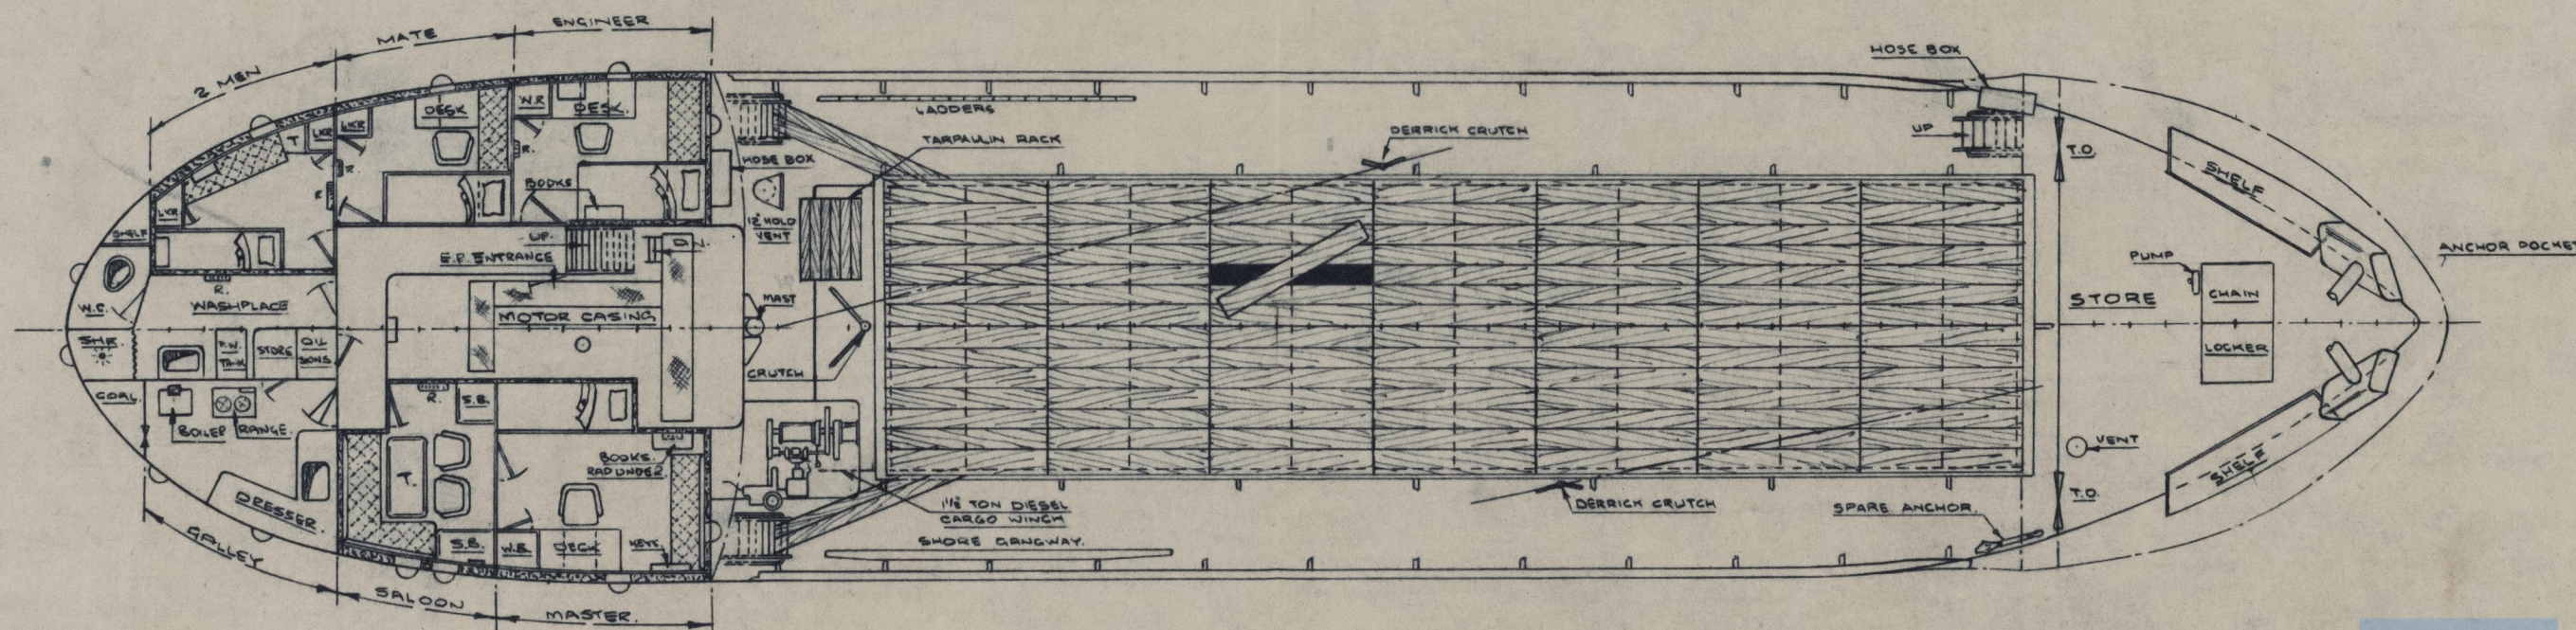

MAIN DECK.



© 2021

Lloyd's Register
Foundation

012375-07326-0001

CLELANDS (SUCCESSORS) LTD.

QUEENFORD

←
QUEENSGATE *

(YARD NO 239)


GENERAL ARRANGEMENT /

(AS FITTED)

D/S

906

RECORDS DEPT.
LONDON.

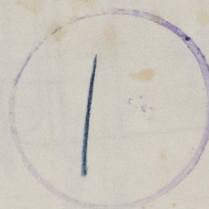

© 2021

Lloyd's Register
Foundation

012818-02826-0001