

## LLOYD'S REGISTER OF SHIPPING

Ship's Name

"LENKORAN"

Official No.

903


Memorandum of alterations reported since ship was surveyed for assignment of Load Lines

in See C.11 Report submitted 24<sup>th</sup> April, 1962.


Companionway enclosed  
in strong steel deckhouse  
on Control Room Top at  
Poop Deck level. Hinged  
steel watertight door  
operated both sides

1320 x 720 mm. Sill 490 mm.

Door to Control Room on Upper Deck removed and opening permanently  
plated over, 12 mm. thick.

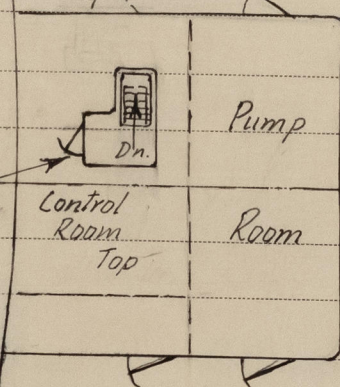

Poop Front

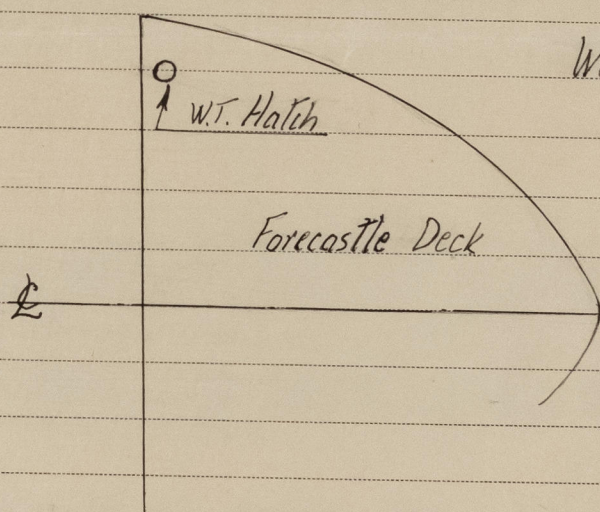

Watertight Hatch to Foam Generator Room  
(Port side) fitted on Forecastle Deck

Dimensions: - 700 mm dia.

Coaming: - 610 mm high above deck

Thickness, 12.7 mm. with  
Hinged Steel lid 6 mm. thick  
secured W.T. by 4 clips.

A. Scott

Noted  
at 2

13-6-62