

Lloyd's Register of Shipping.

SURVEYS FOR FREEBOARD.

(CONDITIONS OF ASSIGNMENT.)


 Index No. **42064**
 (For London Office only.)

18 SEP 1950

GRV. REPORT N° 24209

Ship's Name POWELL Port of Survey GREENOCK
 Official Number 184305 Surveyor's Signature Kenneth Inglis
 Nationality and Port of Registry BRITISH LONDON Date of Survey WHILE BUILDING, 1950

Disposition and dimensions of superstructures, trunks, deckhouses and machinery casings to be inserted in the diagrams and tabular statement:—

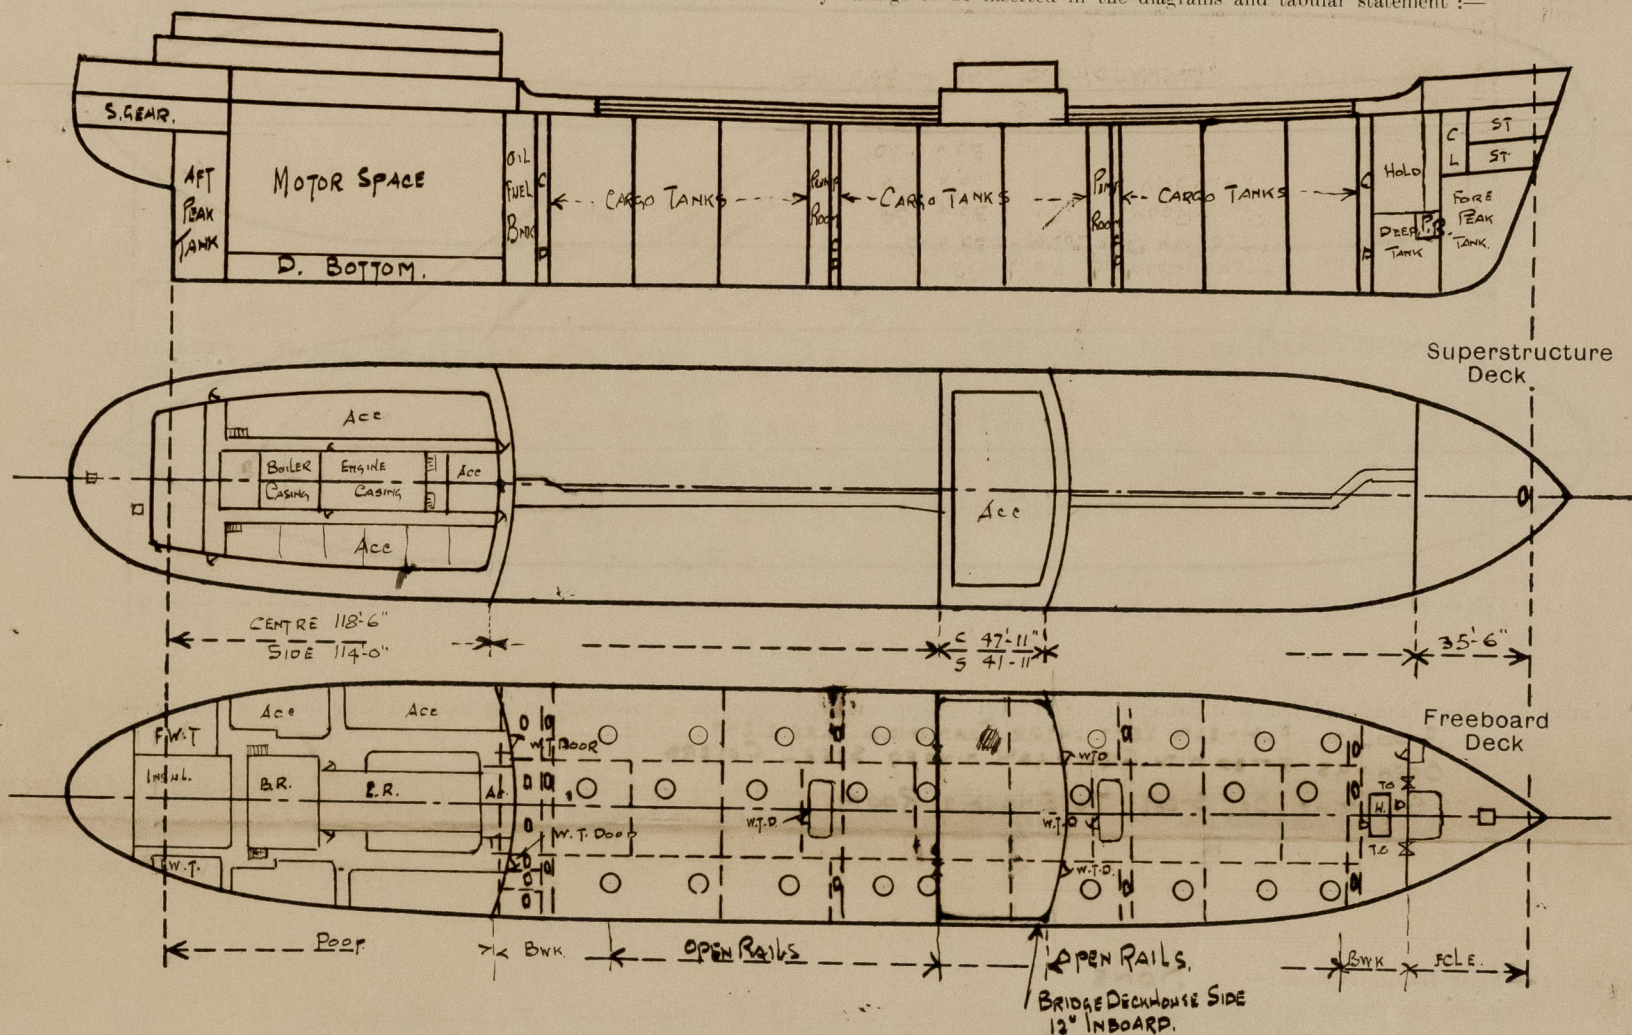

Particulars of Superstructures, Trunks, Casings, Deckhouses.

	Coaming	Plating	Stiffeners	Spacing	End Attachments of Stiffeners	Size of Openings	Height of Sills	Height of Casings
Poop Bulkhead44 ✓	.44 ✓	10 x 3 1/2 x .52 BA.	30" ✓	WELDED ✓	2 @ 5' x 2' ✓	18" ✓	7'-6" ✓
Raised Quarter Deck Bulkhead ...								
Bridge, After Bulkhead30 ✓	.30 ✓	4 x 3 1/2 FLAT (T.O.)	33" ✓	WELDED ✓	1 @ 2'6" x 1'6" ✓	36" ✓	
Bridge, Forward Bulkhead...	.44 ✓	.44 ✓	9 x 4 x .44 (T.O.)	27" ✓	WELDED ✓	2 @ 5' x 4' 1" ✓	18" ✓	7'-6" ✓
Forecastle Bulkhead...	.30 ✓	.30 ✓	9 x 4 x .47 (T.O.)	36" ✓	WELDED ✓	2 @ 5' x 3' ✓	18" ✓	7'-6" ✓
Trunk, Aft ...			4 x 36 FLAT (T.O.)	30" ✓	WELDED ✓	2 @ 5' x 4' 1" ✓	18" ✓	7'-6" ✓
Trunk, Forward ...								
Exposed Machinery Casings on Freeboard or Raised Quarter Decks...								
Exposed Machinery Casings on Superstructure Decks ...								
Machinery Casings within Superstructures not fitted with Class I Closing Appliances ...								
PUMP ROOM ENTRANCE FWD	.40 FORE & AFT SIDES ✓	.30 AFT END ✓	5 x 3 x .320 A 1080N	27" ✓	WELDED ✓	4'6" x 2'3" ✓	24" ✓	7'-6" ✓

Particulars of Closing Appliances (state if capable of being manipulated from both sides).

Poop Bulkhead ...	2. WATERTIGHT DOORS. CAPABLE OF BEING MANIPULATED FROM BOTH SIDES ✓
Raised Quarter Deck Bulkhead ...	
Bridge, After Bulkhead ...	2. TONNAGE OPENINGS CLOSED BY BOLTED STEEL PLATES WITH HOOK BOLTS, 15" APART NOT PASSING THROUGH BULKHEAD. & ONE GASTIGHT DOOR. MANIPULATED FROM BOTH SIDES. ✓
Bridge, Forward Bulkhead ...	2. W. T. DOORS. CAPABLE OF BEING MANIPULATED FROM BOTH SIDES ✓
Forecastle Bulkhead...	1. GASTIGHT DOOR TO PUMP ROOM. CAPABLE OF BEING MANIPULATED FROM BOTH SIDES. ✓
Exposed Machinery Casings on Freeboard or Raised Quarter Decks...	2. TONNAGE OPENINGS FITTED WITH BOLTED STEEL PLATES WITH HOOK BOLTS 15" APART NOT PASSING THRO' BULKHEAD ✓
Exposed Machinery Casings on Superstructure Decks ...	
Machinery Casings within Superstructures not fitted with Class I Closing Appliances ...	
PUMP ROOM ENTRANCES FWD & AFT	STEEL W. T. DOOR TO EACH PUMP ROOM CAPABLE OF BEING MANIPULATED FROM BOTH SIDES. ✓

PARTICULARS OF PROTECTION TO OPENINGS, ETC.

HATCHWAYS ON FREEBOARD AND SUPERSTRUCTURE DECKS.									
Description of Hatchway			OIL TIGHT CARGO HATCHES	CARGO HATCHES					
Dimensions of Hatchway			27' 4' 0" DIA.	16' x 12' x					
COAMINGS	Height above Deck	...	15" x	30" x					
	Thickness { Sides75 x	.44 x					
	Stiffeners		5x3x36 O.F. x					
	Brackets, Stays	...		WELDED TO & ON VERTICAL FLAT BAR STIFFS ON COAMING					
HATCH BEAMS	Number	✓						
	Spacing							
	Scantling and Sketch	...							
FORE AND AFTERS	Bearing Surface	...	✓						
	Number							
	Spacing							
HATCH COVERS	Material	HINGED STEEL	HINGED STEEL W.T. COVER					
	Thickness	...	COVER	40 STIFF BY					
	How fitted	...	50 THICK	5x3x34 O.F. WELDED TO & ON 2' 0" APART					
	Bearing Surface	...	SECURED BY TOGGLES	SECURED BY TOGGLES					
Spacing of Cleats			...	15' APART					
Number of Tarpaulins			...	15' APART					
<p>*Are wood fore and afters steel shod at all bearing surfaces? ✓</p> <p>Are battens and wedges efficient and in good condition? ✓</p> <p>Are tarpaulins in good condition and in accordance with rule requirements? ✓</p> <p>Are lashings provided in accordance with rule requirements? ✓</p>									

Particulars of any special features :—



© 2021

Lloyd's Register Foundation