


# SELF PROPELLED ALL WELDED CANAL BARGE

CLASSIFICATION: LLOYD'S CLASS + A1, CARRYING  
 PETROLEUM SPIRIT IN BULK.  
 FOR SERVICE ON THE RIVER HUMBER,  
 TRENT CANALS & AIRE & CALDER CANALS.  
 ALL WELDED CONSTRUCTION.  
 STIFFENED FOR LYING AGROUND.

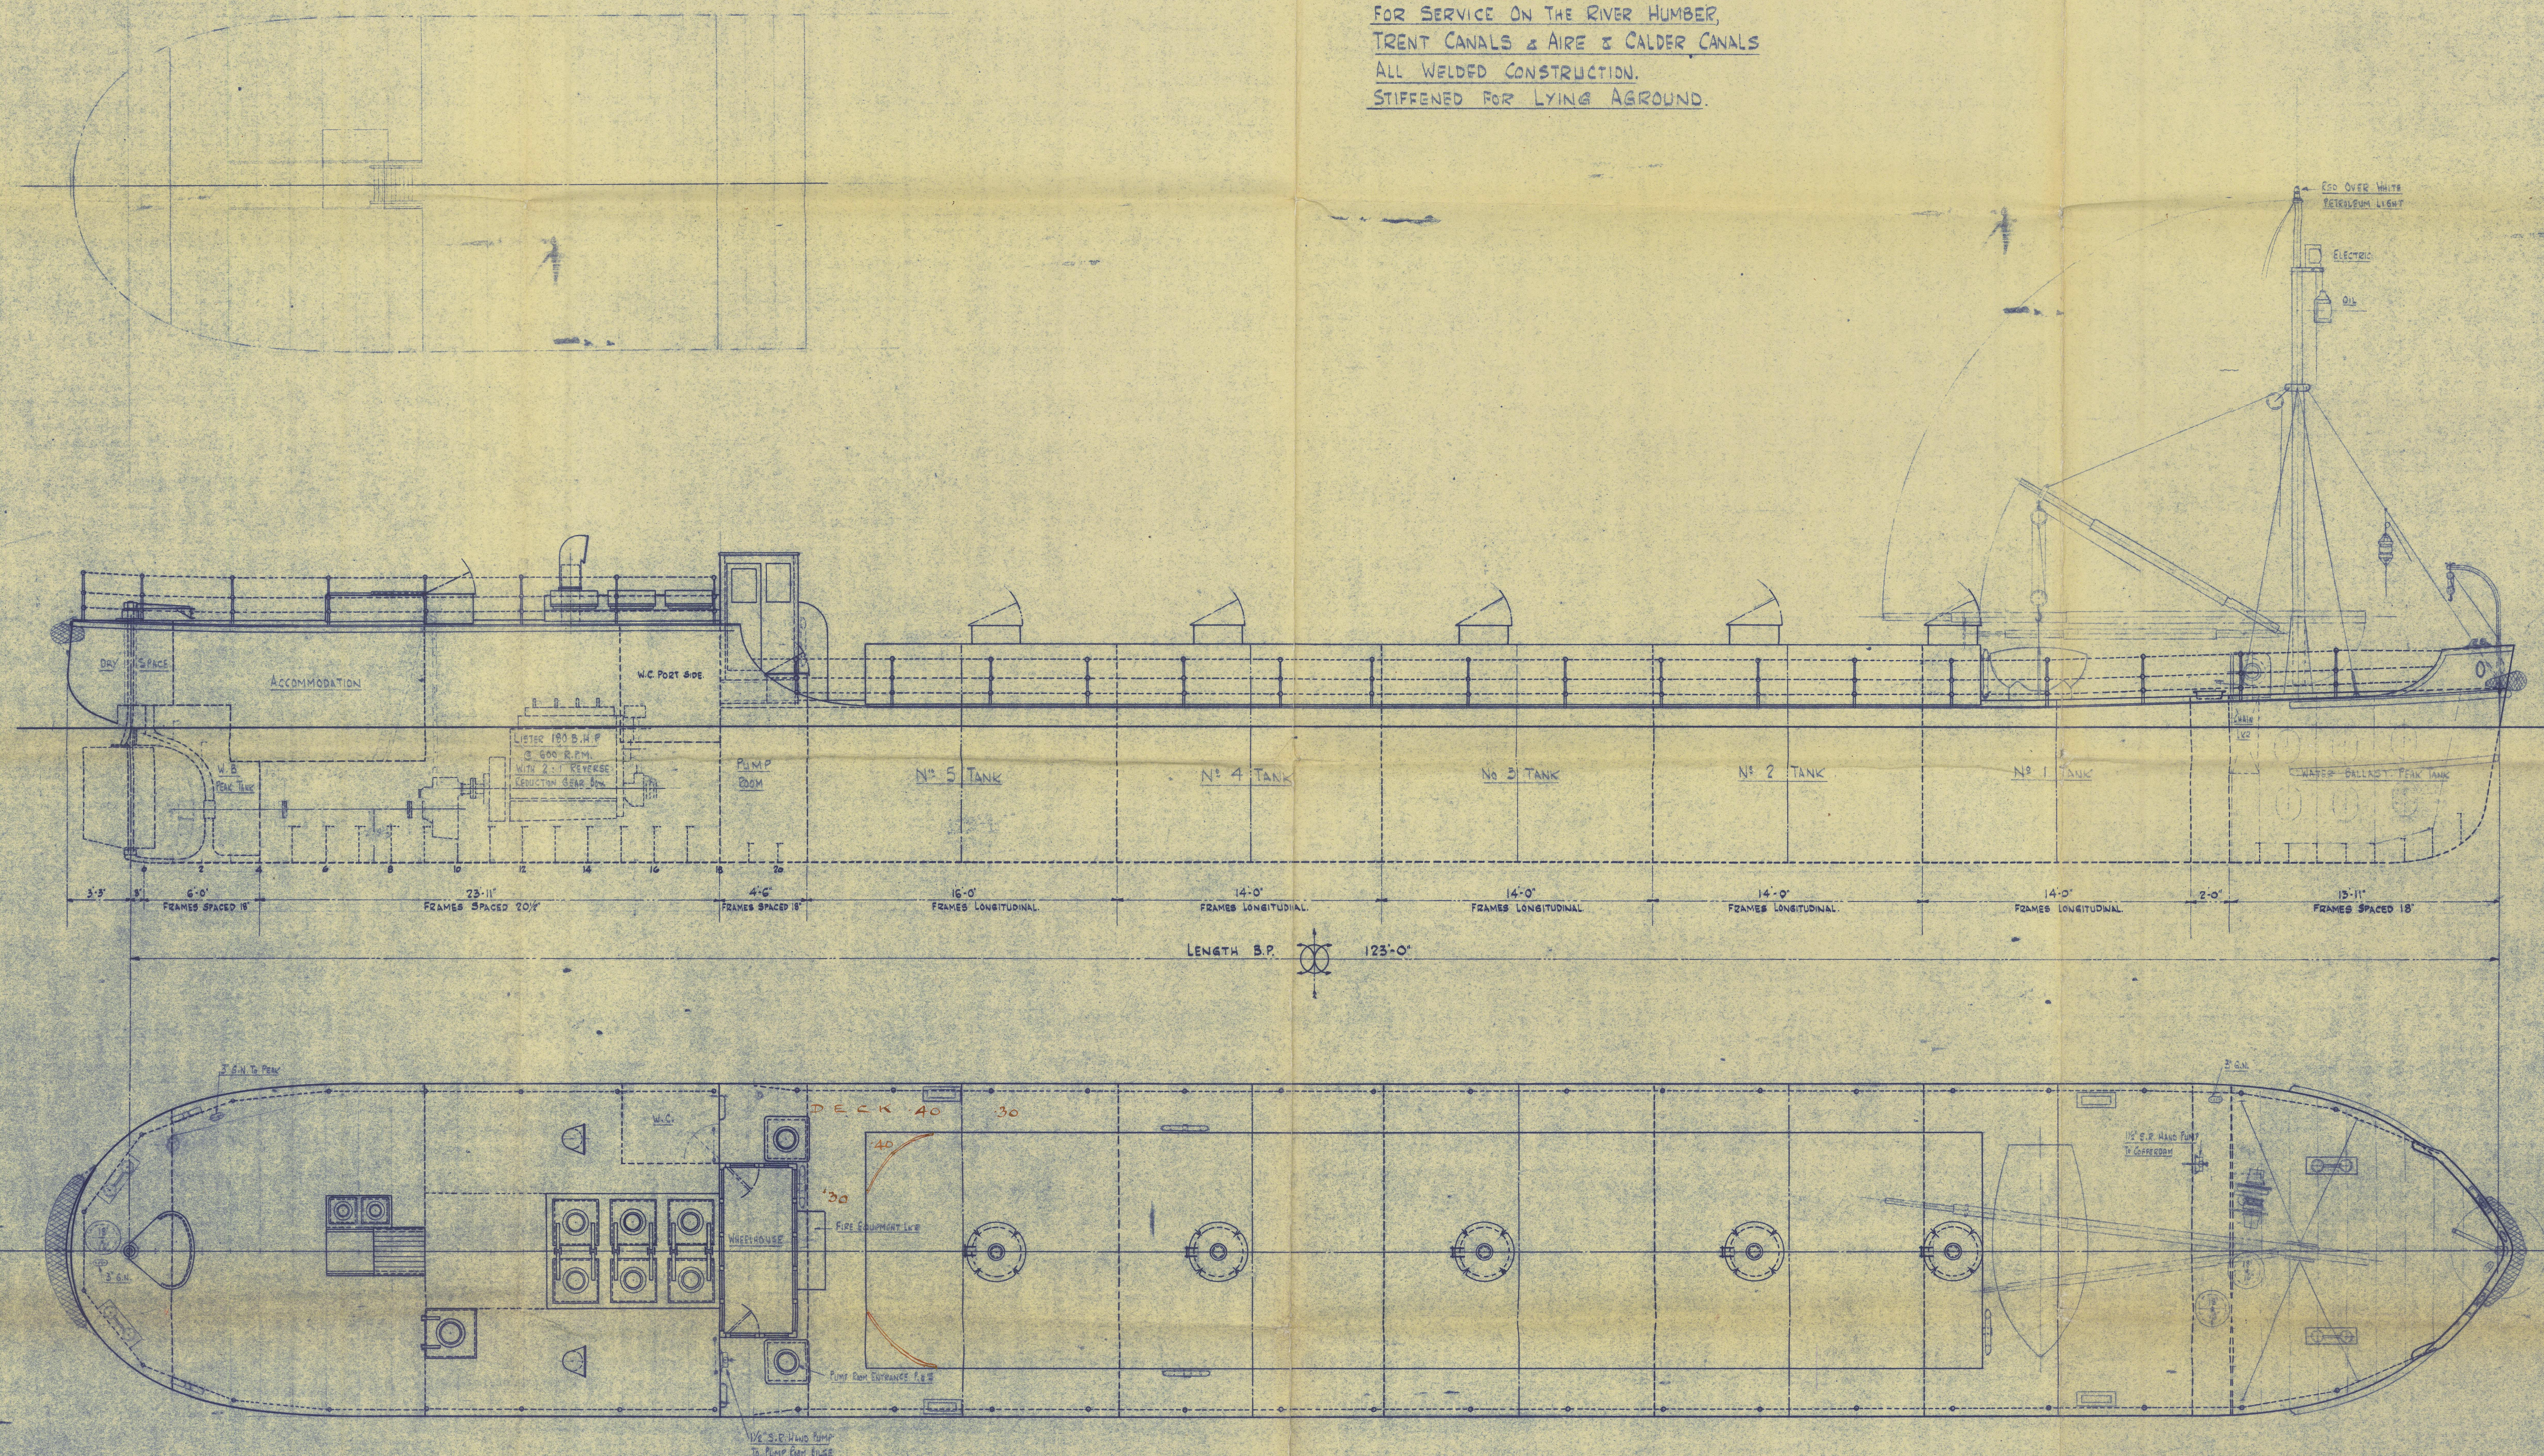

DIMENSIONS:-  
 LENGTH B.P. 123'-0"  
 BREADTH MLD. 17'-3"  
 DEPTH MLD. 8'-0" To MAIN DECK  
 12'-3" To R.Q. DECK

RICHARD DUNSTON LTD.  
 SHIPBUILDERS,  
 THORNE, YORKSHIRE.

DRAWN BY	DATE
TRACED BY	DATE
CHECKED BY	DATE
REVISIONS	
No.	DATE
PARTICULARS	

This Drawing and the Information it contains are the Property of RICHARD DUNSTON LTD. It is not to be Traced, Copied or Published without their Written Consent, nor is the Information thereon to be misused in any way.

YARD No T. 914-16 DRG. No 5567/3

TITLE:- GENERAL ARRANGEMENT

SCALE:- 1/4" TO ONE FOOT




Esso LEEDS. ★


Richard Dunstan Ltd.,  
YARD No 914

Hull F.R. Repair No 62347.

RECORDS DEPT.  
LONDON.

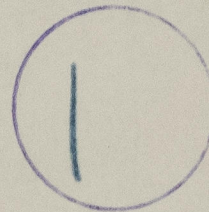

GENERAL ARRANGEMENT

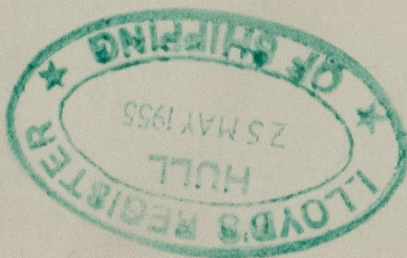

012853-012860-0154



© 2021

Lloyd's Register  
Foundation