



In Line

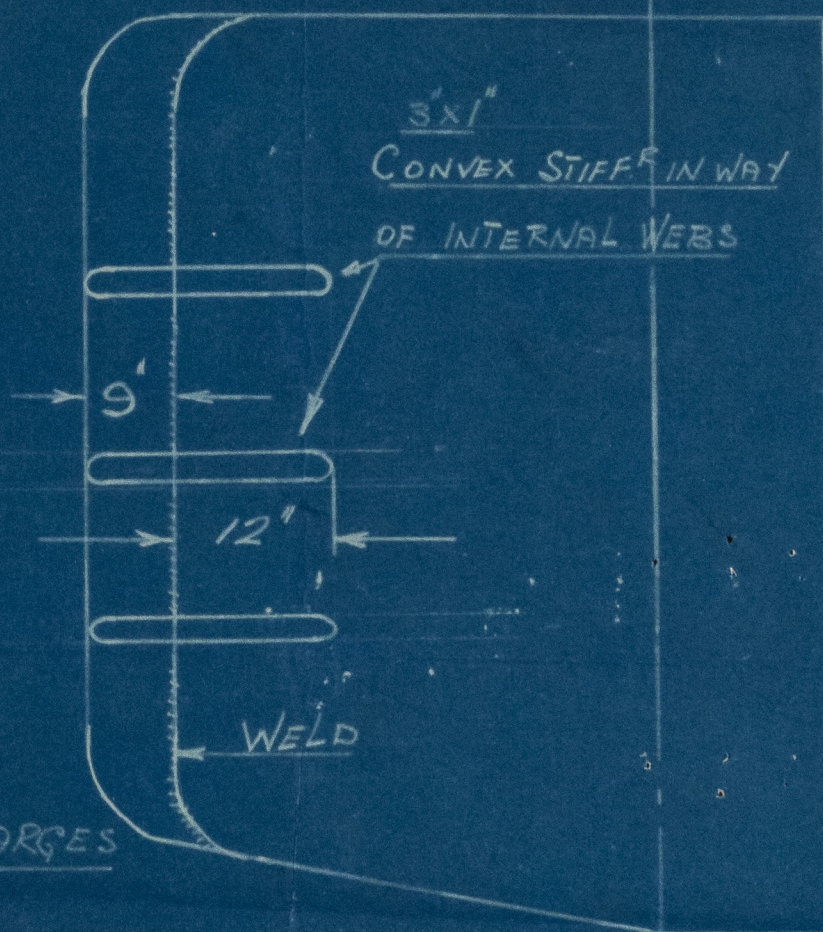

MATERIAL: MILD STEEL  
THICKNESS  $\frac{3}{4}$ "

TO BE WELDED TO EXISTING  
RUDDER AS SHOWN

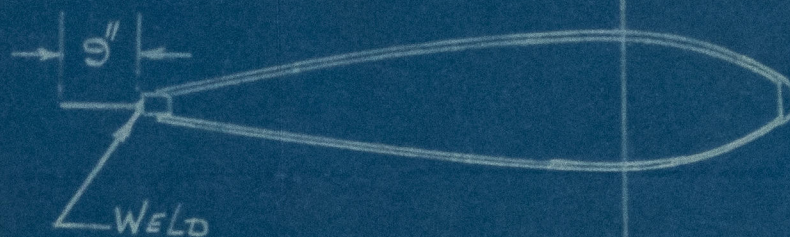

ESSO PETROLEUM CO LTD

225 TONS DWT POWER BARGES

M.V. ESSO LEEDS



Lloyd's Register  
Foundation

012853-012860-0180



"Esso Seeds"

SIMS
<del>Hull Rpt. 8/11</del> No. 6326 2
Date
SUBJECT:-

"Esso Nottingham"

Hull Rpt. No. 63347

Aug 1954

63262  
Esso Seeds



© 2021

Lloyd's Register  
Foundation

012853-012860-0180