


SEPT. 1957

# ESSO SALTEND.

## AS FITTED ARRANGEMENT OF HAND STEERING.

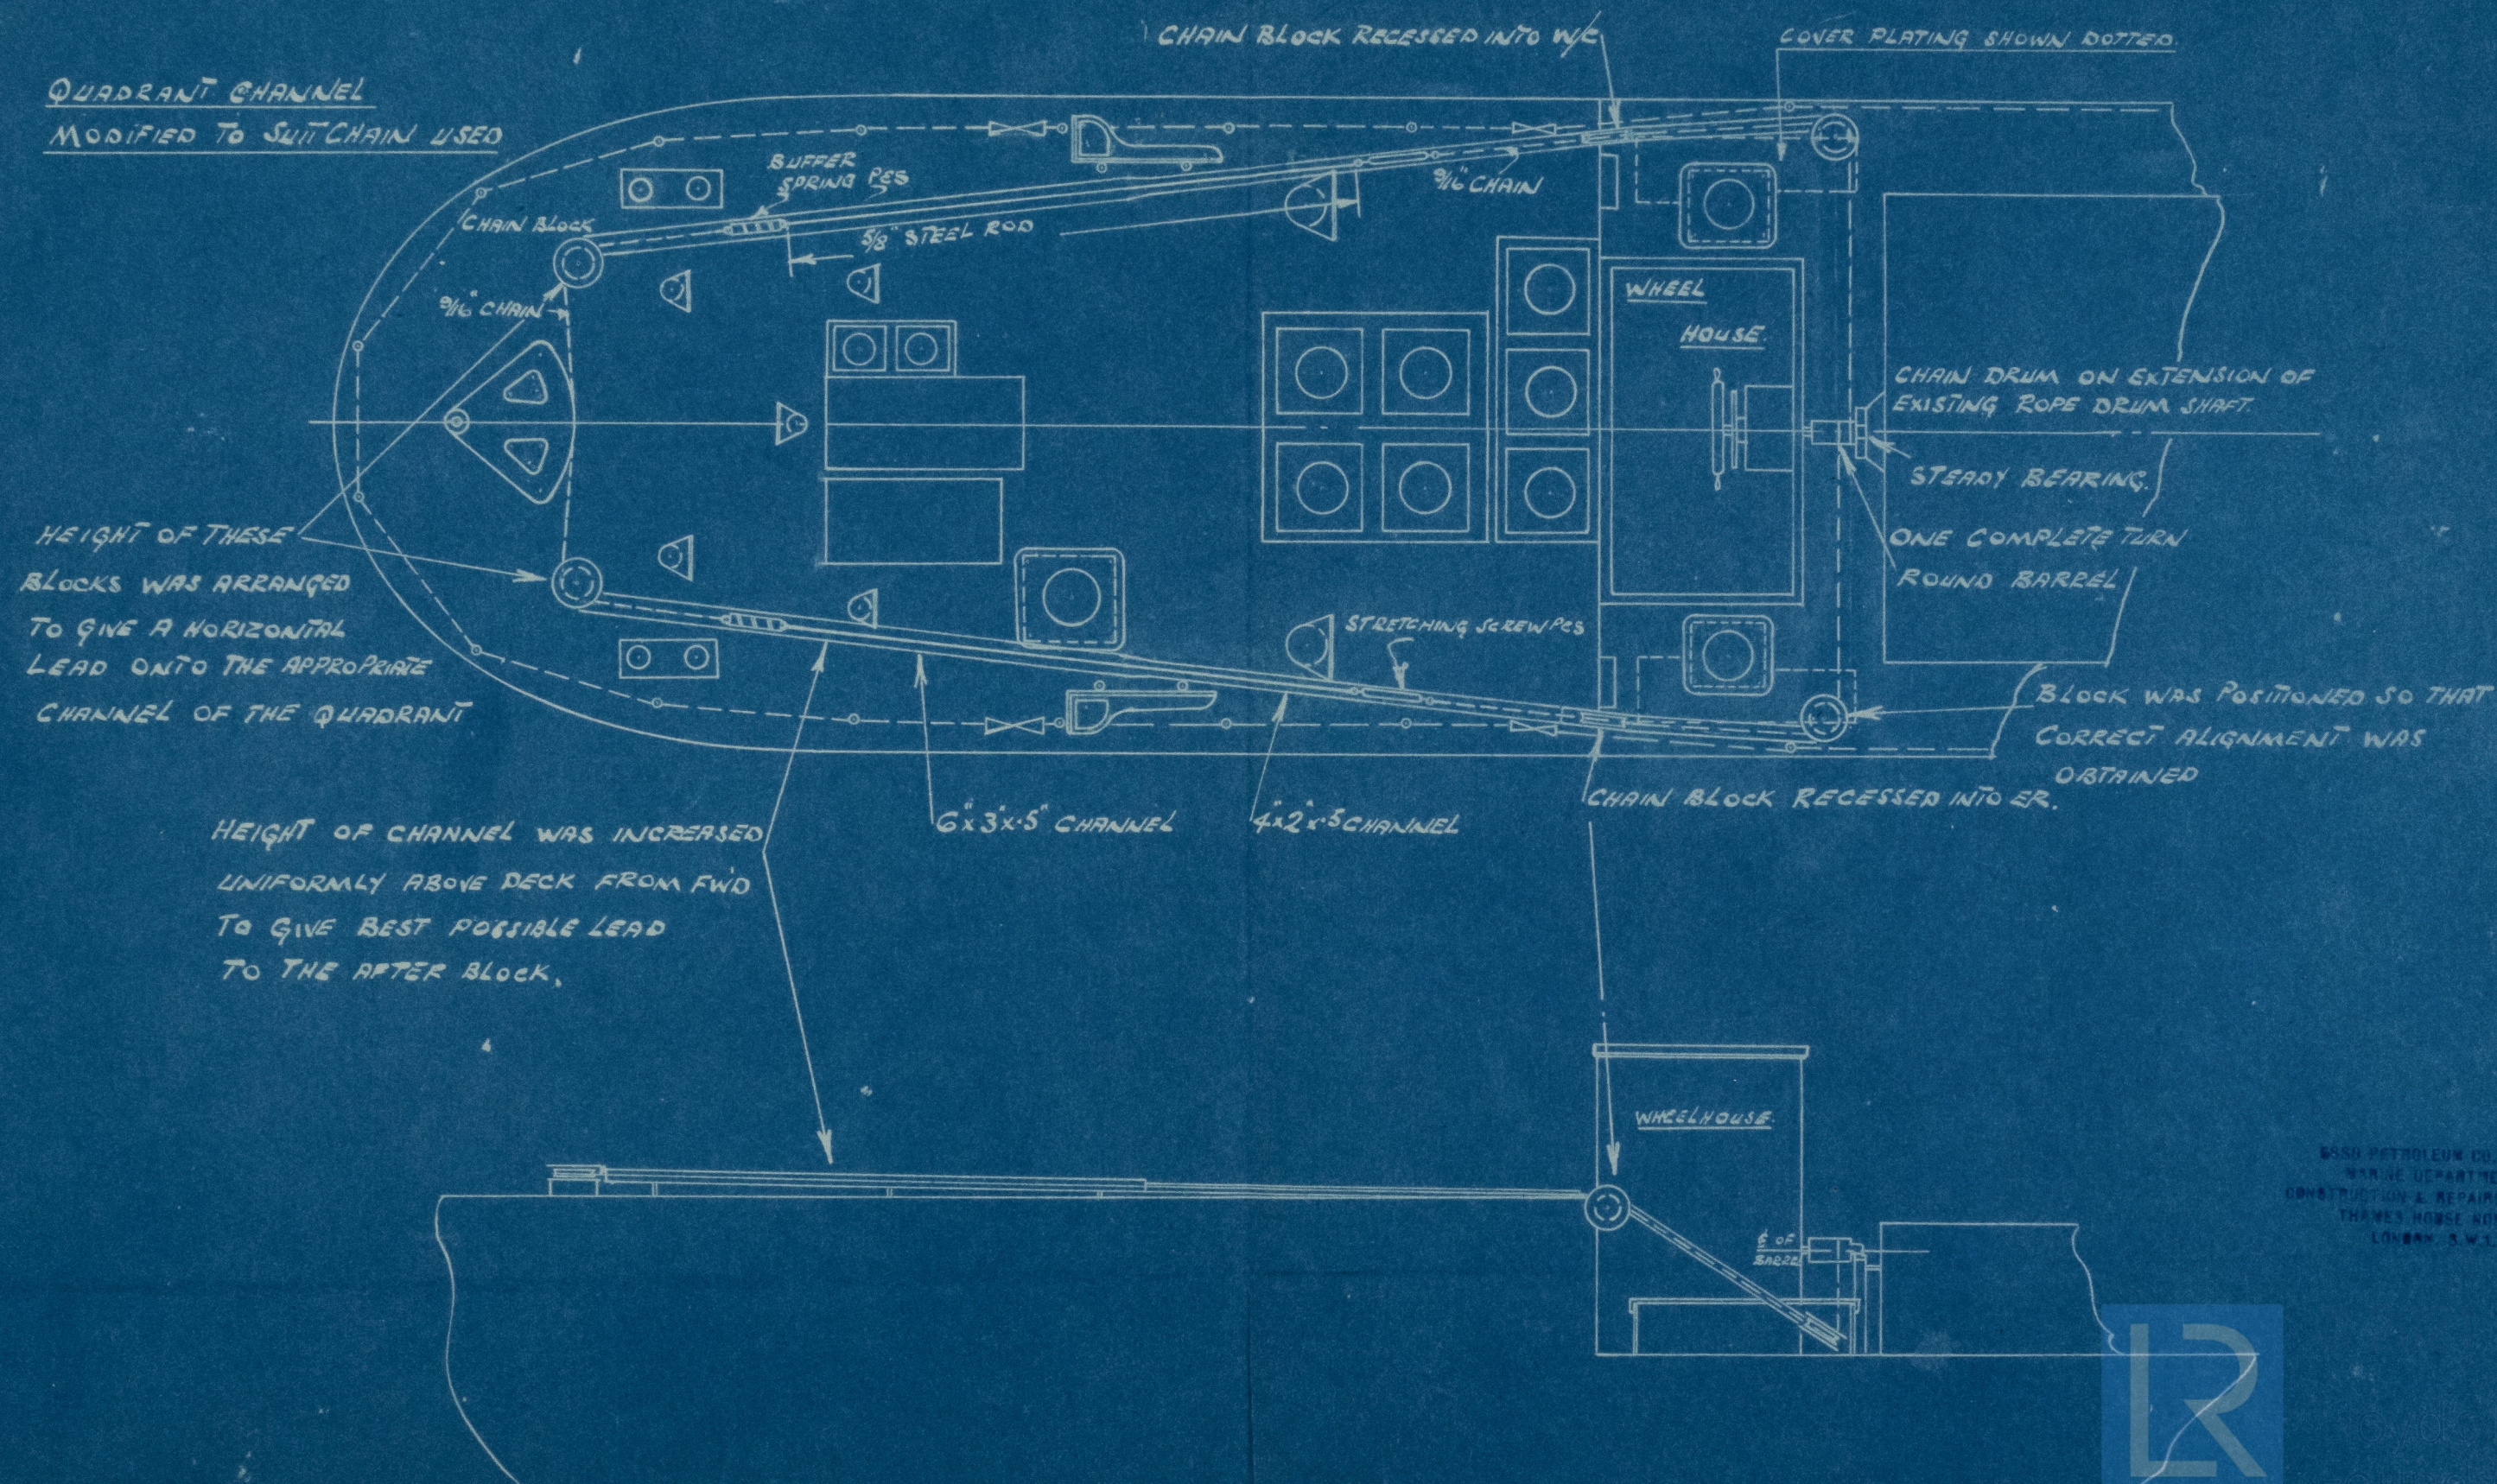

ESSO PETROLEUM CO., LTD.,  
MARINE DEPARTMENT,  
CONSTRUCTION & REPAIRS DIVISION  
THAMES HOUSE NORTH,  
LONDON, S.W.1.



012853-012860-0181



ESSO PETROLEUM CO., LTD.,  
MARINE DEPARTMENT,  
CONSTRUCTION & REPAIRS DIVISION,  
THAMES HOUSE NORTH,  
LONDON, S.W.1.

M/MS " ESSO LEEDS "	
TO ACCOMPANY HULL	Rpt. No 63263
Dated 7-57	
SUBJECT:- Steering gear Arrangements.	



© 2021

Lloyd's Register  
Foundation

012853-012860-0181