

S/T "Esso Dublin" 
C. R. D. A. - Yard N. 1849
Trieste 1st Entry Report N. 15215

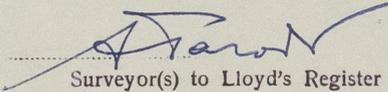
STERN FRAME / 2

(ADDITIONAL SECTIONS IN UPPER PART)

RECORDS DEPT.
LONDON.

5

THIS PLAN HAS BEEN VERIFIED WITH THE APPROVED PLANS AND INCLUDES ANY MODIFICATIONS AND/OR ADDITIONS TO THE ORIGINAL APPROVED ARRANGEMENTS MADE DURING CONSTRUCTION WHICH HAVE BEEN APPROVED LOCALLY AS BEING IN ACCORDANCE WITH OR BY STANDARD EQUIVALENT TO RULE REQUIREMENTS.

Signature 
Surveyor(s) to Lloyd's Register of Shipping

Date 26th June 1960



© 2021

Lloyd's Register
Foundation

012861-012867-0035