

M/s Brunsnæs

Middelspant

etter Opmaaling

1:15

Dimensioner:

Kendingslangde	36.070 m	118'
Bredde moulded	6.900 m	22.62'
Dybde moulded	2.540 m	8.33'

CLASS BS (COASTING SERVICE)

APPROXIMATE SUMMER MOULDED DRAUGHT 7'-6"

EQUIPMENT GRADE C12

DRAGHT SPEED NOT TO BE LESS THAN 7 KNOTS.

Shearstrake $43 \times (34 + 0.1) = 43 \times 35$

Deck area = $0.88 \times 22.62 \times 7.5 = 15.0$
 $59'' = .25''$
 $dim .27''$

Frame NF = $1.65 (3.25 + \frac{5 \times 8}{100}) = 6 \times \frac{2}{3} = 4$

2 $6.3 + 1 = 7.3 = 3 \frac{1}{2} \times 24$ OA

.32 - 0.8

3.45
1.94
1.51

Stow l = $21.8 + 1 = 22.8'$

NG = $1.65 \times 7.5 \times 9 = 11.1$ Value = 14.4.

Depth = $22.8 \times 7.5 = 17.1''$

13.5" off seat


Value off seat = 7.3

$2.16 \times 20 \times 6.7 = \frac{29}{10.2}$

7.3 Gled rule

M = $22.62^2 \times 1.65 \times 7.5 \times .0024 = 15.2$

= $13 \frac{1}{2} \times 26$ at $2 \frac{1}{2} \times 2 \frac{1}{2} = .35$ angles

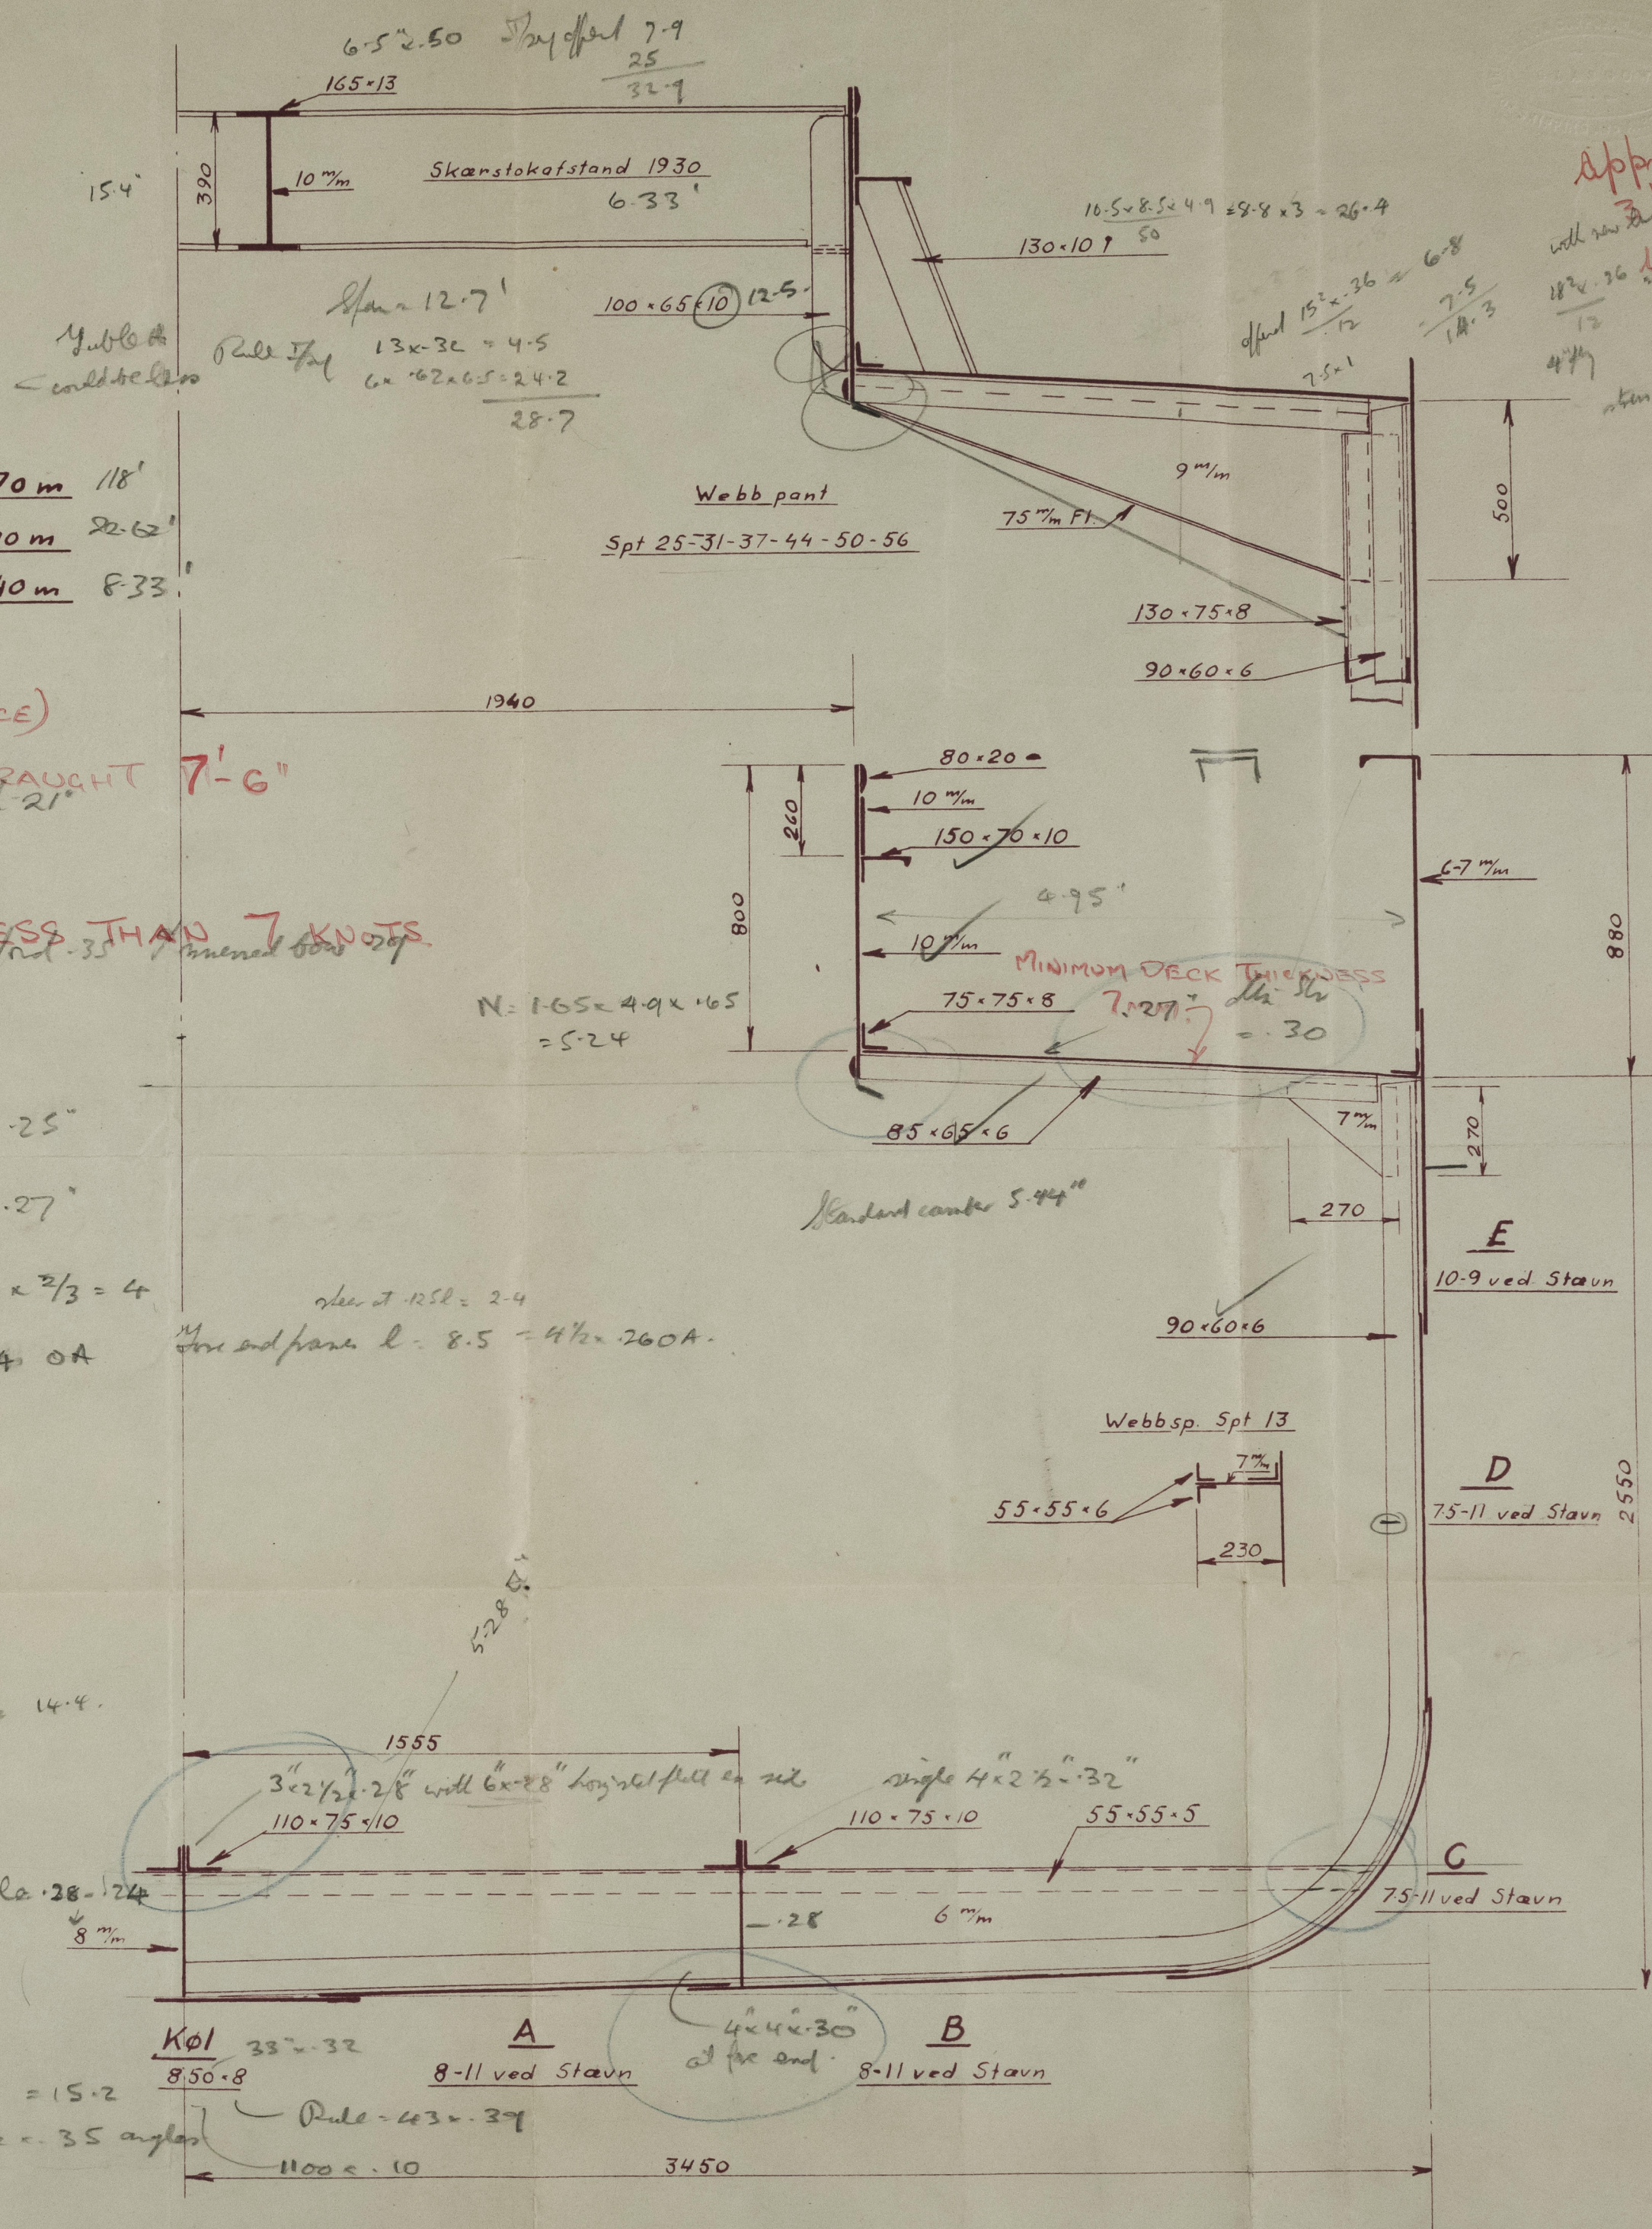

114 NOV 1947

60/6

Approved
3/12/47
with new 2nd
1824.36
12
4 1/4
13
22.7
dim = 7' 10"

11.3
6.4
9

E
10-9 ved Stavn

D
75-11 ved Stavn

C
75-11 ved Stavn

B
8-11 ved Stavn

A
8-11 ved Stavn

KNUD E. HANSEN
Consulting naval architect
Resonvængs Allé 21, Copenhagen O.
C. 6442, Tria 1645, Telegr. Adr. DESIGN.

KEH 47125-1

012875-012897-0020

1
Midship Section

S/m IDUNA ex BRUNSNÆS.

Anna Hansen. 2.12.47.

Midship Section
S/m Brunsnæs

A. C. Hansen

14 NOV 1947

now IDUNA

Bay

012875-012887-0020



© 2021

Lloyd's Register
Foundation