

# Lloyd's Register of Shipping.

## SURVEYS FOR FREEBOARD.

(COMPUTATION FOR STEAMER, SAILING SHIP, TANKER.)

GRK. REPORT NO 23481.

Ship's Name <b>BIOGRAPHER.</b>	Official Number <b>183743</b>	Nationality and Port of Registry <b>BRITISH LIVERPOOL</b>	Gross Tonnage <b>APPROX 6914.50</b>	Date of Build <b>1948</b>	Port of Survey <b>GREENOCK</b>
Moulded Dimensions: Length <b>441'-11"</b> Breadth <b>57'-9"</b> Depth <b>33'-0"</b> $\text{Top of Stock } 442-9\frac{1}{2} = 442.79$				Date of Survey <b>WHILE BUILDING 1948</b>	
Moulded displacement at moulded draught = 85 per cent. of moulded depth <b>15188</b> tons				Surveyor's Signature <b>Kenneth Inglis</b>	
Coefficient of fineness for use with Tables <b>.741</b>				Particulars of Classification <b>+100 A.1. (CONTEMPLATED)</b>	

Depth for Freeboard (D).	Depth correction.	Round of Beam correction.
Moulded depth ... <b>33'-0"</b>	(a) Where D is greater than Table depth (D - Table depth) R = <b>(33.03 - 29.52) 3 = +10.53'</b>	Moulded Breadth (B) <b>57.75'</b>
Stringer plate <b>(Mean = 80) ... 41 ... 03</b>	(b) Where D is less than Table depth (if allowed) (Table depth - D) R = <b>3.51</b>	Standard Round of Beam = $\frac{B \times 12}{50} = \mathbf{13.86''}$
Sheathing on exposed deck $T \left( \frac{L-S}{L} \right) =$	If restricted by superstructures <b>✓</b>	Ship's Round of Beam = <b>14 1/2''</b>
Depth for Freeboard (D) = <b>33.03</b>		Difference = <b>.64''</b>
		Restricted to
		Correction = $\frac{\text{Diff}}{4} \times (1 - \frac{S_1}{L}) = \mathbf{\frac{.64}{4} \times .474 = -.08''}$

## DEDUCTION FOR SUPERSTRUCTURES.

	Mean Covered Length (S)	Equivalent Enclosed Length (S <sub>1</sub> )	Height	Height Correction	Effective Length (E)
Poop enclosed ...	<b>48.12</b>	<b>48.12</b>	<b>7'-11 1/2"</b>	<b>✓</b>	<b>48.12</b>
„ overhang ...	<b>48.12</b>		<b>+ 3' Wood</b>		
R.Q.D. enclosed ...					
„ overhang <b>EQ. 11</b>	<b>140.43</b>				
Bridge enclosed <b>See Sketch</b>	<b>141.9</b>	<b>140.43</b>	<b>7'-11 1/2"</b>	<b>✓</b>	<b>140.43</b>
„ overhang aft ...	<b>332.30</b>	<b>2.49</b>	<b>7'-11 1/2"</b>	<b>✓</b>	<b>2.49</b>
„ overhang forward	<b>83.18</b>	<b>.41</b>			<b>.41</b>
Fore enclosed ...	<b>41.5</b>	<b>41.42</b>	<b>7'-11 1/2"</b>	<b>✓</b>	<b>41.42</b>
„ overhang ...	<b>41.42</b>				
Trunk aft ...					
„ forward ...					
Tonnage opening aft ...					
„ „ forward					
Total ...	<b>234.12</b>	<b>232.87</b>			<b>232.87</b>

Standard Height of Superstructure	<b>7.60'</b>
„ „ R.Q.D.	<b>✓</b>
Deduction for complete superstructure	<b>42.00''</b>
Percentage covered $\frac{S}{L} =$	<b>52.88</b>
„ „ $\frac{S_1}{L} =$	<b>52.59</b>
„ „ $\frac{E}{L} =$	<b>✓</b>
Percentage from Table, Line A. (corrected for absence of forecastle (if required))	<b>✓</b>
Percentage from Table, Line B. (corrected for absence of forecastle (if required))	<b>38.59</b>
Interpolation for bridge less than 2L (if required)	<b>✓</b>
Deduction = $42.00 \times .3859 =$	<b>-16.21''</b>

## SHEER CORRECTION.

Station	Standard Ordinate	S	M	Product	Actual Ordinate	Effective Ordinate	S	M	Product
A.P. ...	<b>54.28</b>	<b>1</b>	<b>✓</b>	<b>54.28</b>	<b>69</b>	<b>69.00</b>	<b>1</b>	<b>✓</b>	<b>69.00</b>
1/4 L from A.P. ...	<b>24.16</b>	<b>4</b>	<b>✓</b>	<b>96.64</b>	<b>30.62</b>	<b>30.62</b>	<b>4</b>	<b>✓</b>	<b>122.48</b>
1/2 L „ ...	<b>5.97</b>	<b>2</b>	<b>✓</b>	<b>11.94</b>	<b>7.37</b>	<b>7.37</b>	<b>2</b>	<b>✓</b>	<b>14.74</b>
Amidships ...	<b>✓</b>	<b>4</b>	<b>✓</b>	<b>✓</b>	<b>0</b>	<b>✓</b>	<b>4</b>	<b>✓</b>	<b>✓</b>
3/4 L from F.P. ...	<b>11.94</b>	<b>2</b>	<b>✓</b>	<b>23.88</b>	<b>13.5</b>	<b>13.50</b>	<b>2</b>	<b>✓</b>	<b>27.00</b>
1/4 L „ ...	<b>48.31</b>	<b>4</b>	<b>✓</b>	<b>193.24</b>	<b>53</b>	<b>53.00</b>	<b>4</b>	<b>✓</b>	<b>212.00</b>
F.P. ...	<b>108.56</b>	<b>1</b>	<b>✓</b>	<b>108.56</b>	<b>120</b>	<b>120.00</b>	<b>1</b>	<b>✓</b>	<b>120.00</b>
Total ...				<b>488.54</b>					<b>565.22</b>

Correction =  $\frac{\text{Difference between sums of products}}{18} \left( .75 - \frac{S}{2L} \right) = \mathbf{\frac{76.68}{18} \left( .75 - \frac{26.44}{48.56} \right) = -2.07''}$

If limited on account of midship superstructure. **✓**

If limited to maximum allowance of 1 1/2 ins. per 100 ft. **✓**

Deduction for Tropical Freeboard.  
Addition for Winter and Winter North Atlantic Freeboard.

Depth to Freeboard Deck = **33.03** Ft. **✓**  
 Summer freeboard = **6.73** **✓**  
 Moulded draught (d) = **26.30** **✓**

Deduction for Tropical freeboard and addition for Winter freeboard =  $\frac{d}{4}$  inches = **6.57 = 6 1/2''** **✓**  
 Addition for Winter North Atlantic Freeboard (if required) = **✓**

Deduction for Fresh Water.

Displacement in salt water at summer load water line  
 $\Delta = 26 - 139.42 = 142.5$   
 $\Delta = 27 - 145.62 = 51.39$   
 Tons per inch immersion at summer load water line  
 $T = \frac{26 - 51.17}{27 - 51.67} = \mathbf{.40}$   
 Deduction =  $\frac{\Delta}{40T}$  inches  
 $= \mathbf{6.91 = 7''}$  **✓**

TABULAR FREEBOARD corrected for Flush Deck (if required)

Correction for coefficient **68 + 74 / 1.36 = 1.421 / 1.36** **✓**

Depth Correction ... **10.53** **✓**  
 Deduction for superstructures ... **✓**  
 Sheer correction ... **✓**  
 Round of Beam correction ... **✓**  
 Correction for Thickness of Deck amidships ... **✓**  
 Other corrections, scantlings, etc. ... **✓**

**84.86**  
**88.67**

**10.53** **18.36** **- 7.83**  
 Summer Freeboard = **80.84** **✓**

SUMMER FREEBOARD amidships from Centre of Disc to top of Deck Line, Wood, Steel, Deck:—



Tropical Fresh Water Line above Centre of Disc ... **13 1/2''** **✓**  
 Fresh Water Line „ „ ... **7''** **✓**  
 Tropical Line „ „ ... **6 1/2''** **✓**  
 Winter Line below „ „ ... **6 1/2''** **✓**  
 Winter North Atlantic Line „ „ ... **✓**

Tropical Fresh Water Freeboard ... **6'-8 3/4''**  
 Fresh Water „ „ ... **5'-7 1/4''**  
 Tropical „ „ ... **6'-1 3/4''**  
 Winter „ „ ... **6'-2 1/4''**  
 Winter North Atlantic „ „ ... **7'-3 1/4''**

**10.12.48**

# Biographer.

A new form should be prepared if any alterations that affect the freeboard have been made. If no such alterations have been made, the Surveyor should endorse the form on this side with his signature and the date.

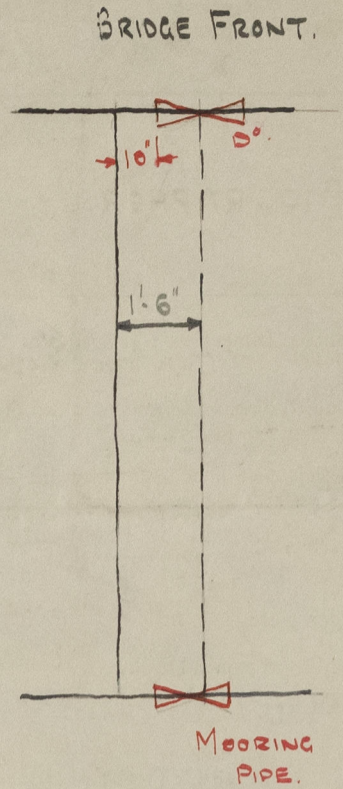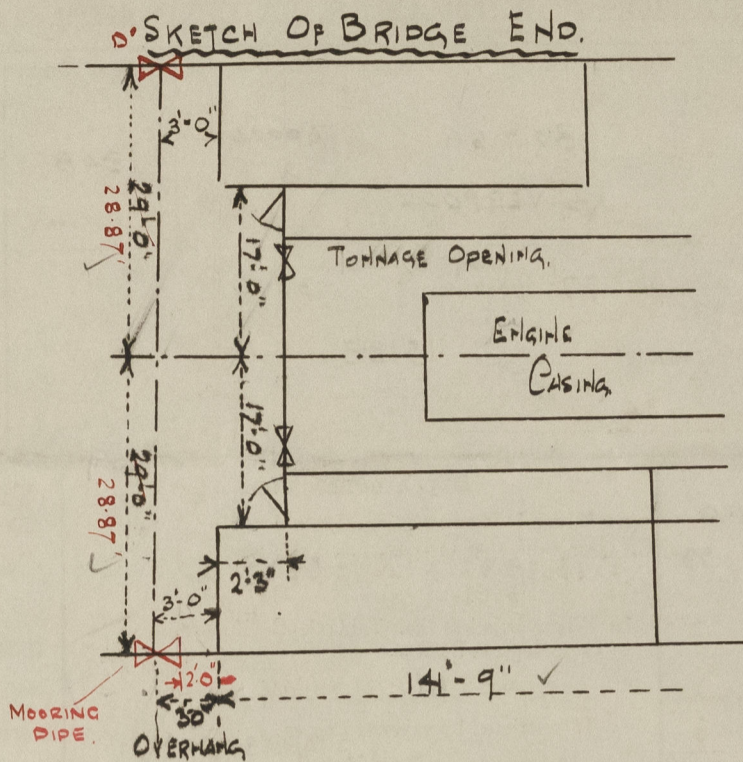

$$\begin{aligned} \text{Length of Bridge} &= 141.75' \\ \text{Recess} &= 17.0 \times 2.25 / 28.87 = 1.32' \\ 140.43 &= \text{Equiv. Enc.} \end{aligned}$$

$$\begin{aligned} O/H &= 2.00 \\ 1.32 &= O/H. \text{ aft.} \\ .83 &= O/H. \text{ Fwd.} \end{aligned}$$

Trade of ship INTERNATIONAL.

Names of sister ships ✓


Builder's name and yard number LITHGOWS LTD YARD No 1029.

Owners T & J HARRISON. LIVERPOOL.

APPROX.

Fee £ 30 0 0.

MLD

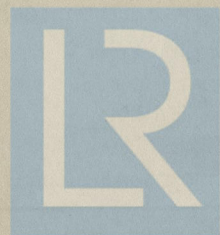

© 2021

Lloyd's Register  
Foundation