


Ship No 866
2.3.33
4.3.33

LLOYDS NUMERALS


L x D	360 x 26.75	9630
L x (B+D)	360 x (51.75 + 26.75)	28260
% UPPER DECK	300 x 26.75	13.45
% TO BRIDGE DECK	300 x 26.75	10.43

5/5
FRACTIONS 50-73%

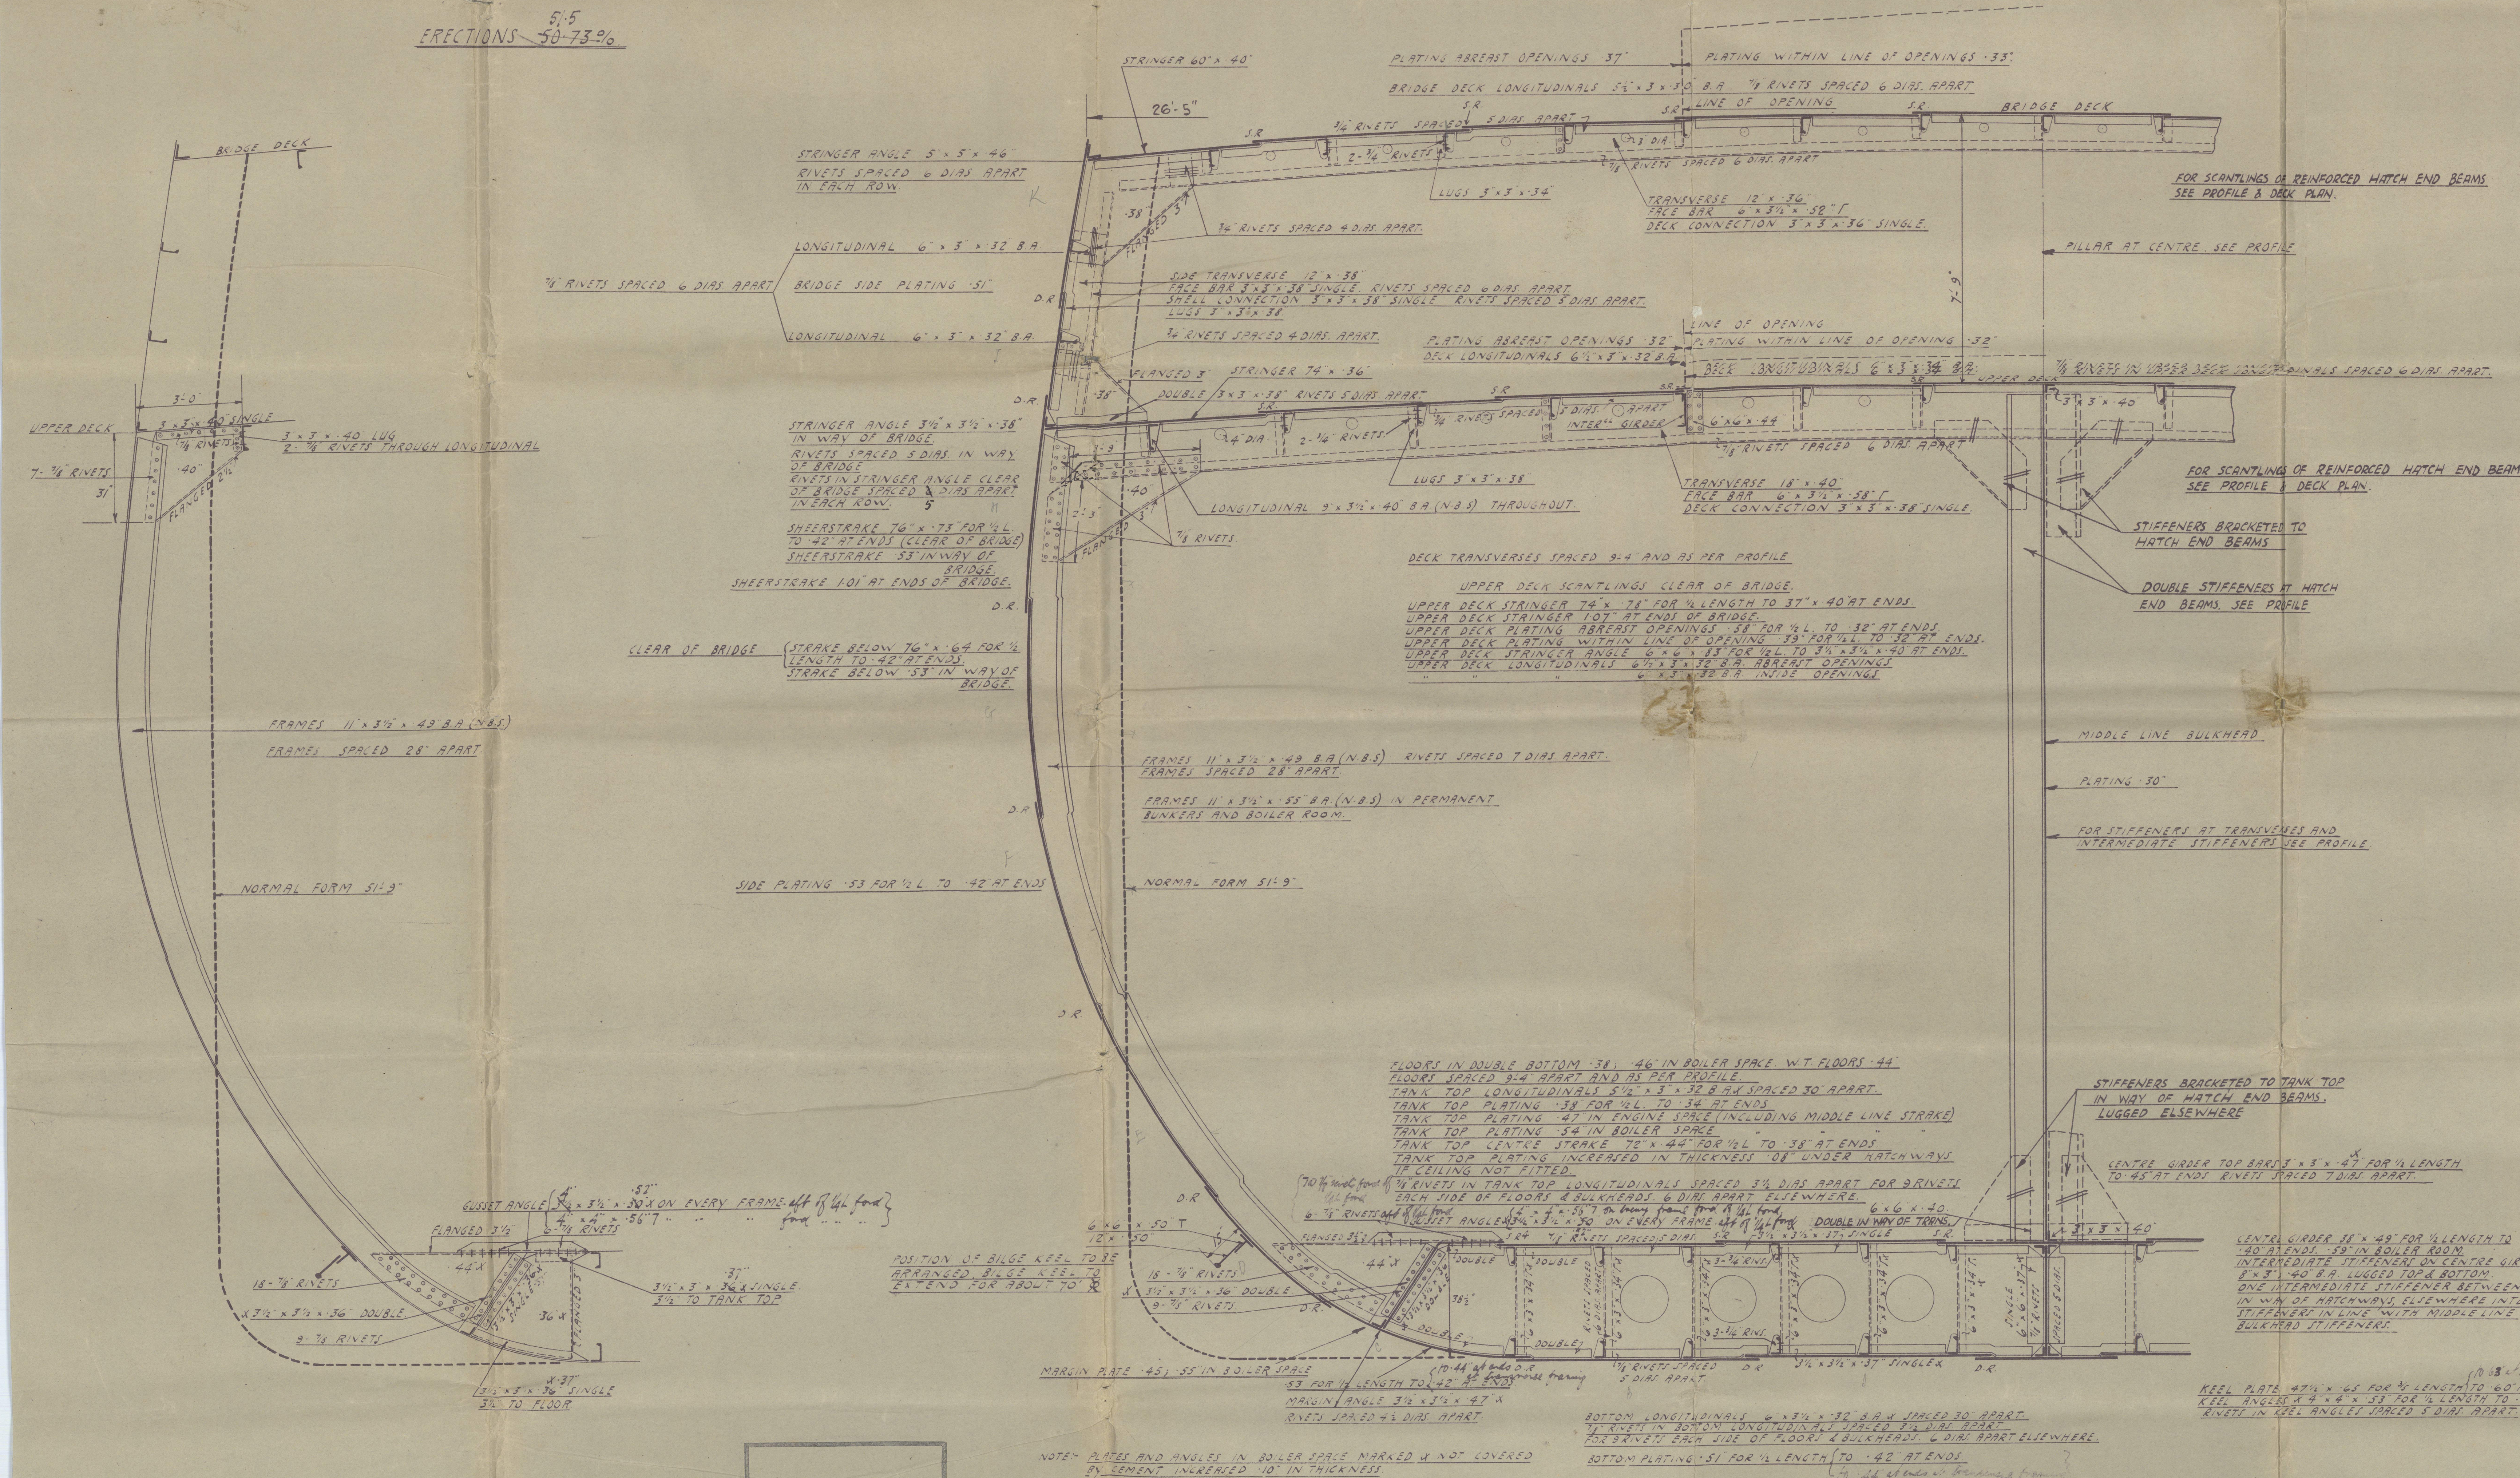

NOTCHES FOR LONGITUDINALS TO BE WELL ROUNDED AT CORNERS
AND NOT ROUGH PUNCHED.
LIGHTENING HOLES TO BE NOT LESS THAN 8" CLEAR OF NOTCHES.

SECTION IN WAY OF CARGO HATCH

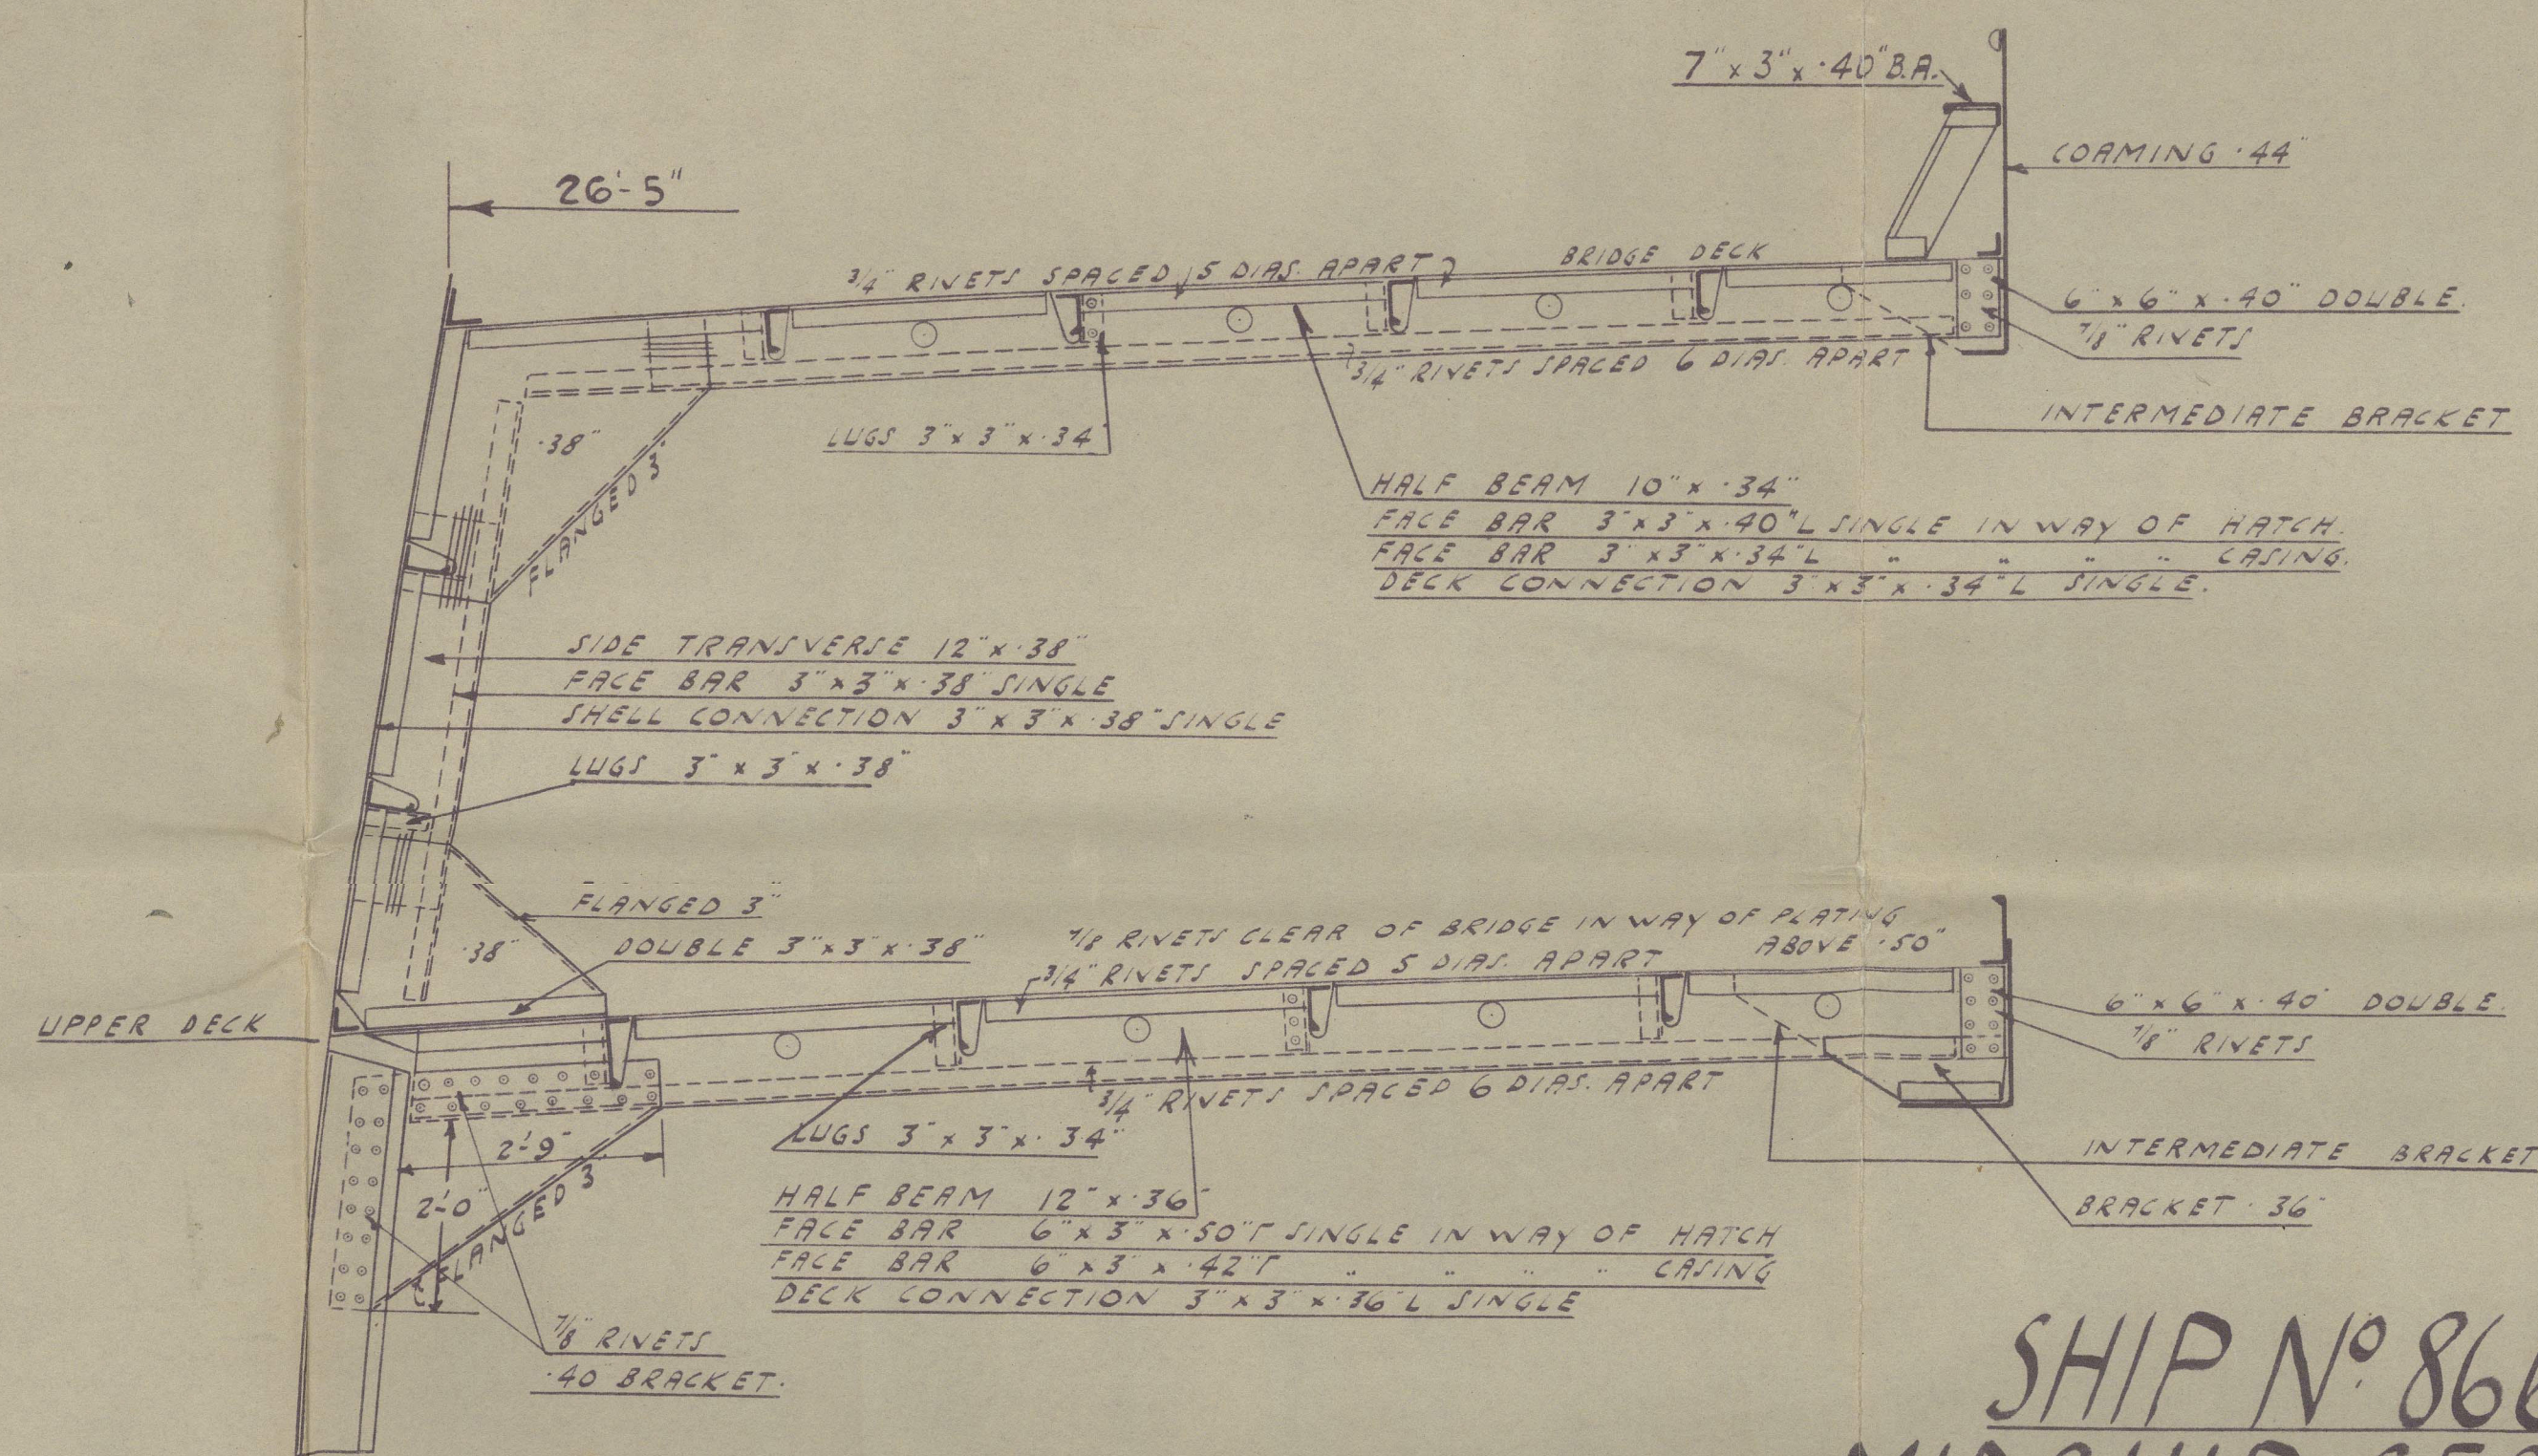


SHIP N° 866
MIDSHIP SECTION
SCALE 1/2" = 1 FOOT

DIMENSIONS. LBP 360'-0" x NORMAL BREADTH MLD. 51'-9" x DEPTH MLD. 26'-9"
MAXIMUM BREADTH MLD. 57'-3"

TO CLASS LLOYDS 100 A.I. With special material - longitudinal framing at stern & bows
N.B.S. - NEW BRITISH STANDARD.
SHERWOOD COMBINATION SYSTEM.

EQUIPMENT
EQUIPMENT NUMERAL

1. (B+D)	360 (51.75 + 26.75)	28260
2. (B+D)	360 (51.75 + 26.75)	28260
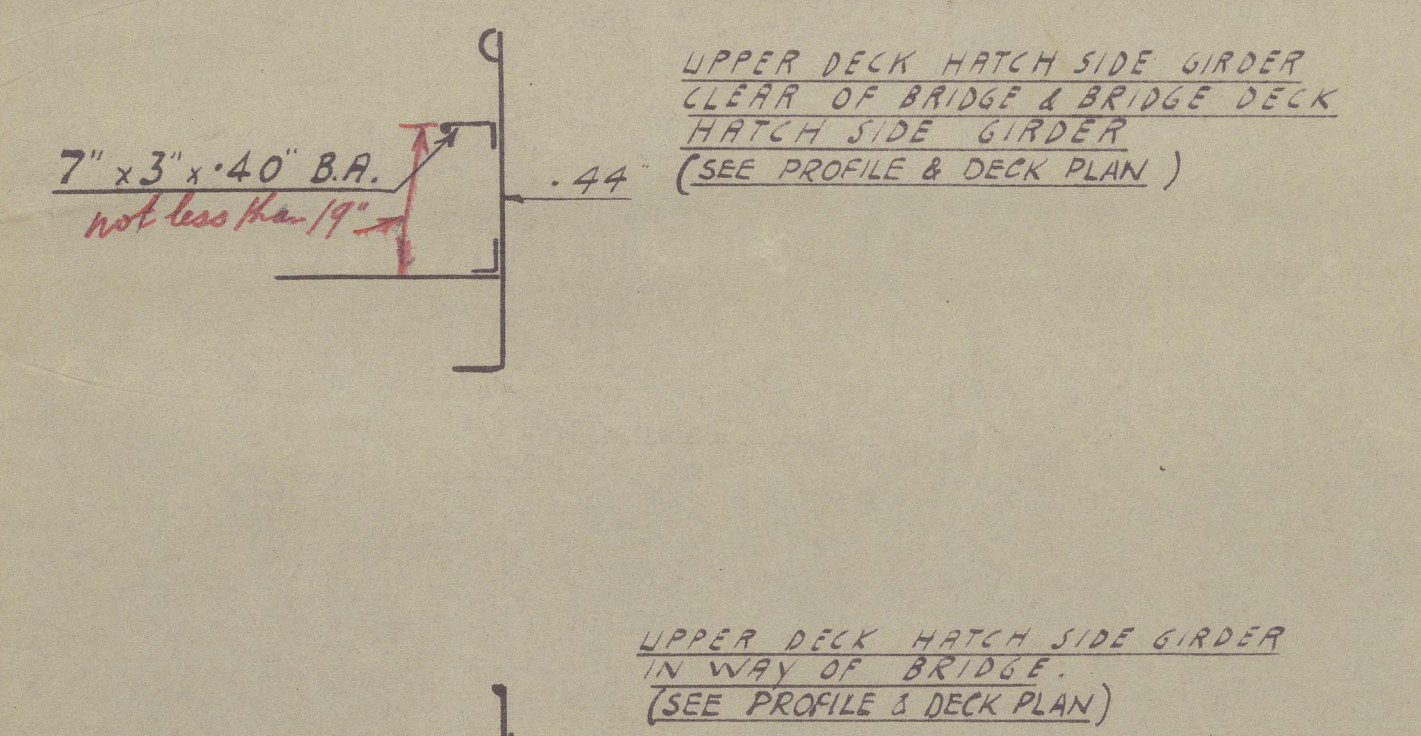

INTERMEDIATE FRAMES

LITHGOWS LTD. PORT GLASGOW
15th N° 1682
PLAN N° 2336
28.1.33

DR. JOSEPH W. SHERWOOD & CO. LTD.
4, LLOYDS AVENUE,
LONDON, E.C.8.
28.1.33.
7/5/33

LITHGOWS LIMITED.

Nº 866.

MIDSHIP SECTION.
Nº BELLATRIX.

^{EX}
S. S. "ARGGOW"

GREENOCK FIRST ENTRY REPORT Nº 19448.

Lord Byron



© 2021

Lloyd's Register
Foundation

012888-012897-0205