

SINGLE SCREW TUG "M. MORAN"

SECTIONAL PROFILE.

SCALE $\frac{1}{4}" = 1 \text{ FOOT}$.

as built.

GENERAL ARRANG^I
Foremost etc.

M. MORAN.

(AS BUILT)

Sou 10463

012898-012906-0047




© 2021

Lloyd's Register
Foundation

11/11/11

List of fittings

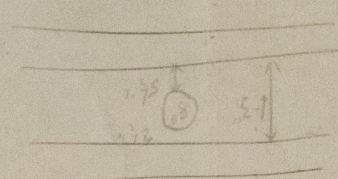

© 2021

Lloyd's Register
Foundation