


M.S. "TEN-EI MARU" GENERAL ARRANGEMENT

SCALE 1:200

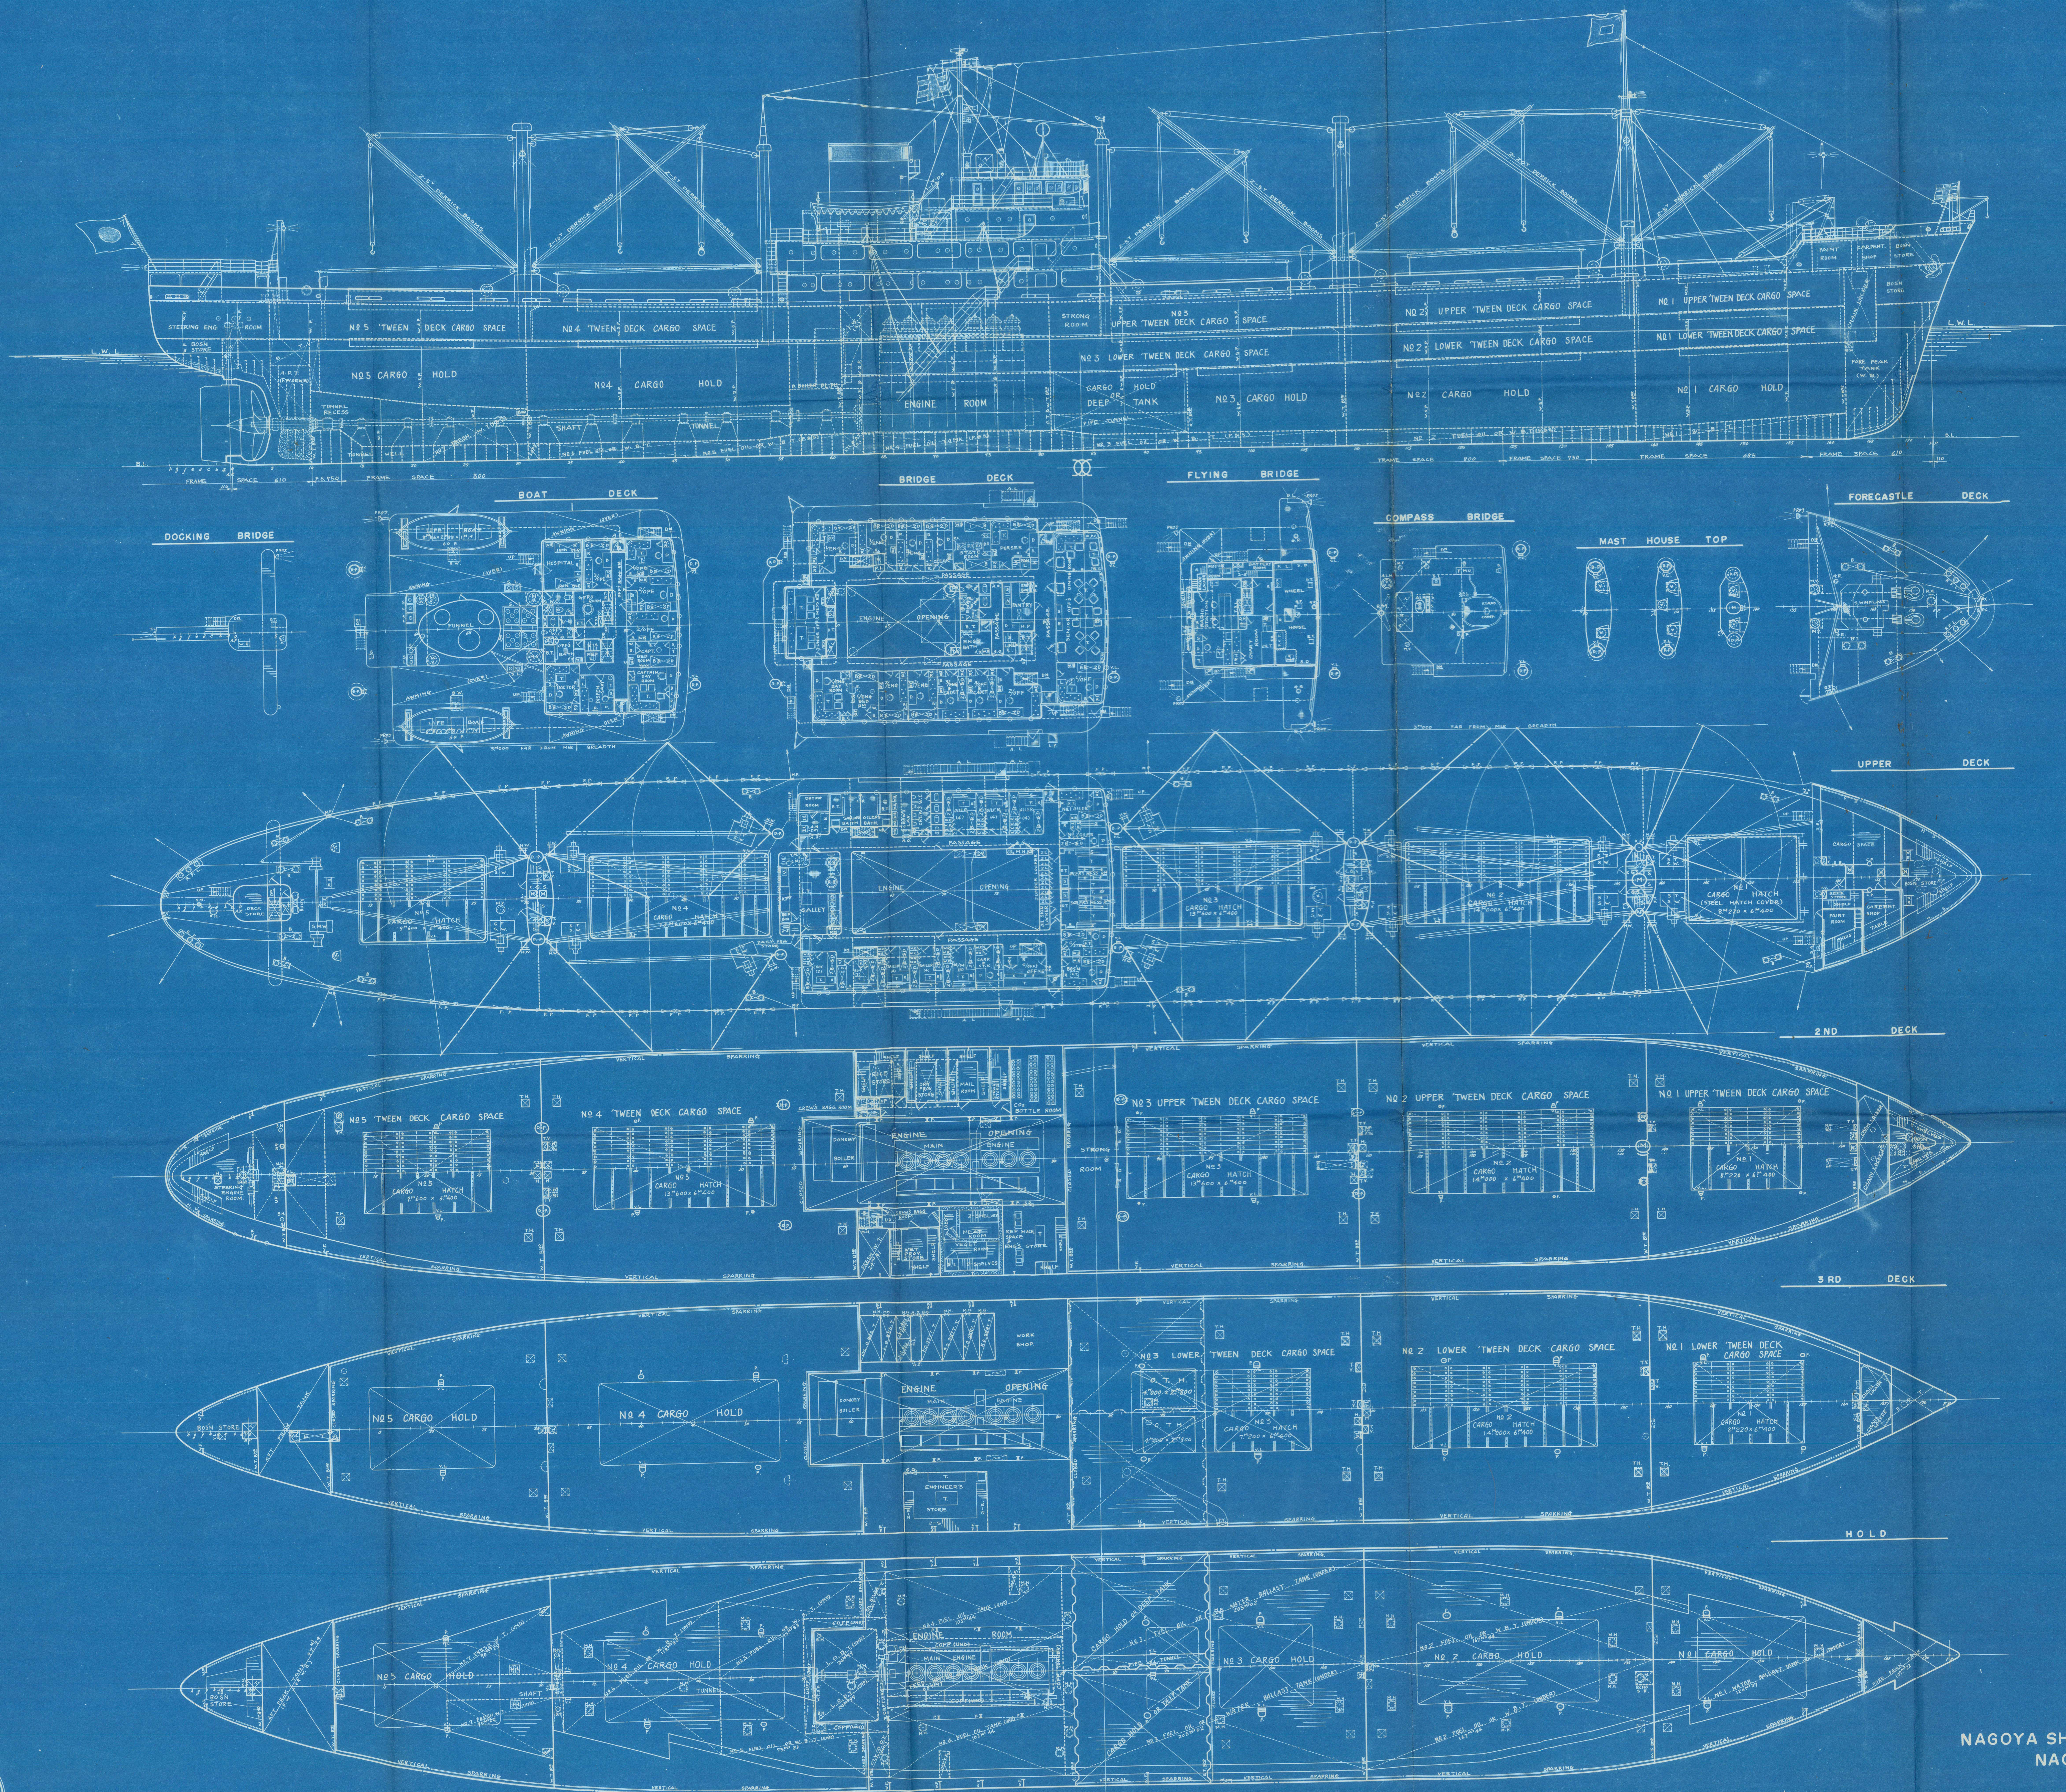

PRINCIPAL PARTICULARS	
LENGTH (OVER ALL)	139'850
LENGTH (B. P.)	130'320
BREADTH	17'800
DEPTH (MOULDED)	11'700
DRAFT LOADED	8'801
GROSS TONNAGE	7628.81
NET TONNAGE	4408.30
DEAD WEIGHT	11087.45
SEA SPEED (ABOUT)	14 3/4
MAIN ENGINE	HARIMA SULZER
	6800 BHP 114 R.P.M.


天榮丸
S.120

GENERAL
ARRANGEMENT
(FINISHED PLAN)

一般配置
(完成圖)

SCALE	1:200	DEPART.	CHIEF
ITEM	M	SUB	CHIEF
HULL DESIGNING SECTION OF DESIGNING DEPARTMENT NAGOYA SHIPBUILDING CO., LTD. NAGOYA, JAPAN			
SECTION	CHIEF	DESIGNER	CHIEF
UNIT	CHIEF	DESIGNER	CHIEF
REVISION	AUG 1ST 1955	DRAWN	CHIEF
TABLE	30.8.4		
ITEM	F-2		
N. NO.	H-10767		



NAGOYA SHIPBUILDING CO., LTD.
NAGOYA JAPAN

TEN-EI. MARU 


2
1
1

General Arr.

as fitted.

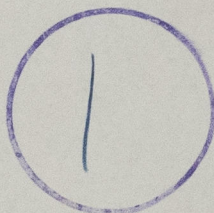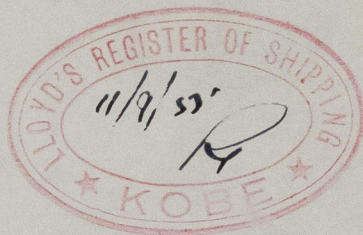

RECORDS DEPT.
LONDON.

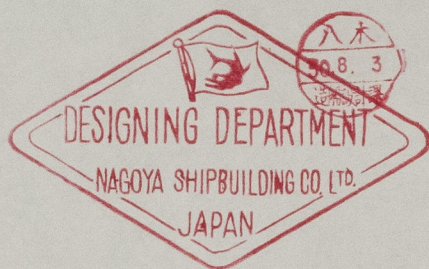

KOBE RPT. NO. 3023

DATED. 2021



Lloyd's Register
Foundation

012898-012906-0179