

S.S. N° 499.




STEEL DECKS. (UNSHEATHED)

DIMENSIONS: 420'-0" x 54'-3" (EXTREME) x 32'-7"

SCALE 1" = 1 FT.



K.G. 4
8.0.
Barclay & Co.
S-12-11

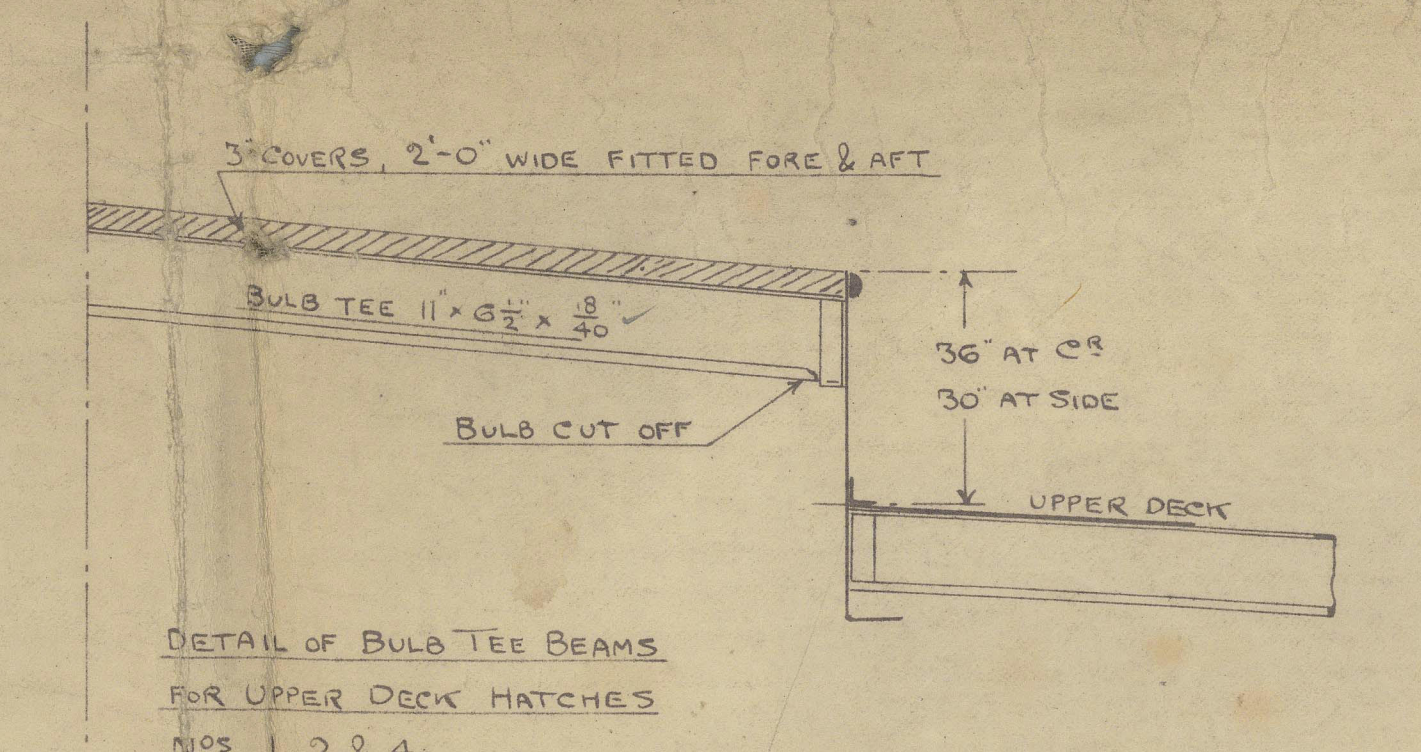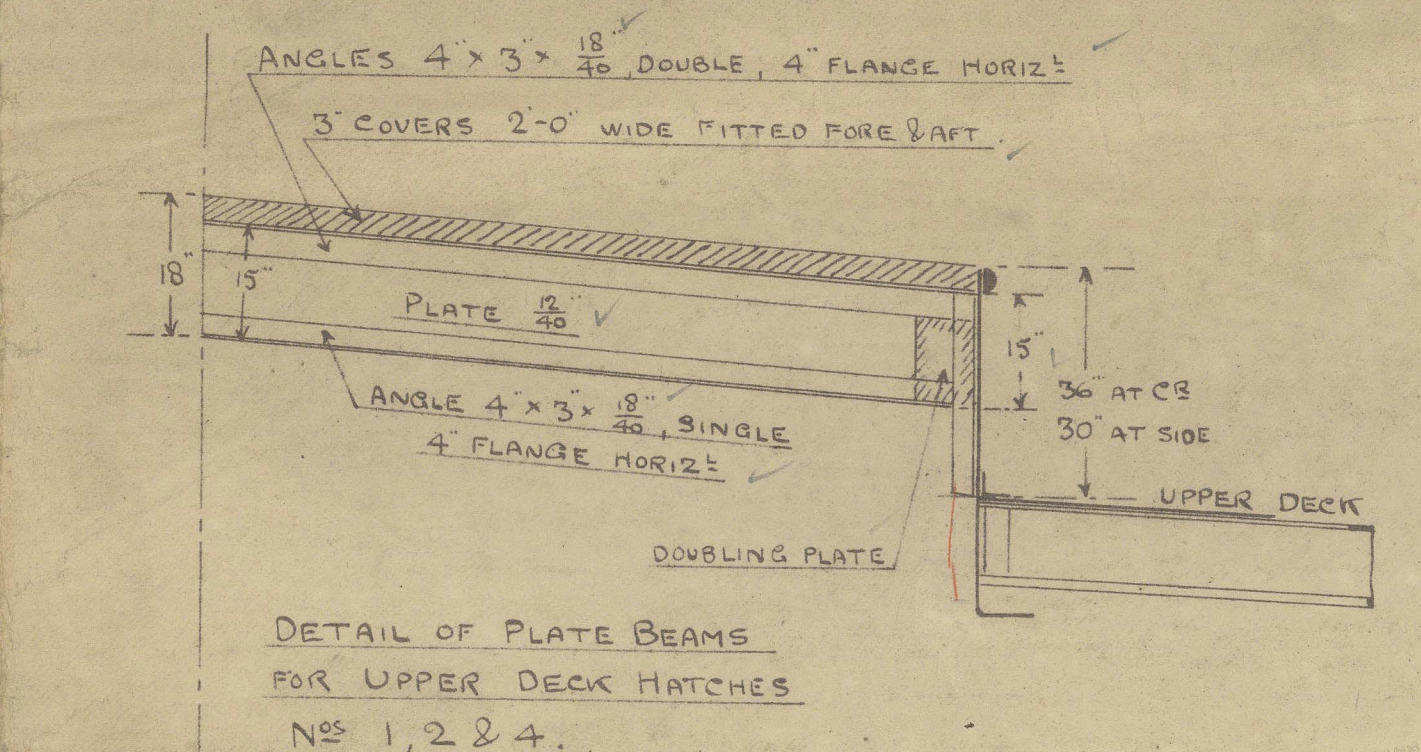 

8 DEC 1911
Approved by
per letter

012907-012924-0080

Barclay Curle & Co

Nº 499

Steel-Deck-Plan

S.S. City of Dunkirk

3

7.5.14



© 2021

Lloyd's Register
Foundation