

NOTE:
 1. BOTH SIDES SYMMETRICAL EXCEPT SPECIAL NOTED.
 2. SIDE REELSON DETAIL SHOWN THE H-3 PLAN.
 3. FILLER DETAIL SHOWN THE H-1 PLAN




Forward portion of ship to be constructed to Japanese satisfaction.

Details of structure on way of structure to be submitted.

K-129,130,131

STERN
CONSTRUCTION

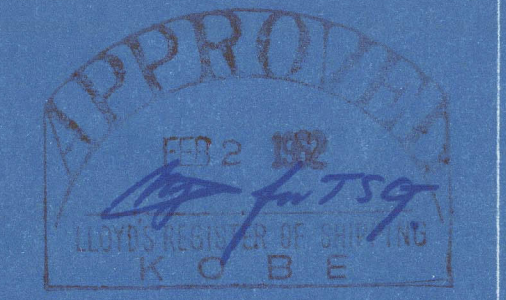

SCALE	1/50
KANAWA DOCK YARD CO. LTD.	HIROSHIMA JAPAN
DESIGNING OFFICE	
YARD SUPER	
CHIEF	
CHECKER	
DRAWER	
TRACER	
DATE	JAN 17, 1962
DWG. NO.	1-1
W. NO.	

FOR APPROVAL	
APPROVED	_____
BY	_____

"ML(S) 813"

"STERN CONSTRUCTION"

TO BE ATTACHED TO REPORT NO FE-10641

FE

RECORDS DEPT
LONDON

6

8



JAN 22 1962

© 2021

Lloyd's Register
Foundation

0124 25-012932-0222