


KOSOH-MARU GENERAL ARRANGEMENT 200

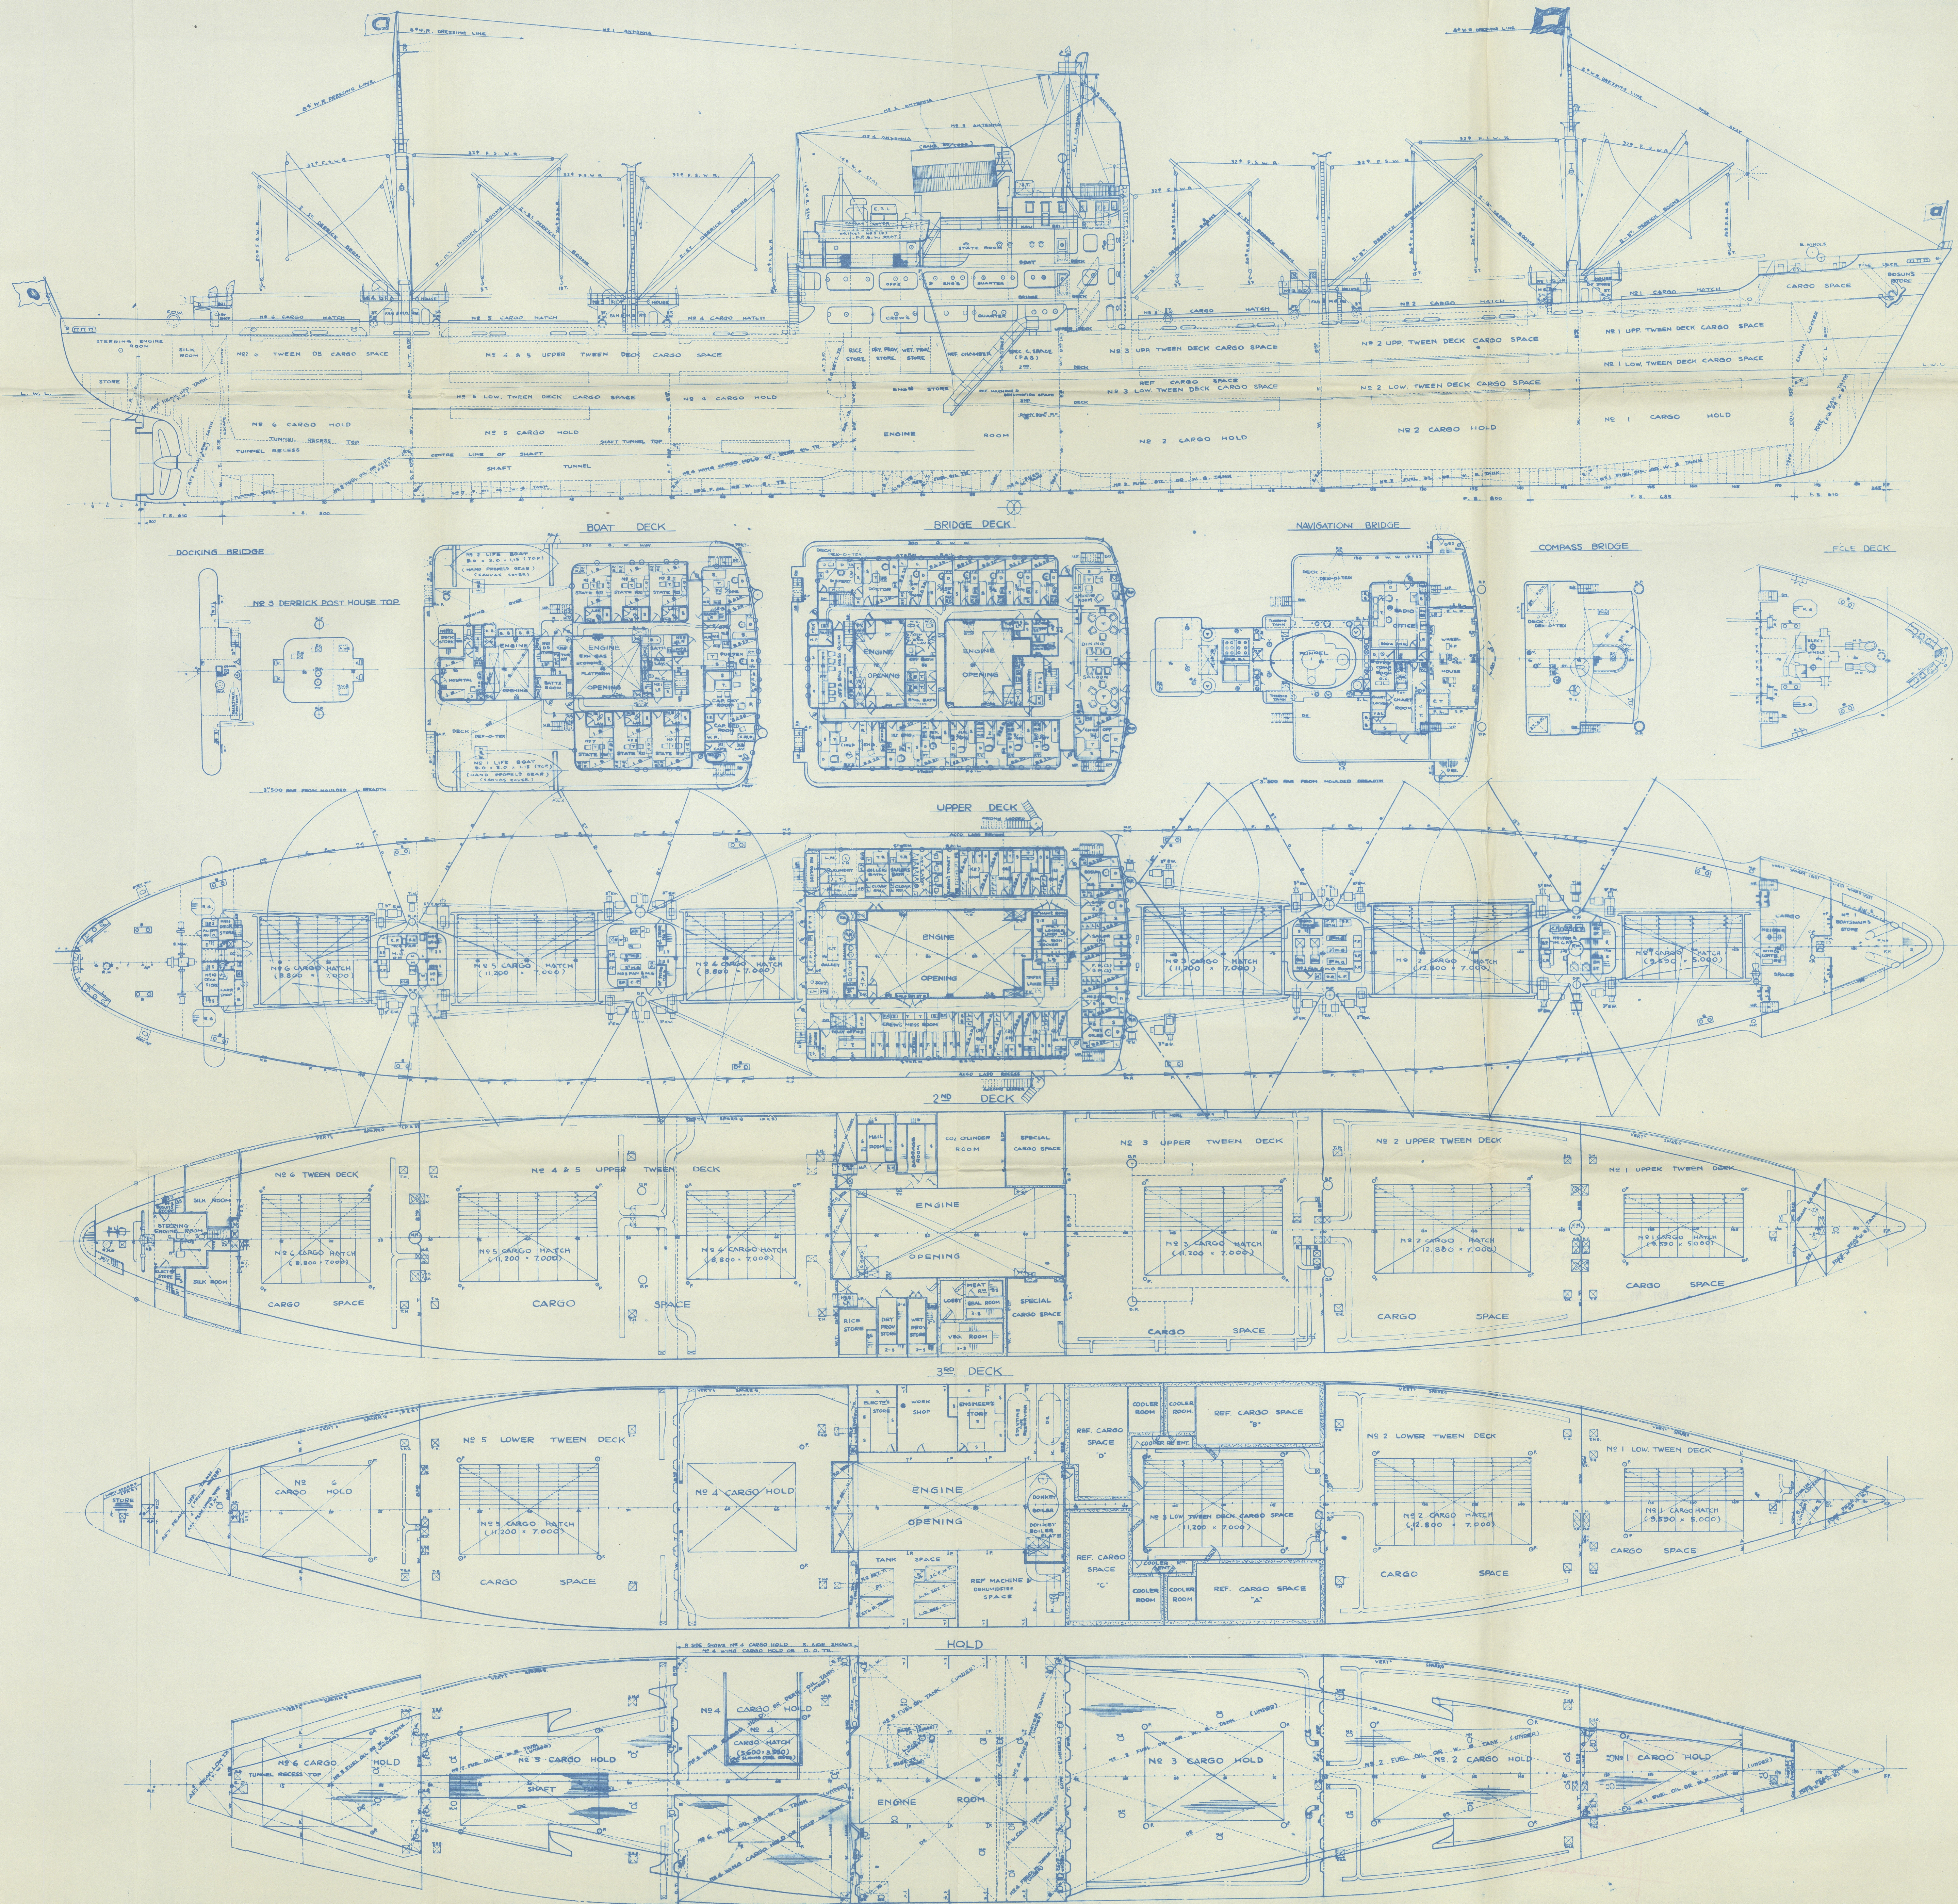

LENGTH (L.P.)	140.000
BREADTH (M ²)	12.400
DEPTH (")	12.200
DRAFT (")	8.773
GROSS TONNAGE	3.204,76
NET	3.340,55
DEAD WEIGHT	11.679,85
MAIN ENGINE	GUEC DIESEL ENGINE 1587
SPEED	16.1 km

UPPER DECK ~	2 ND D ^{SK}	AT CENTER 3100	AT SDES 2850
2 ND	~ 35 TH	2 ND 850	ENG RM SIDE 2 ND 650
UPPER	~ BRIDGE	AT CENTER 2350	AT SIDE 2 ND 600
	~ F ^{IRST}		2300
	~ DOCKING BRIDGE		2300
BRIDGE	~ BOAT DECK		2600
BOAT	~ NAVIGATION BRIDGE		2750
NAV. BRI.	~ COMPASS BRIDGE		2350
UPPER DS	~ DERRICK POST HOUSE TOP		2300

CAPTAIN	1	CHIEF ENG.	1	DOCTOR	1
CHIEF OFF	1	1 st	•	PURSER	1
2 nd	•	2 nd	•	CHIEF OPER	1
3 rd	•	3 rd	•	2	CHIEF
APP	1	APP	1	3 rd	•
				CLERK	1
	5		7		6

BOATSWAIN	1	NO. 1 OILER	1	C. STEWARD	1
CARPENTR	1	ST. KEEPER	1	C/COOK	1
ST. KEEPER	1	NO. 2 OILER	1	C/BOY	1
Q MASTER	4	OILER	2	COOK	3
SAILOR	8	DONKEY MAN	4	BOY	3
	15	FIRE MAN	5		3
			14		

TOTAL NO OF CREW	56	PERSONS
NO OF PASSENGER	12	"
GRAND TOTAL	68	"

DAIDO	KAIUN
KOSOH	MARU

GENERAL ARRANGEMENT

(FINISHED PLAN)

DIMENSION 140.0 x 19.4 x 12.2

SCALE 1:200	CLASS	L. R. N. K.
EQUIPMENT DESIGNING SECTION		
SHIP DESIGNING DEPARTMENT		
NAGASAKI WORKS		

CHIEF OF DEPT. _____
CHIEF _____
HEAD _____
CHECKED _____
DRAWN _____

DATE JUNE 1, 1956 REG NO.
MITSUBISHI ZOSEN KABUSHIKI KAISHA
TOKYO JAPAN

SHIP NO. 1465
DWG NO. W-1 (完)

012933-012939-0037

DAIDO KAIUN
KOSOH MARU

GENERAL ARRANGEMENT

(FINISHED PLAN)

DIMENSION 140'0" x 19'4" x 12'2"

SCALE 1:200 CLASS L. R.
H. K.

EQUIPMENT DESIGNING SECTION
SHIP DESIGNING DEPARTMENT
NAGASAKI WORKS

CHIEF OF DEPT.

CHIEF

HEAD

CHECKED

DRAWN

DATE JUNE 1, 1956 REG NO.

MITSUBISHI ZOSEN KABUSHIKI KAISHA
TOKYO JAPAN

SHIP NO 1465

DWG NO W-1 (完)

LONDON

KOSOH MARU.

SHIMONOSEKI RPT. No. 570

DATED.

RECORDS DEPT.
LONDON



Gen. Arr.



Lloyd's Register
Foundation

012933-012939-0037

012933-012939-0037