

DAIDO KAIUN
KOSOH MARU

CONSTRUCTION PROFILE
AND
DECK PLAN
SHEET I
(FINISHED PLAN)

1400 x 194 x 122

SCALE 1/100 CLASS 42

HULL DESIGNING SECTION
SHIP DESIGNING DEPARTMENT

CHEF OF DEPT. *[Signature]*

CHIEF *[Signature]*

HEAD *[Signature]*

CHECKED *[Signature]*

DRAWN *[Signature]*

DATE *[Signature]*

MITSUBISHI ZOSEN KAWASAKI KAISHA
TOKYO JAPAN

SHIP NO. 1465

DSN NO. H-207a

OR 133-012431-0231

© 2021

Lloyd's Register
Foundation

LONDON.

MK

KOSOH MARU

DAIDO KAIUN

KOSOH MARU *

CONSTRUCTION PROFILE

AND

DECK PLAN

SHEET I

(FINISHED PLAN)

DIMENSION 1400 x 194 x 122

SCALE 1/100 CLASS L.R.
N.K.

HULL DESIGNING SECTION

SHIP DESIGNING DEPARTMENT
NAGASAKI WORKS

CHIEF OF DEPT.

CHIEF

HEAD

CHECKED

DRAWN

DATE

REG NO.

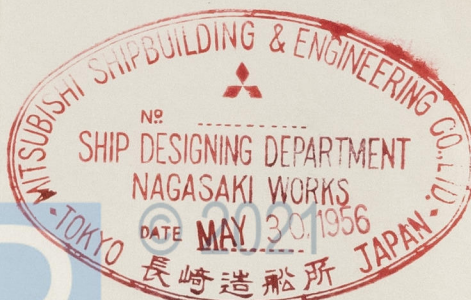
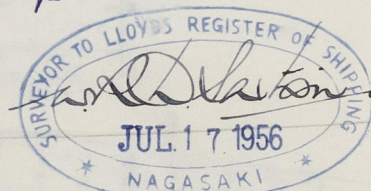
MITSUBISHI ZOSEN KABUSHIKI KAISHA
TOKYO JAPAN

SHIP NO. 1465

DSN NO H-207A

SHIMONOSEKI RPT. NO. 570

DATED.

Certified copy of approved plan
except where indicated in red.constr: Profile & Deck
plansLloyd's Register
Foundation

012933-012939-0039

012933-012939-0039