





DAIDO KAIUN

KOSOH MARU

CONSTRUCTION PROFILE

AND

DECK PLAN

SHEET II

(FINISHED PLAN)

DIMENSION 1400 x 194 x 122

SCALE 1/100 CLASS L.R. N.K.

HULL DESIGNING SECTION  
SHIP DESIGNING DEPARTMENT  
NAGASAKI WORKS

CHIEF OF DEPT.

CHIEF

HEAD

CHECKED

DRAWN

DATE

REG NO.

MITSUBISHI ZOSEN KABUSHIKI KAISHA  
TOKYO JAPAN

SHIP NO. 1465

DSN NO. H-207B

012933-012939-0040

LONDON

KOSOH MARU


SHIMONOSEKI RPT. NO. 570

DATED.


RECORDS DEPT.  
LONDON

4

Certified copy of approved plan  
except where indicated in red.

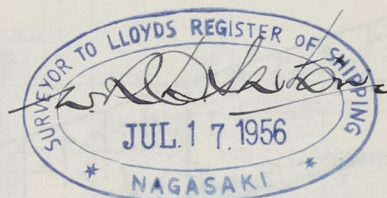

constr. profile & decks

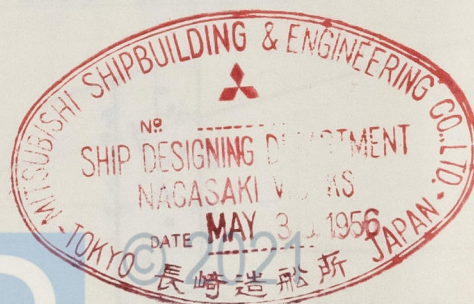

Lloyd's Register  
Foundation

012933-012939-0040