





DAIDO KAIUN

KOSOH MARU

RUDDER

(FINISHED PLAN)

DIMENSION 140'0" x 19'4" x 12'2"

SCALE 1/20 CLASS L.R.

HULL DESIGNING SECTION  
SHIP DESIGNING DEPARTMENT  
NAGASAKI WORKS

CHIEF OF DEPT.

CHIEF

HEAD

CHECKED

DRAWN

DATE

REG NO.

MITSUBISHI ZOSEN KABUSHIKI KAISHA  
TOKYO JAPAN

SHIP NO.

1465

DSN NO.

H-203

LONDON


KOSOH MARU

SHIMONOSEKI RPT. No. 570


DATED

9

Certified copy of approved plan.

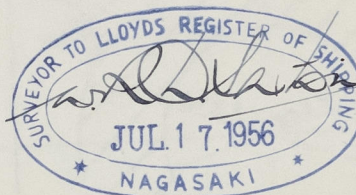

Rudder

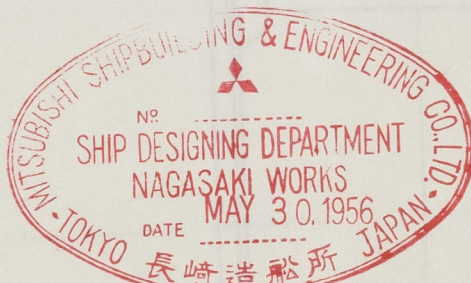

© 2021

Lloyd's Register  
Foundation

012933-012939-0041

012933-012939-0041