

SEA SPEED	16.0 KTS
TOTAL RUDDER AREA	19.3 M ²
C.G. OF RUDDER AREA ABAFT CENTRE	
LINE OF PINTLES	0.72M
C.G. OF RUDDER AREA BELOW	
NECK BEARING TOP	262MM

012933-012939-0042

DAIDO KAIUN

KOSOH MARU

STERN FRAME

(FINISHED PLAN)

DIMENSION 1400 x 194 x 122

SCALE 1/20 1/10

CLASS L.R.
N.K.

HULL DESIGNING SECTION

SHIP DESIGNING DEPARTMENT
NAGASAKI WORKS

CHIEF OF DEPT.

CHIEF

HEAD

CHECKED

DRAWN

DATE

REG NO.

MITSUBISHI ZOSEN KABUSHIKI KAISHA
TOKYO JAPAN

SHIP NO.

1465

DSN NO.

H-202

LONDON


KOSOH MARU

SHIMONOSEKI RPT. NO. 570

DATED

RECORDS DEPT.
LONDON

Certified copy of approved plan.

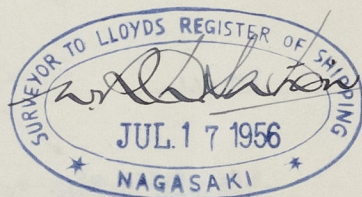

Sternframe



T. Ohabe

Lloyd's Register
Foundation

012933-012939-0042